


04 First Floor Plan
Scale -1:100

LEGEND FOR FIRE FIGHTING		
1.	F.H.C	FIRE HOSE CABINET
2.	B.F.V	BUTTER FLY VALVE
3.	C.V./NRV	CHECK/ NON-RETURN VALVE
4.	△△	2 Nos. CO2 CYLINDER 4.5KG. CAP.
5.	○	ABC CYLINDER CAP. 5.0 KG.
6.	FBC	FIRE BRIGADE CONNECTION

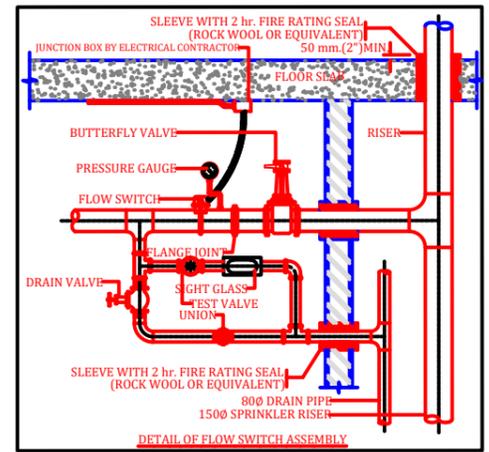

NOTE:
THIS DRAWING IS A COPYRIGHT. IT IS THE PROPERTY OF STUDIO VANRO AND IS NOT TO BE REPRODUCED, COPIED, HANDED OVER TO A THIRD PARTY OR USED FOR ANY PURPOSE OTHER THAN THAT FOR WHICH IT HAS BEEN LOANED.

GENERAL NOTES:
ALL DIMENSIONS INDICATED ARE IN MILLIMETER UNLESS MENTIONED OTHERWISE
ALL DIMENSIONS ARE TO BE CROSS CHECKED AT SITE AND ANY DISCREPANCY SHALL BE BROUGHT TO NOTICE BEFORE EXECUTION.
ALL SERVICE DRAWINGS SHALL BE READ IN CONJUNCTION WITH THIS DRAWING AND OTHER DETAILS.
ANY DISCREPANCIES IN DRAWING MUST BE REPORTED IMMEDIATELY TO PMCI/ARCHITECT FOR FINAL DECISION BEFORE EXECUTION.


S.NO	DATE	DRAWN	CHECKED	VERIFIED	REMARKS
R0	07 12 16	D. PANCHAL	RRM	RRM	TENDER DRAWING

REVISIONS

KEY PLAN


CLIENT	J D Centre of Art	
ARCHITECT	VASTU SHILPA Consultants/ STUDIO VanRO	
STRUCTURAL CONSULTANT	Mahendra Raj Consultants Pvt. Ltd	
MUSEUM DESIGN	Siddhartha Das Studio	
SANITARY, ELECTRICAL, HVAC, FIRE FIGHTING CONSULTANT		
PROJECT	J D Centre of Art, Bhubaneswar	
DRAWING	FIRST FLOOR PLAN (FIRE FIGHTING)	
SCALE	COMPUTER FILE	
DRAWN BY	CHECKED BY	
MAHESH PRAKASH	RIZWAN	
DATE	DRAWING TITLE	
22-04-2024		



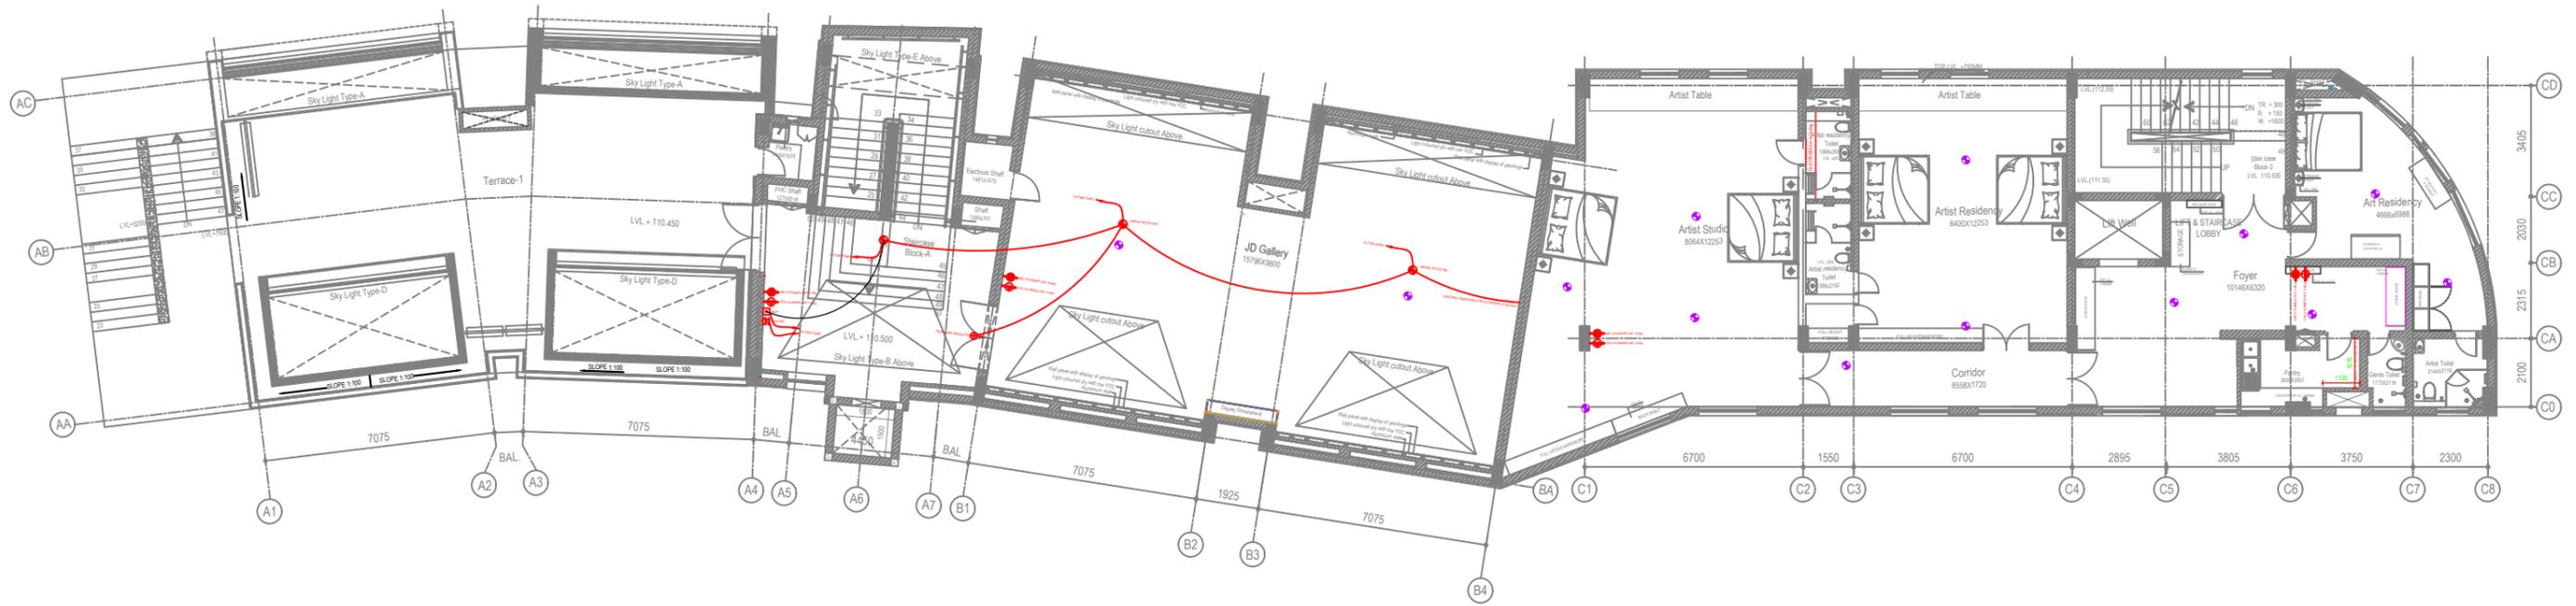

05 Second Floor Plan
Scale -1:100

LEGEND FOR FIRE FIGHTING		
1.	F.H.C	FIRE HOSE CABINET
2.	B.F.V	BUTTER FLY VALVE
3.	C.V./NRV	CHECK/ NON-RETURN VALVE
4.	△△	2 Nos. CO2 CYLINDER 4.5KG. CAP.
5.	○	ABC CYLINDER CAP. 5.0 KG.
6.	FBC	FIRE BRIGADE CONNECTION

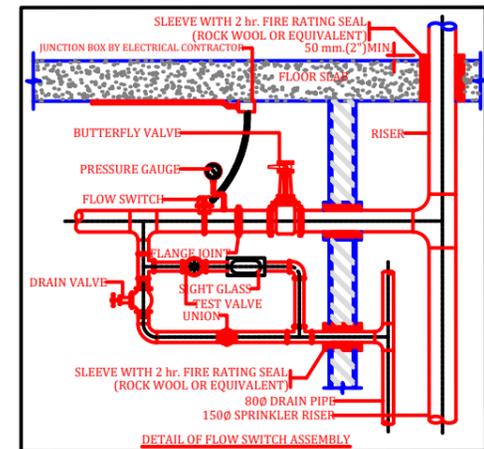

NOTE:
THIS DRAWING IS A COPYRIGHT. IT IS THE PROPERTY OF STUDIO VANRO AND IS NOT TO BE REPRODUCED, COPIED, HANDED OVER TO A THIRD PARTY OR USED FOR ANY PURPOSE OTHER THAN THAT FOR WHICH IT HAS BEEN LOANED.


GENERAL NOTES:
ALL DIMENSIONS INDICATED ARE IN MILLIMETER UNLESS MENTIONED OTHERWISE
ALL DIMENSIONS ARE TO BE CROSS CHECKED AT SITE AND ANY DISCREPANCY SHALL BE BROUGHT TO NOTICE BEFORE EXECUTION.
ALL SERVICE DRAWINGS SHALL BE READ IN CONJUNCTION WITH THIS DRAWING AND OTHER DETAILS.
ANY DISCREPANCIES IN DRAWING MUST BE REPORTED IMMEDIATELY TO PM/ARCHITECT FOR FINAL DECISION BEFORE EXECUTION.

REVISIONS	S.NO	DATE	DRAWN	CHECKED	VERIFIED	REMARKS	
	R0	07 12 16	D. PANCHAL	RRM	RRM	TENDER DRAWING	

KEY PLAN	

CLIENT		PROJECT	
J D Centre of Art		J D Centre of Art, Bhubaneshwar	
ARCHITECT		DRAWING	
VASTU SHILPA Consultants/ STUDIO VanRO		SECOND FLOOR PLAN(FIRE FIGHTING)	
STRUCTURAL CONSULTANT		SCALE	COMPUTER FILE
Mahendra Raj Consultants Pvt. Ltd			
MUSEUM DESIGN		DRAWN BY	CHECKED BY
Siddhartha Das Studio		MAHESH PRAKASH	RIZWAN
SANITARY, ELECTRICAL, HVAC, FIRE FIGHTING CONSULTANT		DATE	DRAWING TITLE
		22-03-2024	



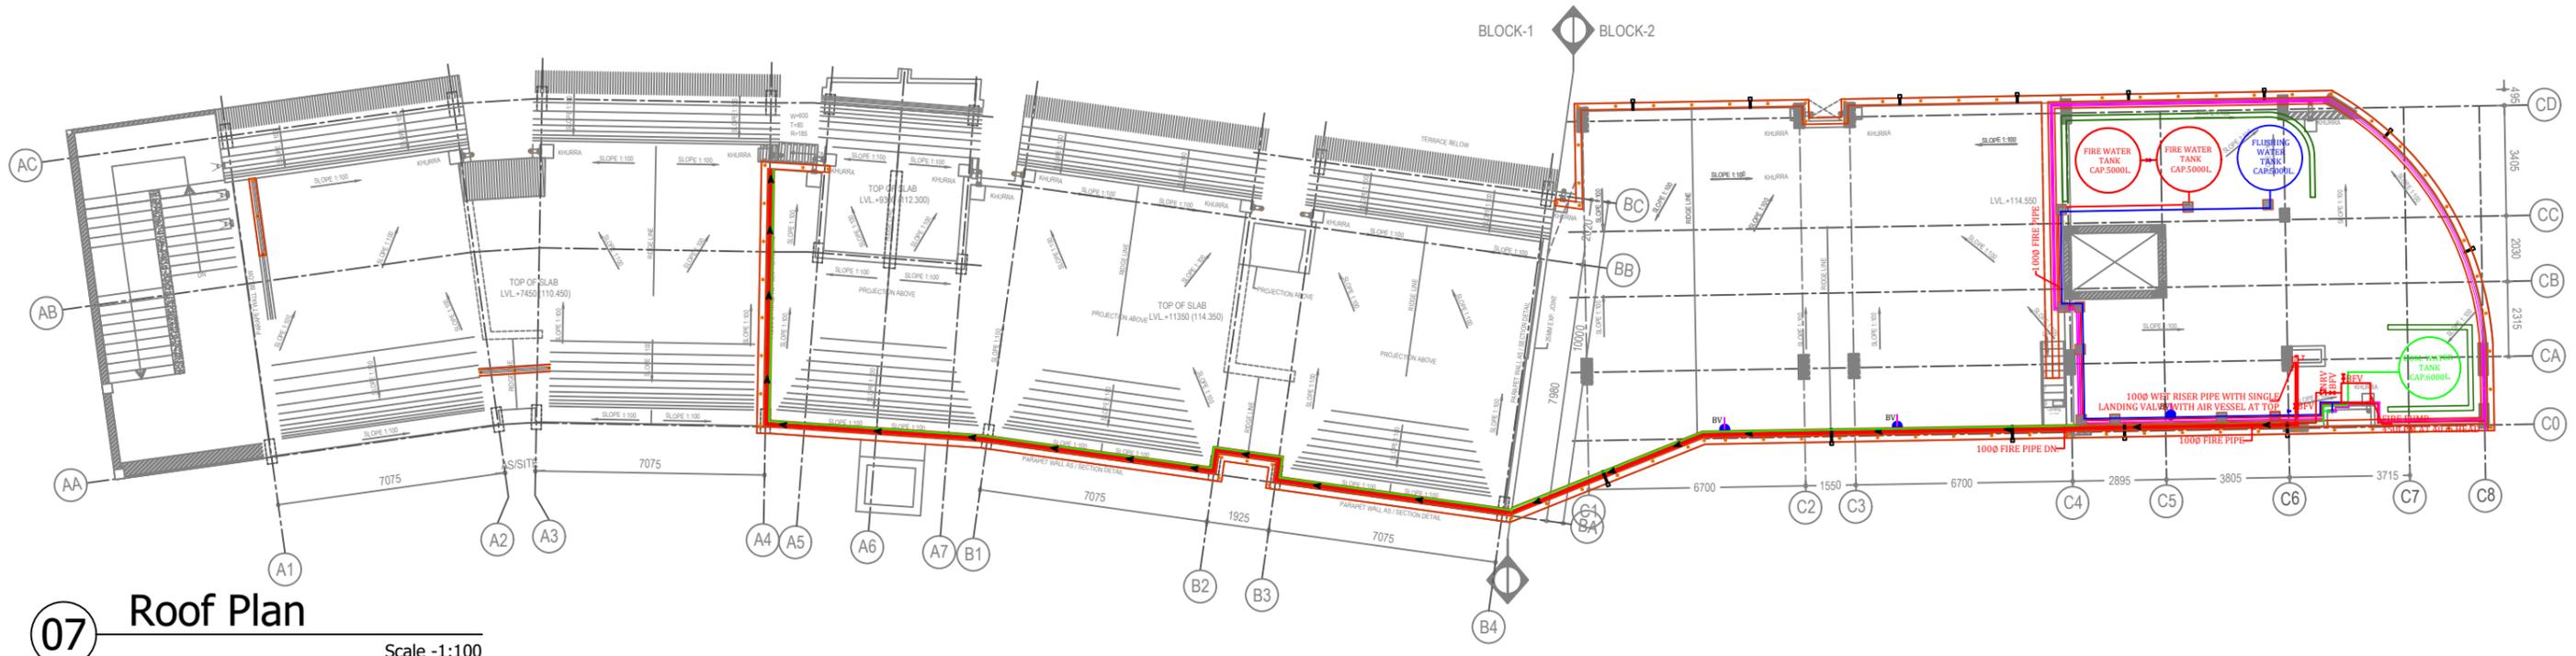

07 Roof Plan
Scale -1:100


NOTE:
THIS DRAWING IS A COPYRIGHT. IT IS THE PROPERTY OF STUDIO VANRO AND IS NOT TO BE REPRODUCED, COPIED, HANDED OVER TO A THIRD PARTY OR USED FOR ANY PURPOSE OTHER THAN THAT FOR WHICH IT HAS BEEN LOANED.

GENERAL NOTES:
ALL DIMENSIONS INDICATED ARE IN MILLIMETER UNLESS MENTIONED OTHERWISE
ALL DIMENSIONS ARE TO BE CROSS CHECKED AT SITE AND ANY DISCREPANCY SHALL BE BROUGHT TO NOTICE BEFORE EXECUTION.
ALL SERVICE DRAWINGS SHALL BE READ IN CONJUNCTION WITH THIS DRAWING AND OTHER DETAILS.
ANY DISCREPANCIES IN DRAWING MUST BE REPORTED IMMEDIATELY TO PMCI/ARCHITECT FOR FINAL DECISION BEFORE EXECUTION.


S.NO	DATE	DRAWN	CHECKED	VERIFIED	REMARKS
R0	07 12 16	D. PANCHAL	RRM	RRM	TENDER DRAWING

REVISIONS	KEY PLAN
-----------	----------

CLIENT J D Centre of Art		PROJECT J D Centre of Art, Bhubaneswar	
ARCHITECT VASTU SHILPA Consultants/ STUDIO VanRO		DRAWING ROOF PLAN	
STRUCTURAL CONSULTANT Mahendra Raj Consultants Pvt. Ltd		SCALE	COMPUTER FILE
MUSEUM DESIGN Siddhartha Das Studio		DRAWN BY MAHESH PRAKASH	CHECKED BY RIZWAN
SANITARY, ELECTRICAL, HVAC, FIRE FIGHTING CONSULTANT		DATE 22-04-2024	DRAWING TITLE

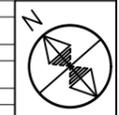

BLOCK-1 BLOCK-2

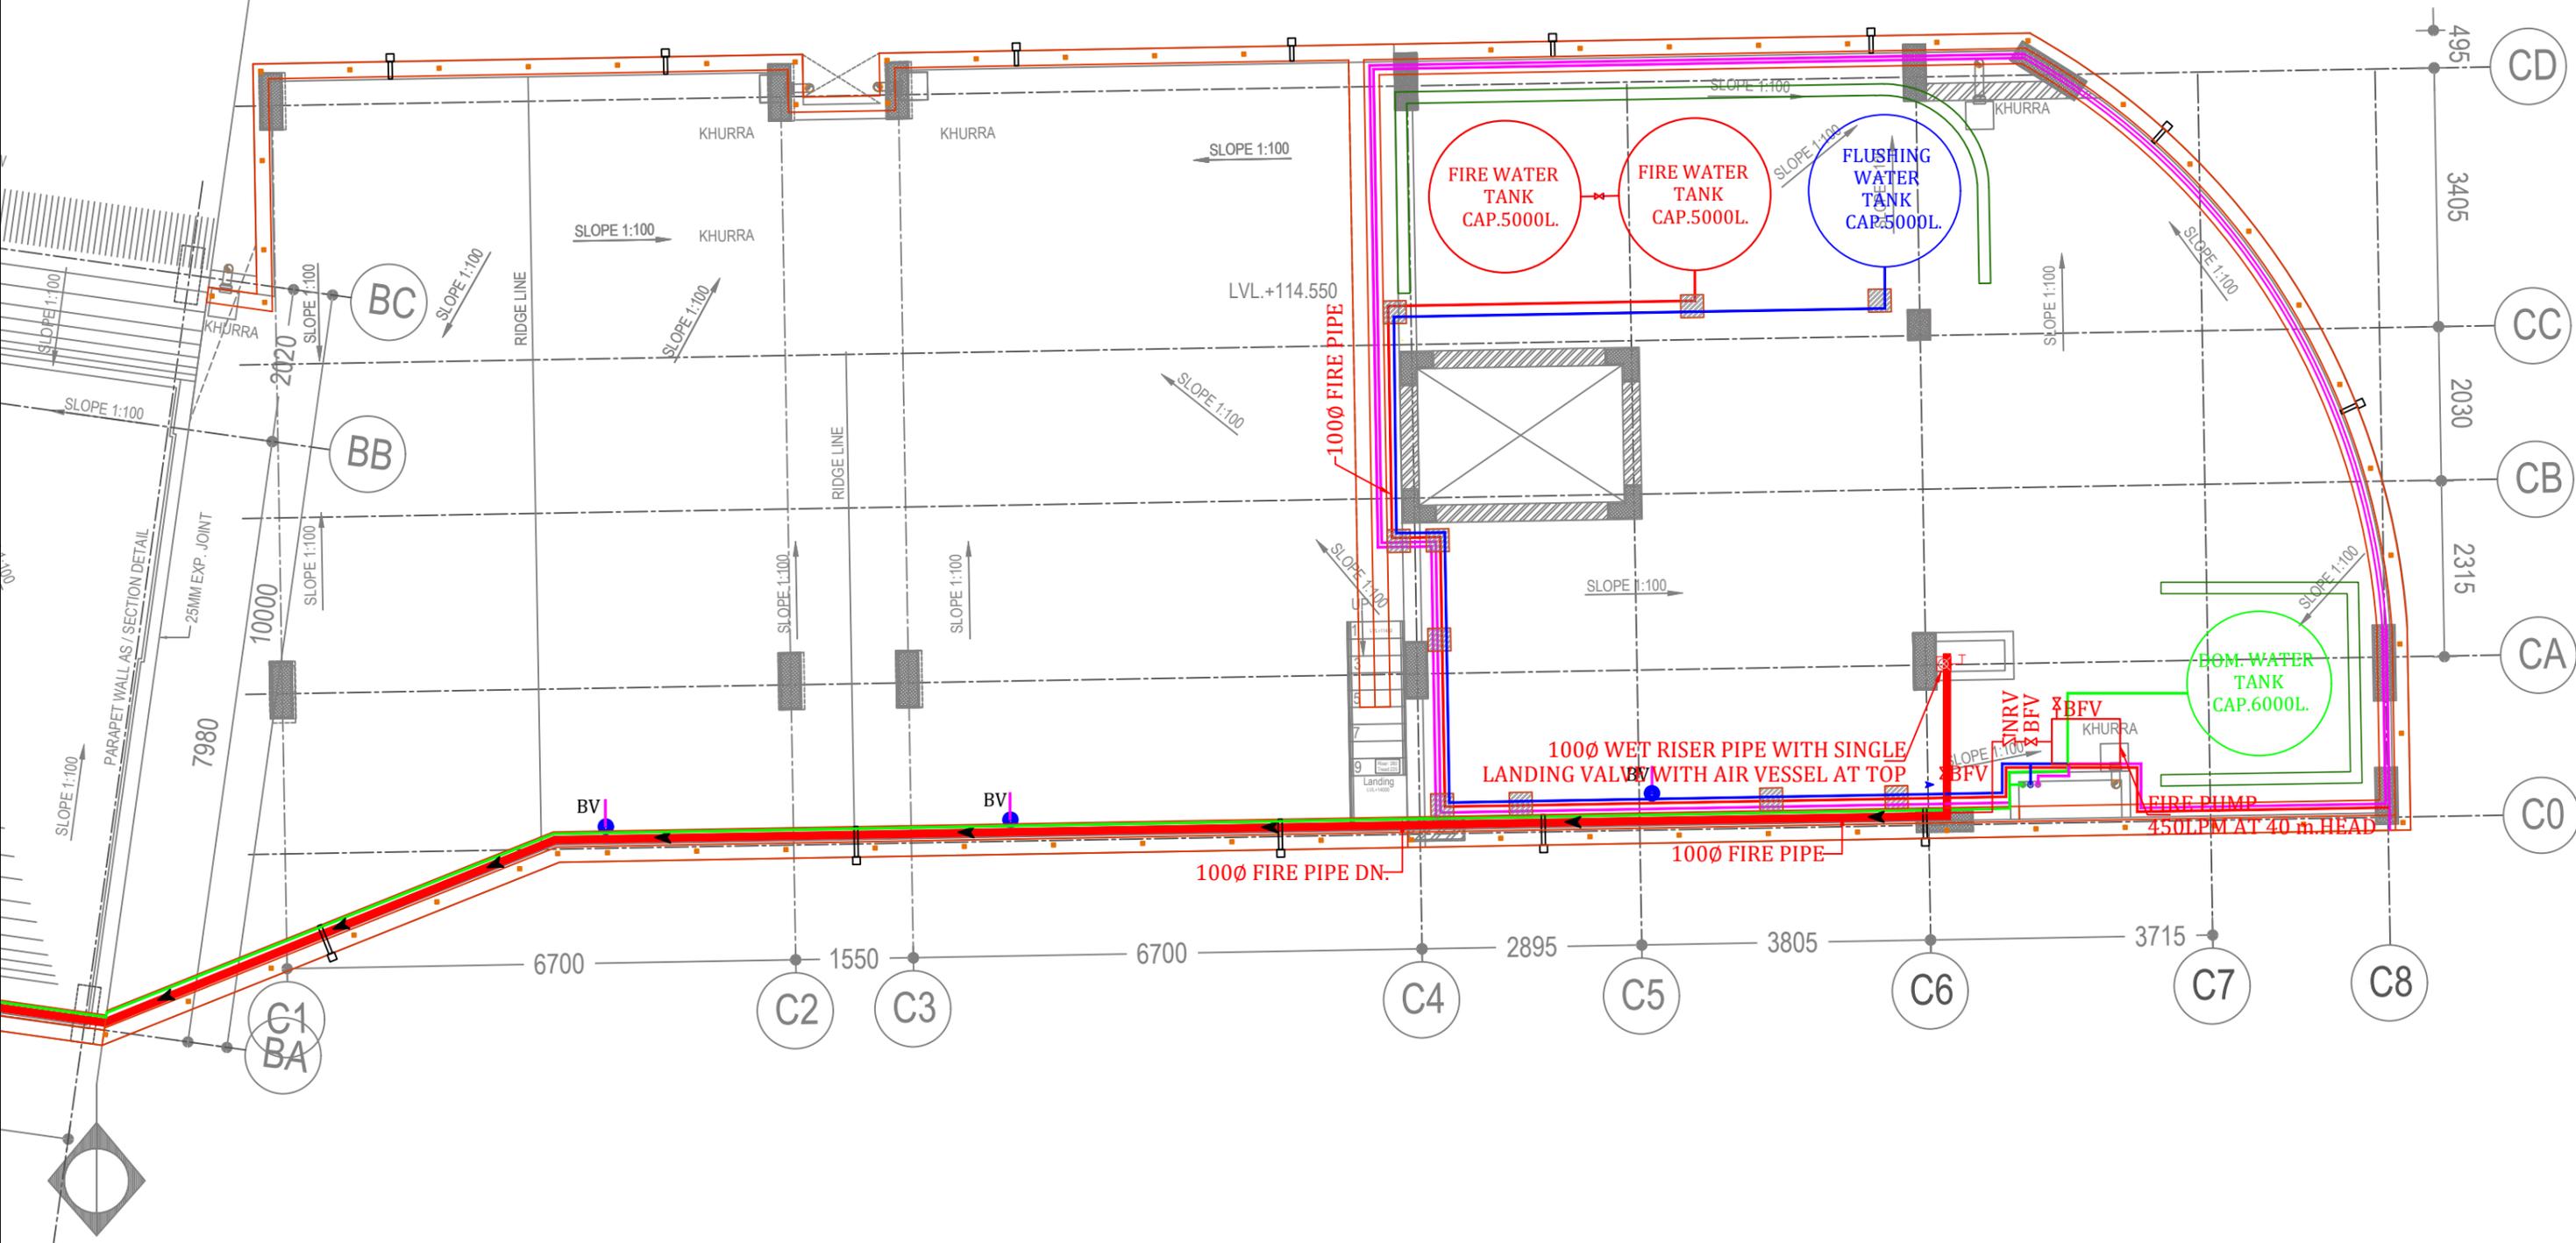

07 Roof Plan Scale -1:100


NOTE:
THIS DRAWING IS A COPYRIGHT. IT IS THE PROPERTY OF STUDIO VANRO AND IS NOT TO BE REPRODUCED, COPIED, HANDED OVER TO A THIRD PARTY OR USED FOR ANY PURPOSE OTHER THAN THAT FOR WHICH IT HAS BEEN LOANED.


GENERAL NOTES:
ALL DIMENSIONS INDICATED ARE IN MILLIMETER UNLESS MENTIONED OTHERWISE
ALL DIMENSIONS ARE TO BE CROSS CHECKED AT SITE AND ANY DISCREPANCY SHALL BE BROUGHT TO NOTICE BEFORE EXECUTION.
ALL SERVICE DRAWINGS SHALL BE READ IN CONJUNCTION WITH THIS DRAWING AND OTHER DETAILS.
ANY DISCREPANCIES IN DRAWING MUST BE REPORTED IMMEDIATELY TO PMC/ARCHITECT FOR FINAL DECISION BEFORE EXECUTION.

S.NO	DATE	DRAWN	CHECKED	VERIFIED	REMARKS
R0	07-12-16	D. PANCHAL	RRM	RRM	TENDER DRAWING


KEY PLAN

CLIENT J D Centre of Art		PROJECT J D Centre of Art, Bhubaneswar	
ARCHITECT VASTU SHILPA Consultants/ STUDIO VanRO		DRAWING ROOF PLAN	
STRUCTURAL CONSULTANT Mahendra Raj Consultants Pvt. Ltd	SCALE	COMPUTER FILE	
MUSEUM DESIGN Siddhartha Das Studio	DRAWN BY MAHESH PRAKASH	CHECKED BY RIZWAN	
SANITARY, ELECTRICAL, HVAC, FIRE FIGHTING CONSULTANT	DATE 22-04-2024	DRAWING TITLE	

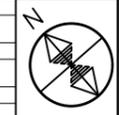


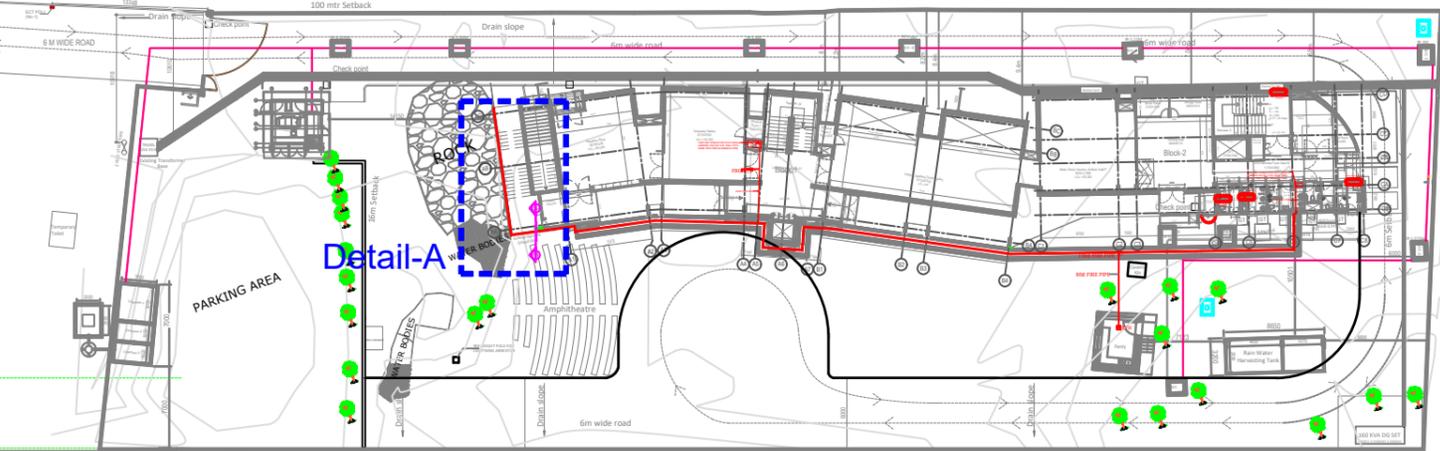


Site Plan

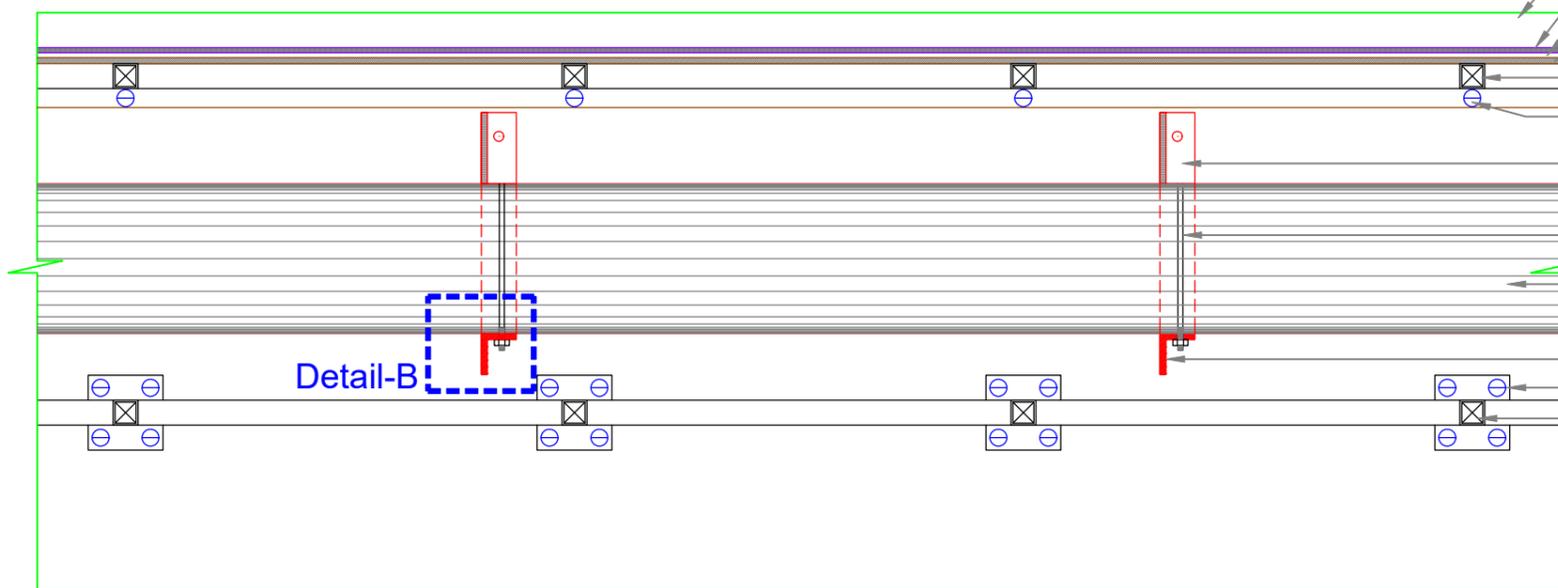


Elevation

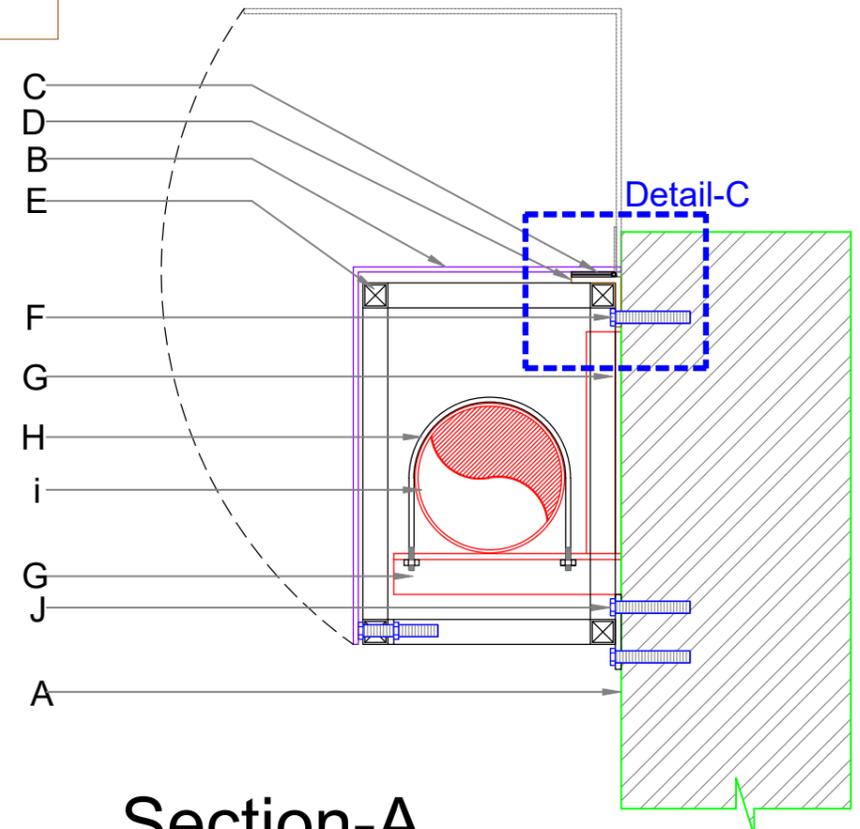


Section-A

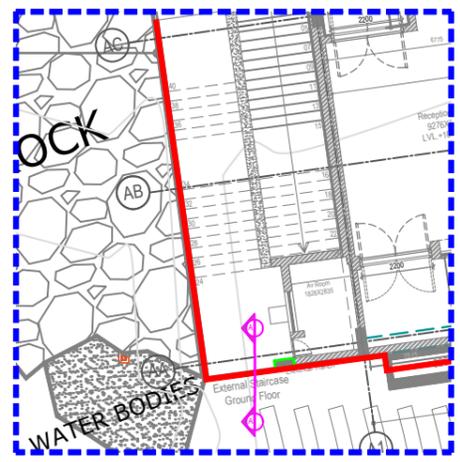

Detail-A

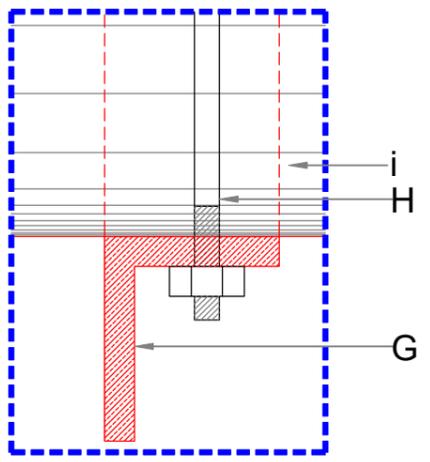

Detail-B

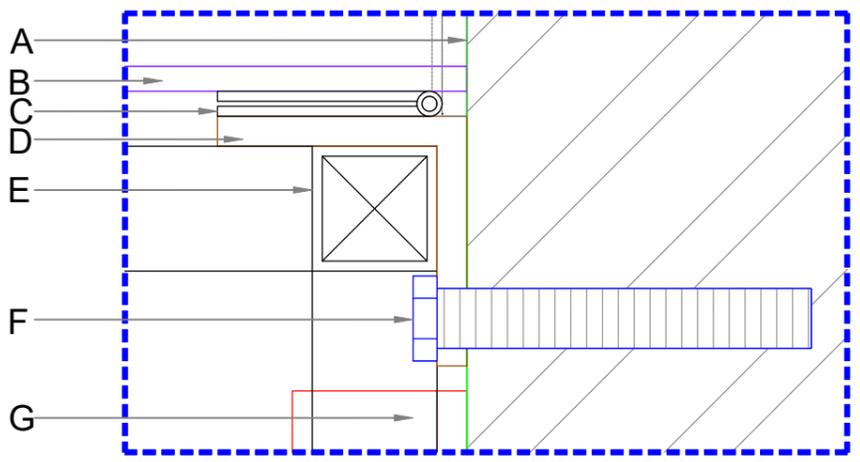


Detail-C

- A- Wall
- B- Fancing
- C- Hing
- D- 25x25 MM L Angle
- E- 25x25 MM MS Frame
- F- Fastener
- G- 35x35 MM Angle for Holding Fire Pipe
- H- Fire Pipe Clamp
- i - Fire Pipe
- J- MS Plat

NOTE:
THIS DRAWING IS A COPYRIGHT. IT IS THE PROPERTY OF STUDIO VANRO AND IS NOT TO BE REPRODUCED, COPIED, HANDED OVER TO A THIRD PARTY OR USED FOR ANY PURPOSE OTHER THAN THAT FOR WHICH IT HAS BEEN LOANED.


GENERAL NOTES:
ALL DIMENSIONS INDICATED ARE IN MILLIMETER UNLESS MENTIONED OTHERWISE
ALL DIMENSIONS ARE TO BE CROSS CHECKED AT SITE AND ANY DISCREPANCY SHALL BE BROUGHT TO NOTICE BEFORE EXECUTION.
ALL SERVICE DRAWINGS SHALL BE READ IN CONJUNCTION WITH THIS DRAWING AND OTHER DETAILS.
ANY DISCREPANCIES IN DRAWING MUST BE REPORTED IMMEDIATELY TO PM/ARCHITECT FOR FINAL DECISION BEFORE EXECUTION.

S.NO	DATE	DRAWN	CHECKED	VERIFIED	REMARKS

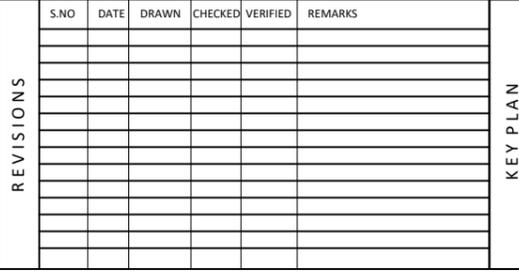

CLIENT	J D Centre of Art	PROJECT	J D Centre of Art, Bhubaneswar
ARCHITECT	VASTU SHILPA Consultants/ STUDIO VanRO	DRAWING	SITE PLAN -FIRE PIPE DETAIL
STRUCTURAL CONSULTANT	Mahendra Raj Consultants Pvt. Ltd	SCALE	COMPUTER FILE
MUSEUM DESIGN	Siddhartha Das Studio	DRAWN BY	CHECKED BY
SANITARY, ELECTRICAL, HVAC, FIRE FIGHTING CONSULTANT		DATE	03-02-2025

MAHESH PRAKASH	VIVEK NAMDEV	
DATE	DRAWING TITLE	

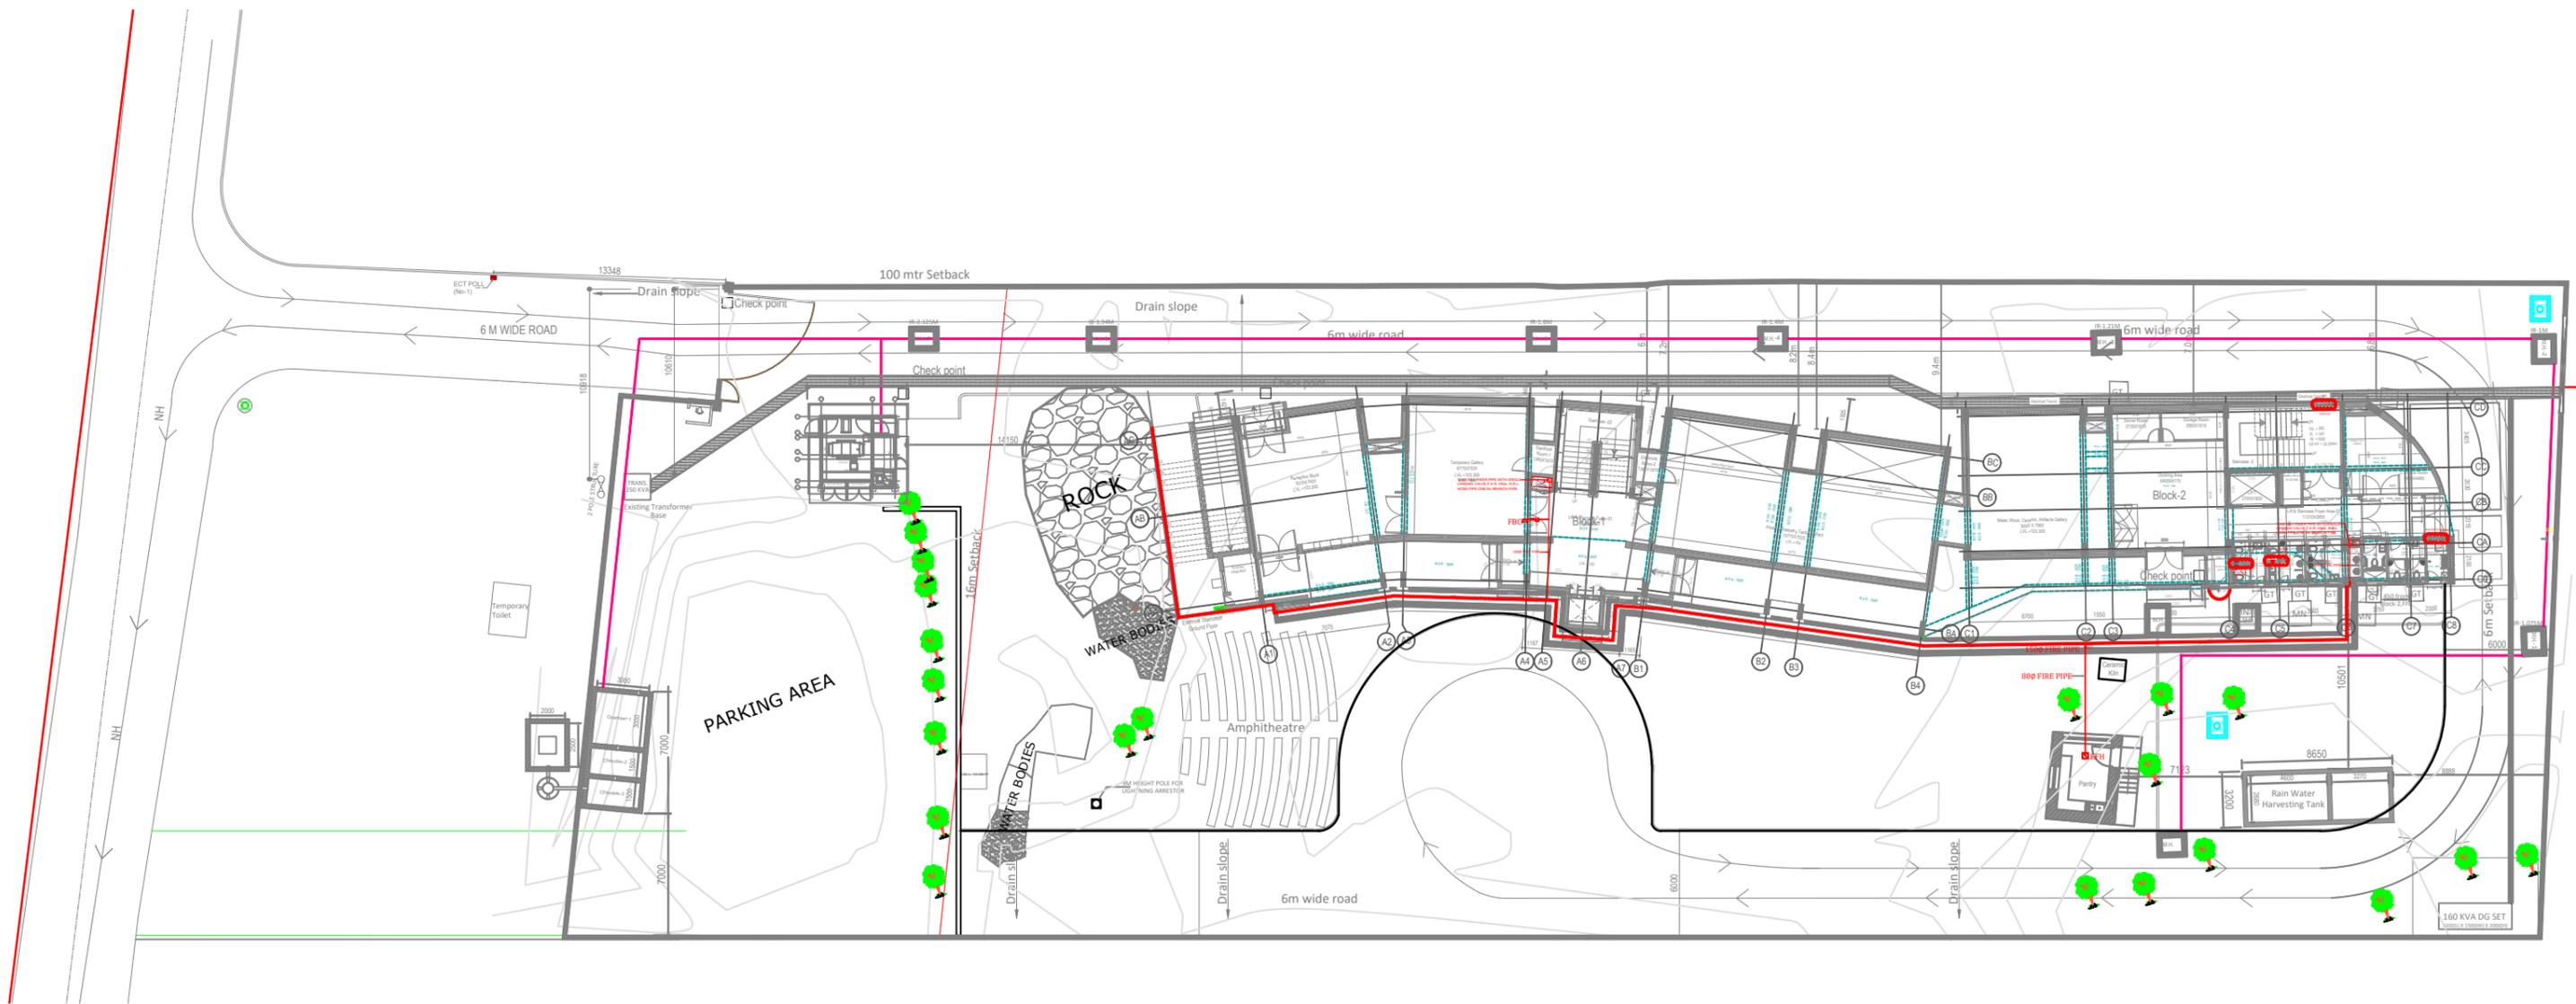


1 SITE PLAN
SCALE - NTS

NOTE:
THIS DRAWING IS A COPYRIGHT. IT IS THE PROPERTY OF STUDIO VANRO AND IS NOT TO BE REPRODUCED, COPIED, HANDED OVER TO A THIRD PARTY OR USED FOR ANY PURPOSE OTHER THAN THAT FOR WHICH IT HAS BEEN LOANED.

GENERAL NOTES:
ALL DIMENSIONS INDICATED ARE IN MILLIMETER UNLESS MENTIONED OTHERWISE
ALL DIMENSIONS ARE TO BE CROSS CHECKED AT SITE AND ANY DISCREPANCY SHALL BE BROUGHT TO NOTICE BEFORE EXECUTION.
ALL SERVICE DRAWINGS SHALL BE READ IN CONJUNCTION WITH THIS DRAWING AND OTHER DETAILS.
ANY DISCREPANCIES IN DRAWING MUST BE REPORTED IMMEDIATELY TO PMCI/ARCHITECT FOR FINAL DECISION BEFORE EXECUTION.

S.NO	DATE	DRAWN	CHECKED	VERIFIED	REMARKS
R0	07 12 16	D. PANCHAL	RRM	RRM	TENDER DRAWING

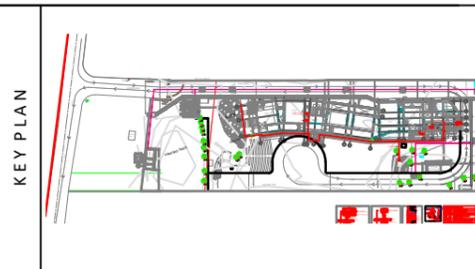


CLIENT J D Centre of Art	PROJECT J D Centre of Art, Bhubaneswar
ARCHITECT VASTU SHILPA Consultants/ STUDIO VanRO	DRAWING SITE PLAN
STRUCTURAL CONSULTANT Mahendra Raj Consultants Pvt. Ltd	SCALE COMPUTER FILE
MUSEUM DESIGN Siddhartha Das Studio	DRAWN BY MAHESH PRAKASH
SANITARY, ELECTRICAL, HVAC, FIRE FIGHTING CONSULTANT	CHECKED BY VIVEK NAMDEV
	DATE 24-07-2023
	DRAWING TITLE




Fire Fighting


As Built

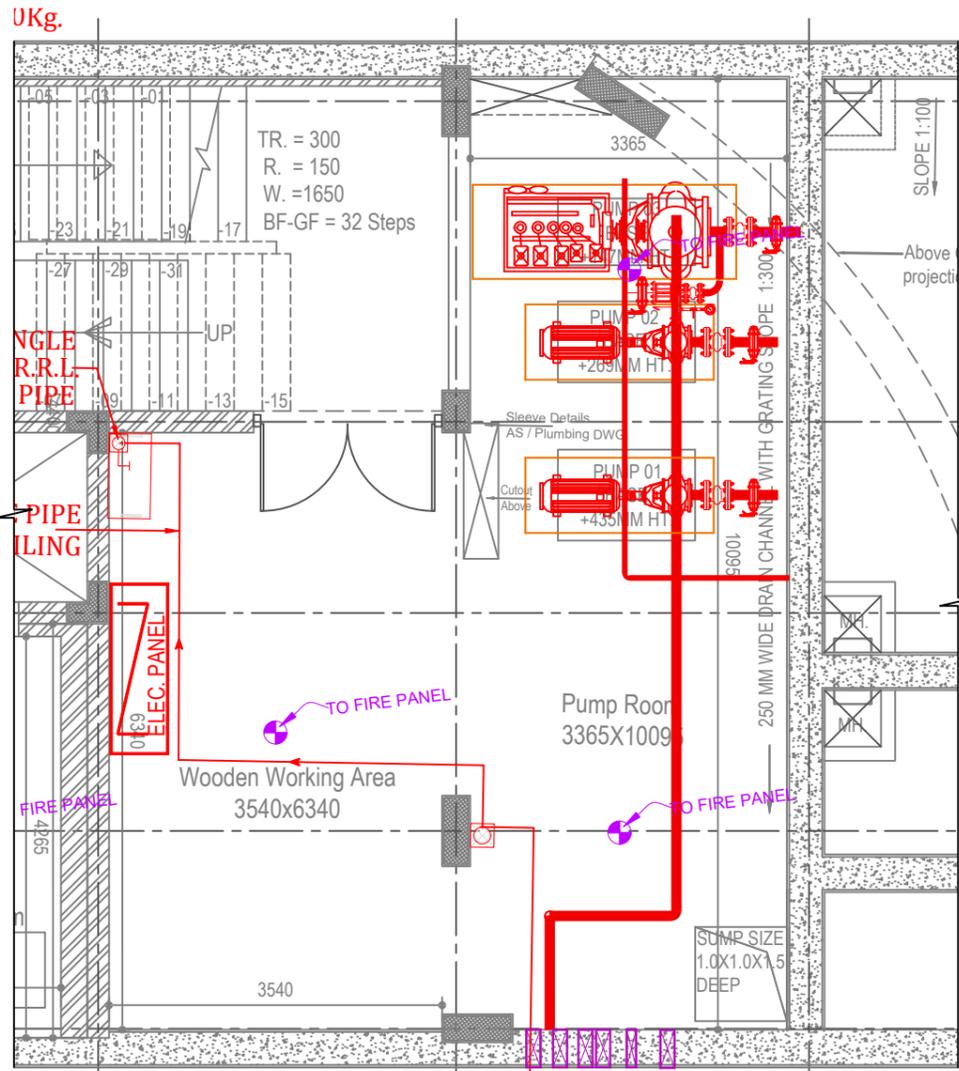


01 Wooden Working Area / Pump Area
Basement Plan
Scale -1:75

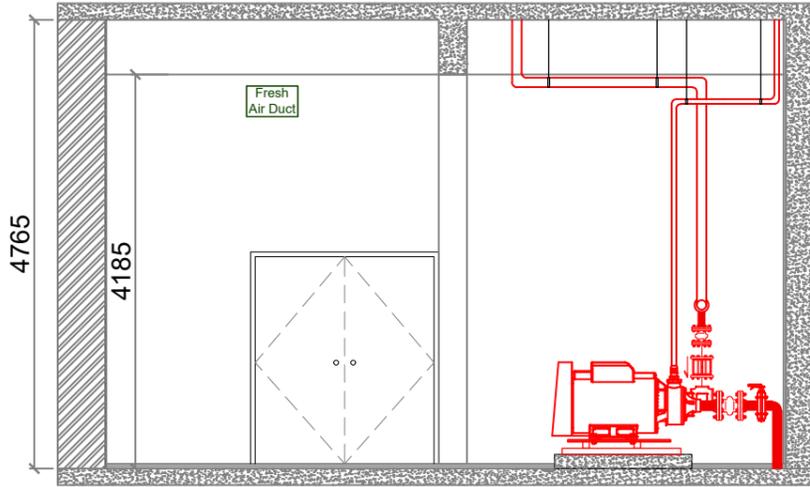


02 Sectional Elevation-A
Scale -1:75

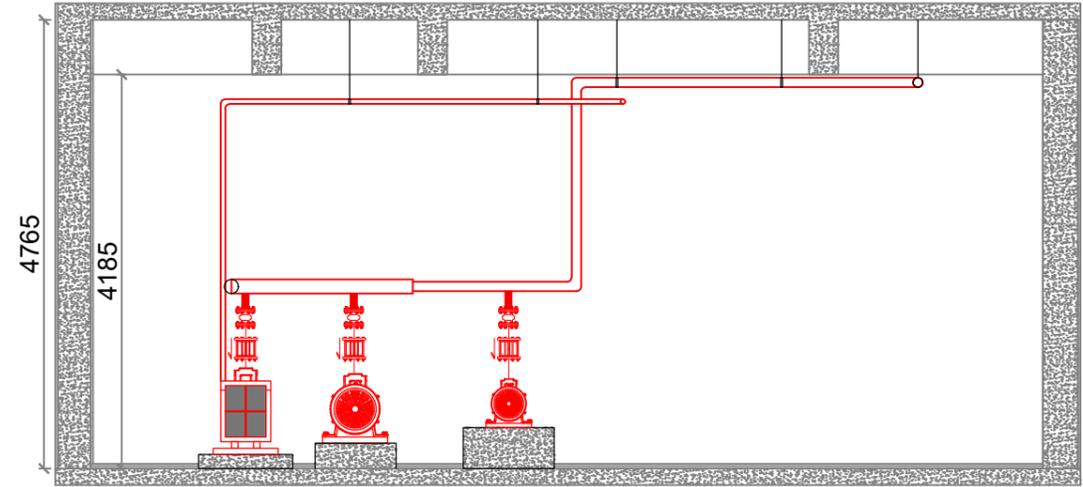

03 Sectional Elevation-B
Scale -1:75

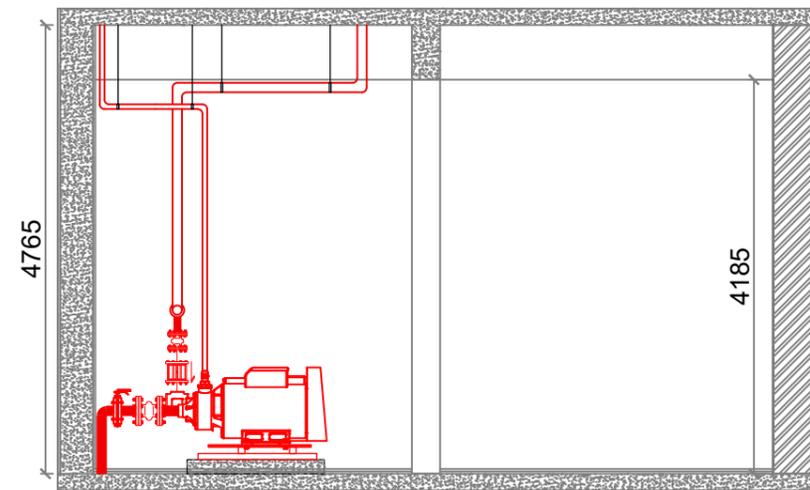

04 Sectional Elevation-C
Scale -1:75

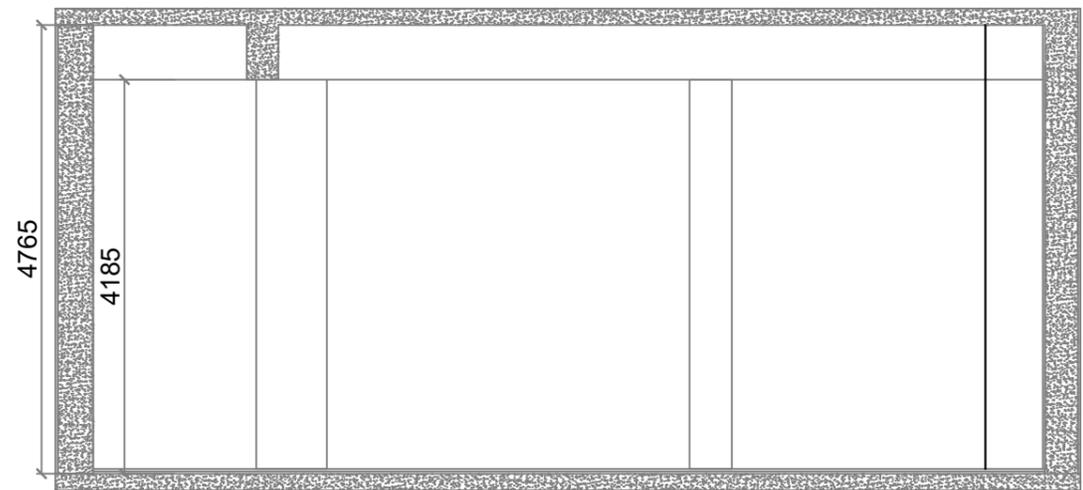


05 Sectional Elevation-D
Scale -1:75


NOTE:
THIS DRAWING IS A COPYRIGHT. IT IS THE PROPERTY OF STUDIO VANRO AND IS NOT TO BE REPRODUCED, COPIED, HANDED OVER TO A THIRD PARTY OR USED FOR ANY PURPOSE OTHER THAN THAT FOR WHICH IT HAS BEEN LOANED.





GENERAL NOTES:
ALL DIMENSIONS INDICATED ARE IN MILLIMETER UNLESS MENTIONED OTHERWISE
ALL DIMENSIONS ARE TO BE CROSS CHECKED AT SITE AND ANY DISCREPANCY SHALL BE BROUGHT TO NOTICE BEFORE EXECUTION.
ALL SERVICE DRAWINGS SHALL BE READ IN CONJUNCTION WITH THIS DRAWING AND OTHER DETAILS.
ANY DISCREPANCIES IN DRAWING MUST BE REPORTED IMMEDIATELY TO PMCI/ARCHITECT FOR FINAL DECISION BEFORE EXECUTION.

S.NO	DATE	DRAWN	CHECKED	VERIFIED	REMARKS

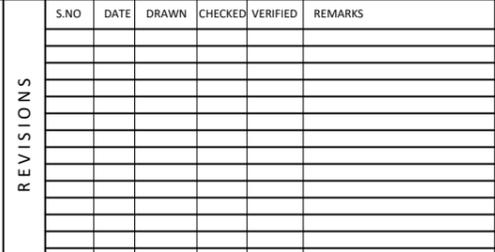

CLIENT	J D Centre of Art	PROJECT	J D Centre of Art, Bhubaneswar
ARCHITECT	VASTU SHILPA Consultants/ STUDIO VanRO	DRAWING	BASEMENT PLAN (FIRE FIGHTING)
STRUCTURAL CONSULTANT	Mahendra Raj Consultants Pvt. Ltd	SCALE	A3@1:75
MUSEUM DESIGN	Siddhartha Das Studio	COMPUTER FILE	01:JICA_Basement Floor_Fire Safety_20250509.MPJ
SANITARY, ELECTRICAL, HVAC, FIRE FIGHTING CONSULTANT		DRAWN BY	MAHESH PRAKASH
		CHECKED BY	VIVEK NAMDEV
		DATE	09-05-2025
		DRAWING TITLE	

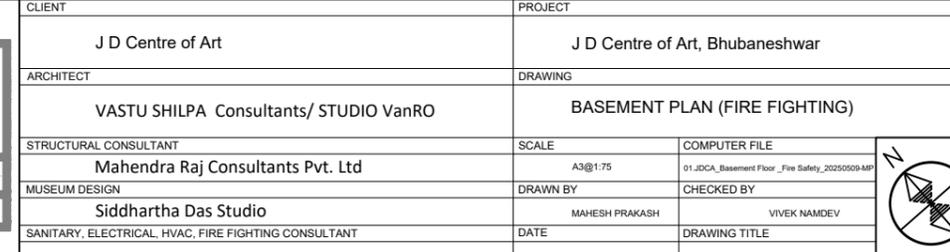

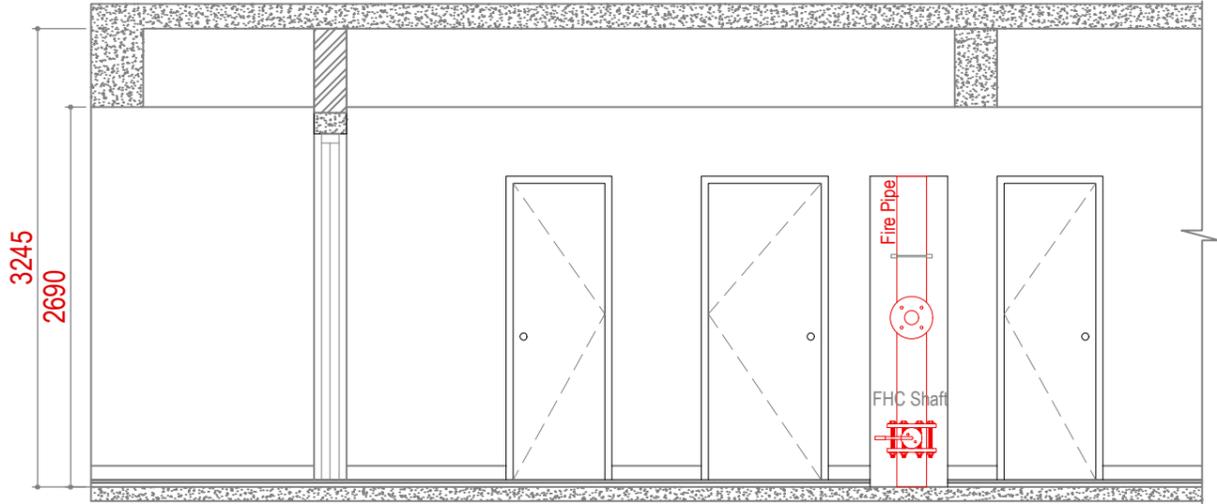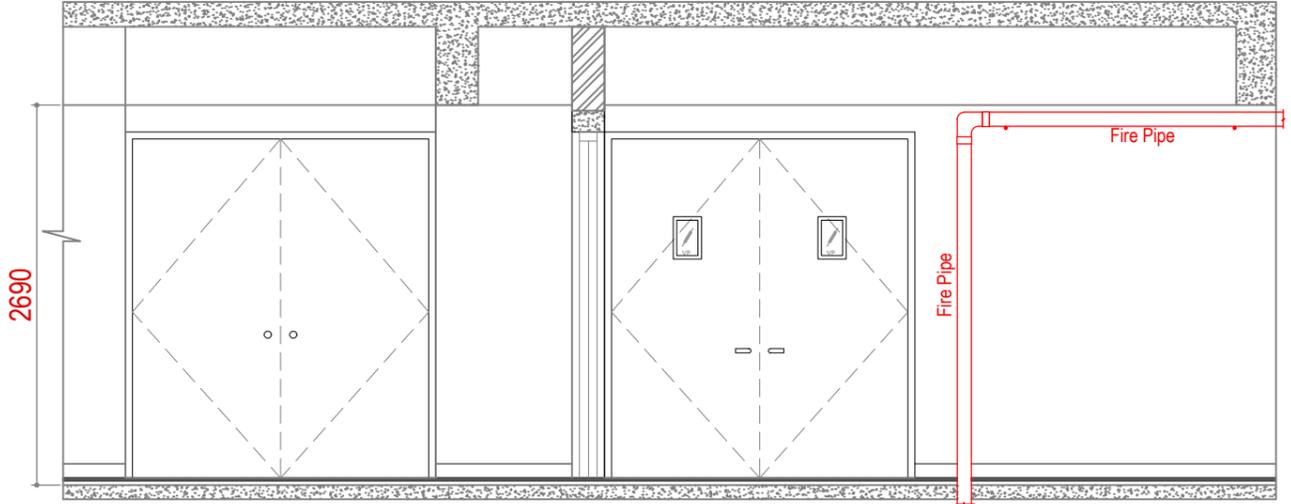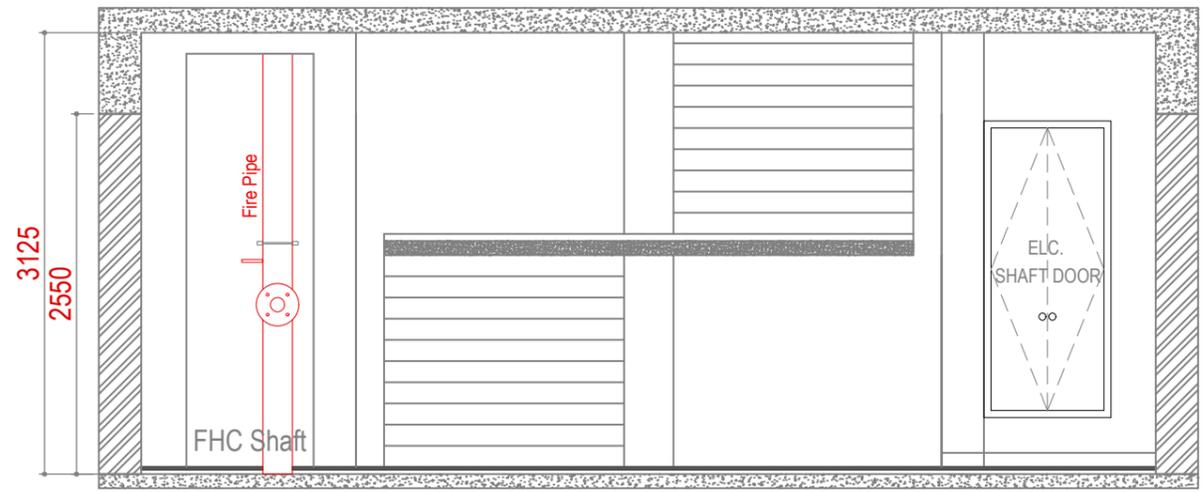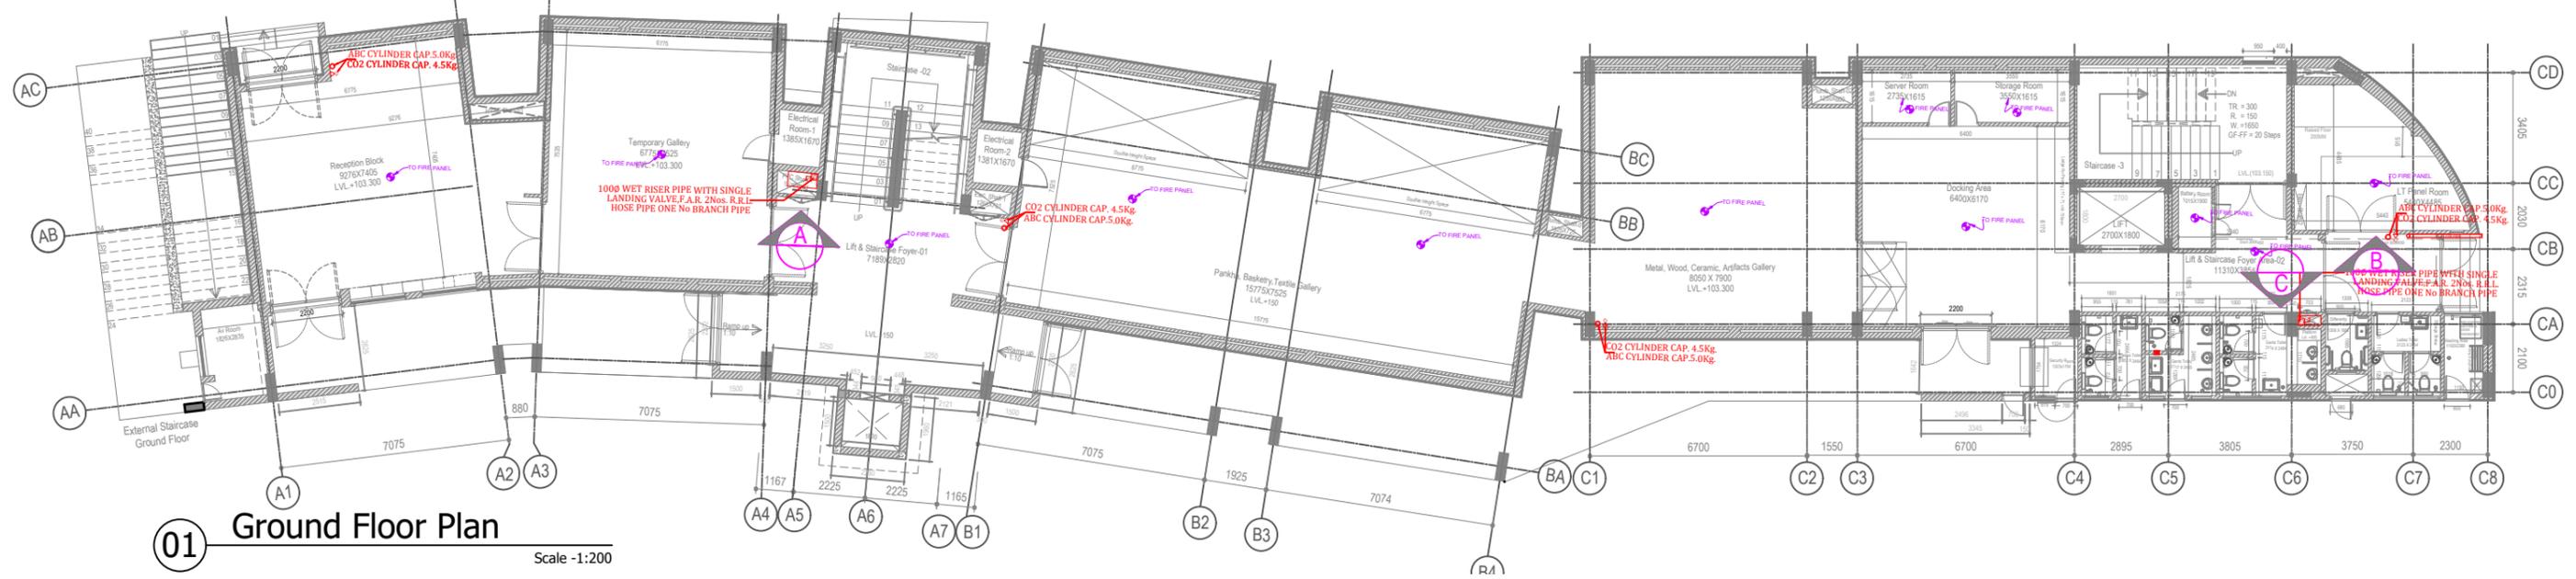


NOTE:
THIS DRAWING IS A COPYRIGHT. IT IS THE PROPERTY OF STUDIO VANRO AND IS NOT TO BE REPRODUCED, COPIED, HANDED OVER TO A THIRD PARTY OR USED FOR ANY PURPOSE OTHER THAN THAT FOR WHICH IT HAS BEEN LOANED.

GENERAL NOTES:
ALL DIMENSIONS INDICATED ARE IN MILLIMETER UNLESS MENTIONED OTHERWISE
ALL DIMENSIONS ARE TO BE CROSS CHECKED AT SITE AND ANY DISCREPANCY SHALL BE BROUGHT TO NOTICE BEFORE EXECUTION.
ALL SERVICE DRAWINGS SHALL BE READ IN CONJUNCTION WITH THIS DRAWING AND OTHER DETAILS.
ANY DISCREPANCIES IN DRAWING MUST BE REPORTED IMMEDIATELY TO PM/ARCHITECT FOR FINAL DECISION BEFORE EXECUTION.


S.NO	DATE	DRAWN	CHECKED	VERIFIED	REMARKS

S.NO	DATE	DRAWN	CHECKED	VERIFIED	REMARKS

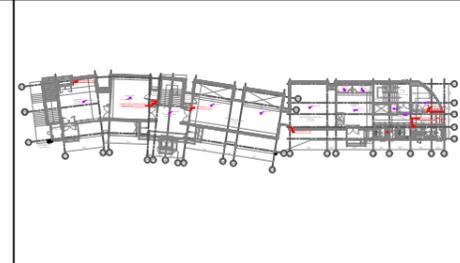


CLIENT J D Centre of Art		PROJECT J D Centre of Art, Bhubaneswar	
ARCHITECT VASTU SHILPA Consultants/ STUDIO VanRO		DRAWING GROUND FLOOR PLAN (FIRE FIGHTING)	
STRUCTURAL CONSULTANT Mahendra Raj Consultants Pvt. Ltd		SCALE A3@1:200, 1:50	COMPUTER FILE 01.JDCA_Ground Floor_Fire Safety_20250509.MP
MUSEUM DESIGN Siddhartha Das Studio		DRAWN BY MAHESH PRAKASH	CHECKED BY VIVEK NAMDEV
SANITARY, ELECTRICAL, HVAC, FIRE FIGHTING CONSULTANT		DATE 09-05-2025	DRAWING TITLE




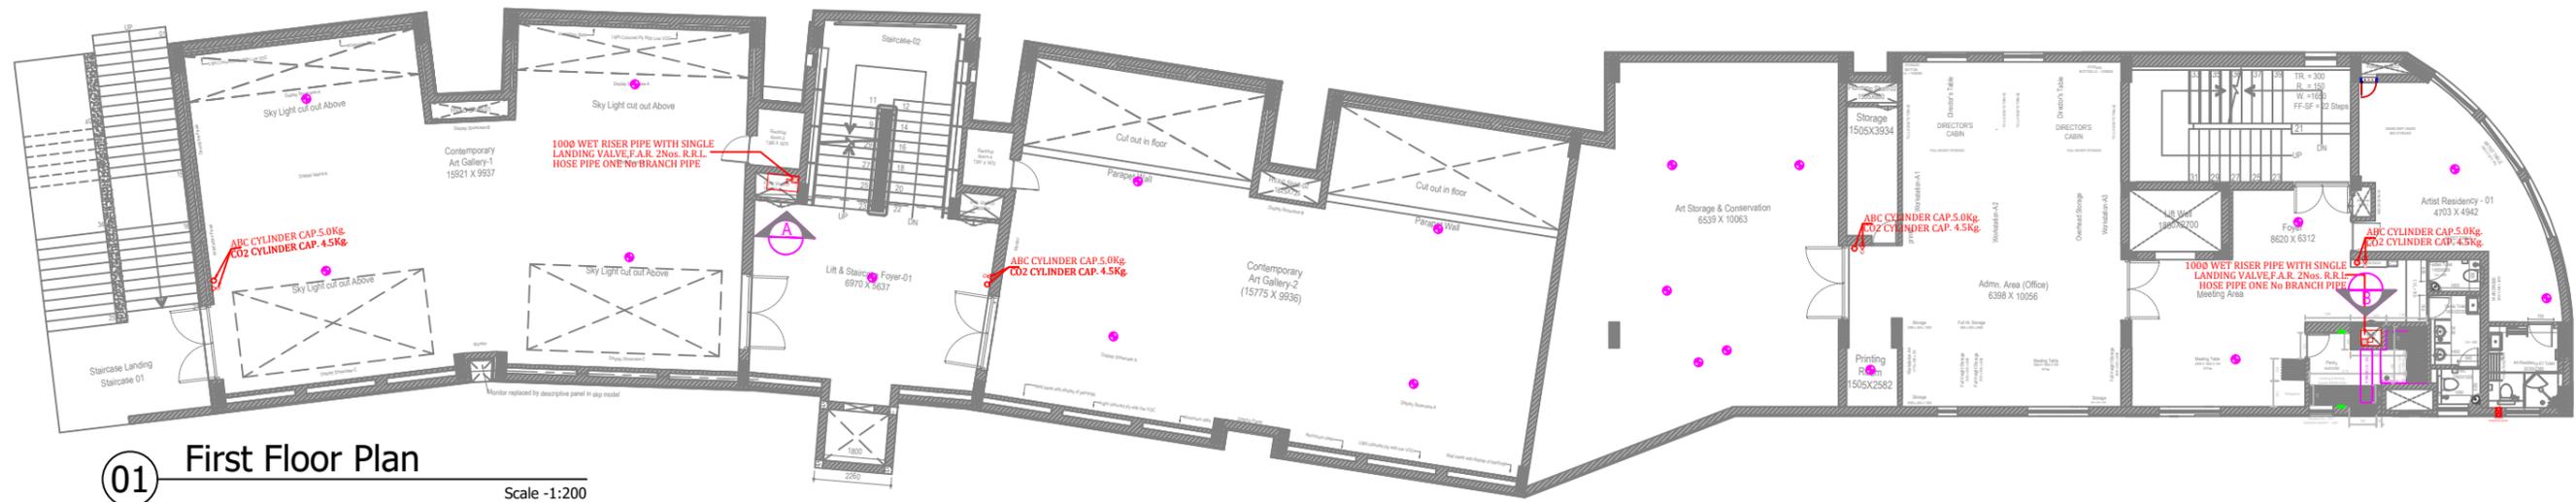

01 First Floor Plan
Scale -1:200

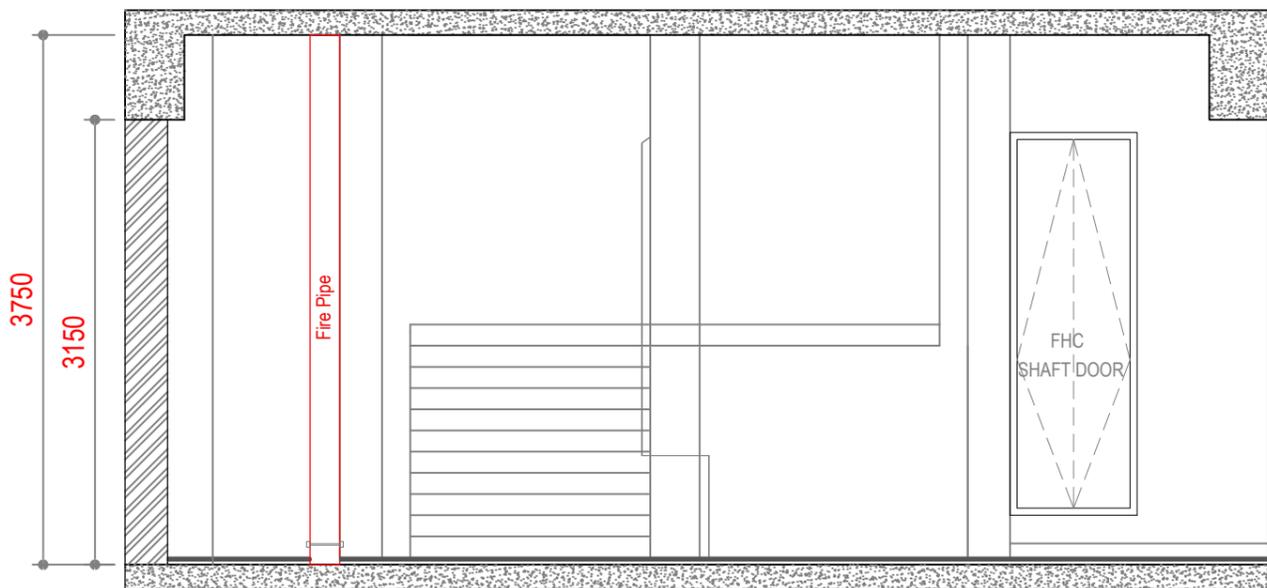

02 Sectional Elevation-A
Scale -1:50

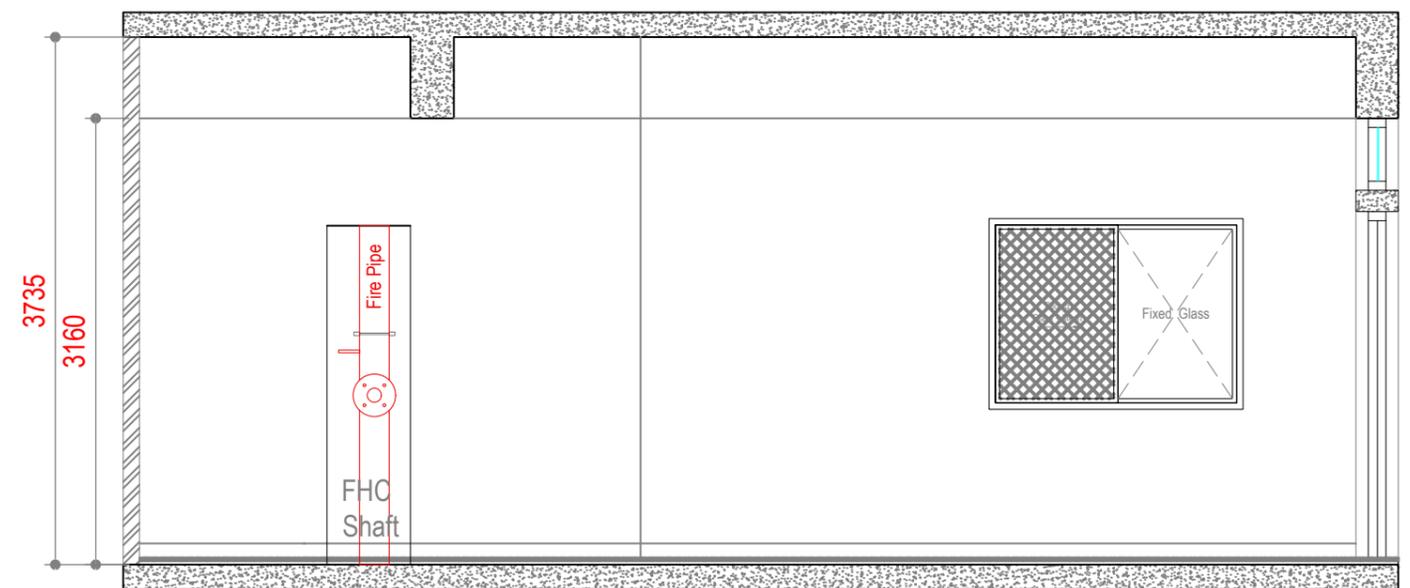


03 Sectional Elevation-B
Scale -1:50

NOTE:
THIS DRAWING IS A COPYRIGHT. IT IS THE PROPERTY OF STUDIO VANRO AND IS NOT TO BE REPRODUCED, COPIED, HANDED OVER TO A THIRD PARTY OR USED FOR ANY PURPOSE OTHER THAN THAT FOR WHICH IT HAS BEEN LOANED.

GENERAL NOTES:
ALL DIMENSIONS INDICATED ARE IN MILLIMETER UNLESS MENTIONED OTHERWISE
ALL DIMENSIONS ARE TO BE CROSS CHECKED AT SITE AND ANY DISCREPANCY SHALL BE BROUGHT TO NOTICE BEFORE EXECUTION.
ALL SERVICE DRAWINGS SHALL BE READ IN CONJUNCTION WITH THIS DRAWING AND OTHER DETAILS.
ANY DISCREPANCIES IN DRAWING MUST BE REPORTED IMMEDIATELY TO PM/ARCHITECT FOR FINAL DECISION BEFORE EXECUTION.

S.NO	DATE	DRAWN	CHECKED	VERIFIED	REMARKS

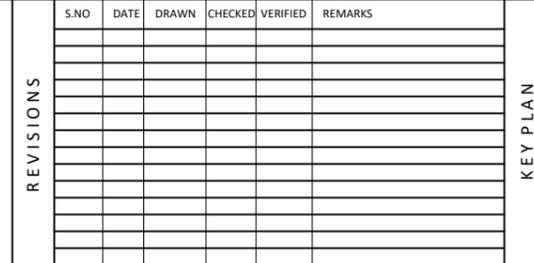


CLIENT	J D Centre of Art
ARCHITECT	VASTU SHILPA Consultants/ STUDIO VanRO
STRUCTURAL CONSULTANT	Mahendra Raj Consultants Pvt. Ltd
MUSEUM DESIGN	Siddhartha Das Studio
SANITARY, ELECTRICAL, HVAC, FIRE FIGHTING CONSULTANT	


PROJECT	J D Centre of Art, Bhubaneswar
DRAWING	FIRST FLOOR PLAN (FIRE FIGHTING)
SCALE	A3@1:200, 1:50
DRAWN BY	MAHESH PRAKASH
DATE	14-05-2025

COMPUTER FILE	01_JDCA_Ground Floor_Fire Safety_20250509.MP
CHECKED BY	VIVEK NAMDEV
DRAWING TITLE	



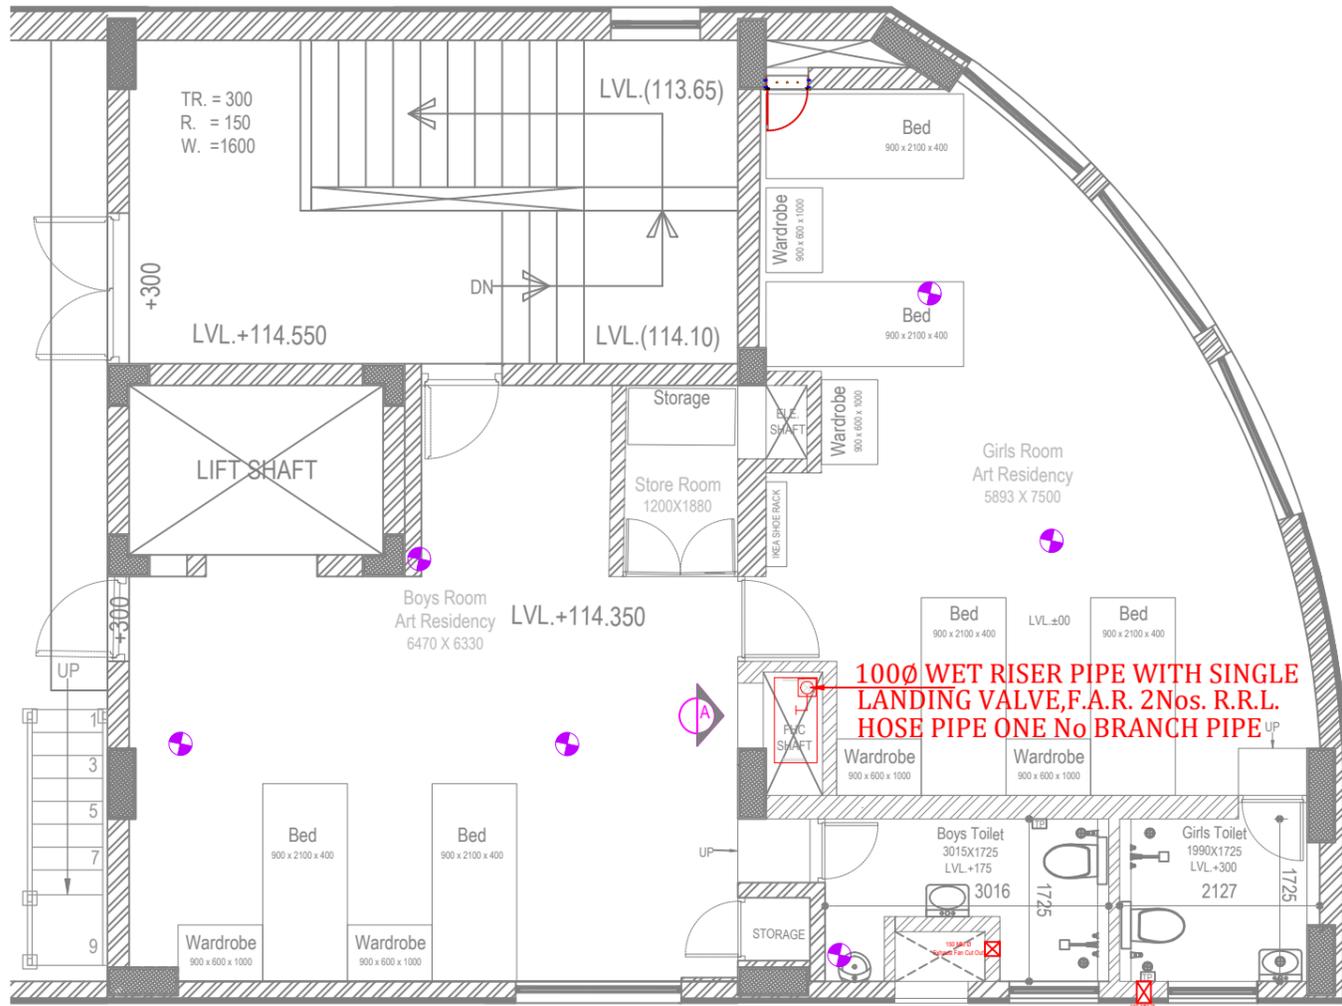

01 Third Floor Plan
Scale -1:75


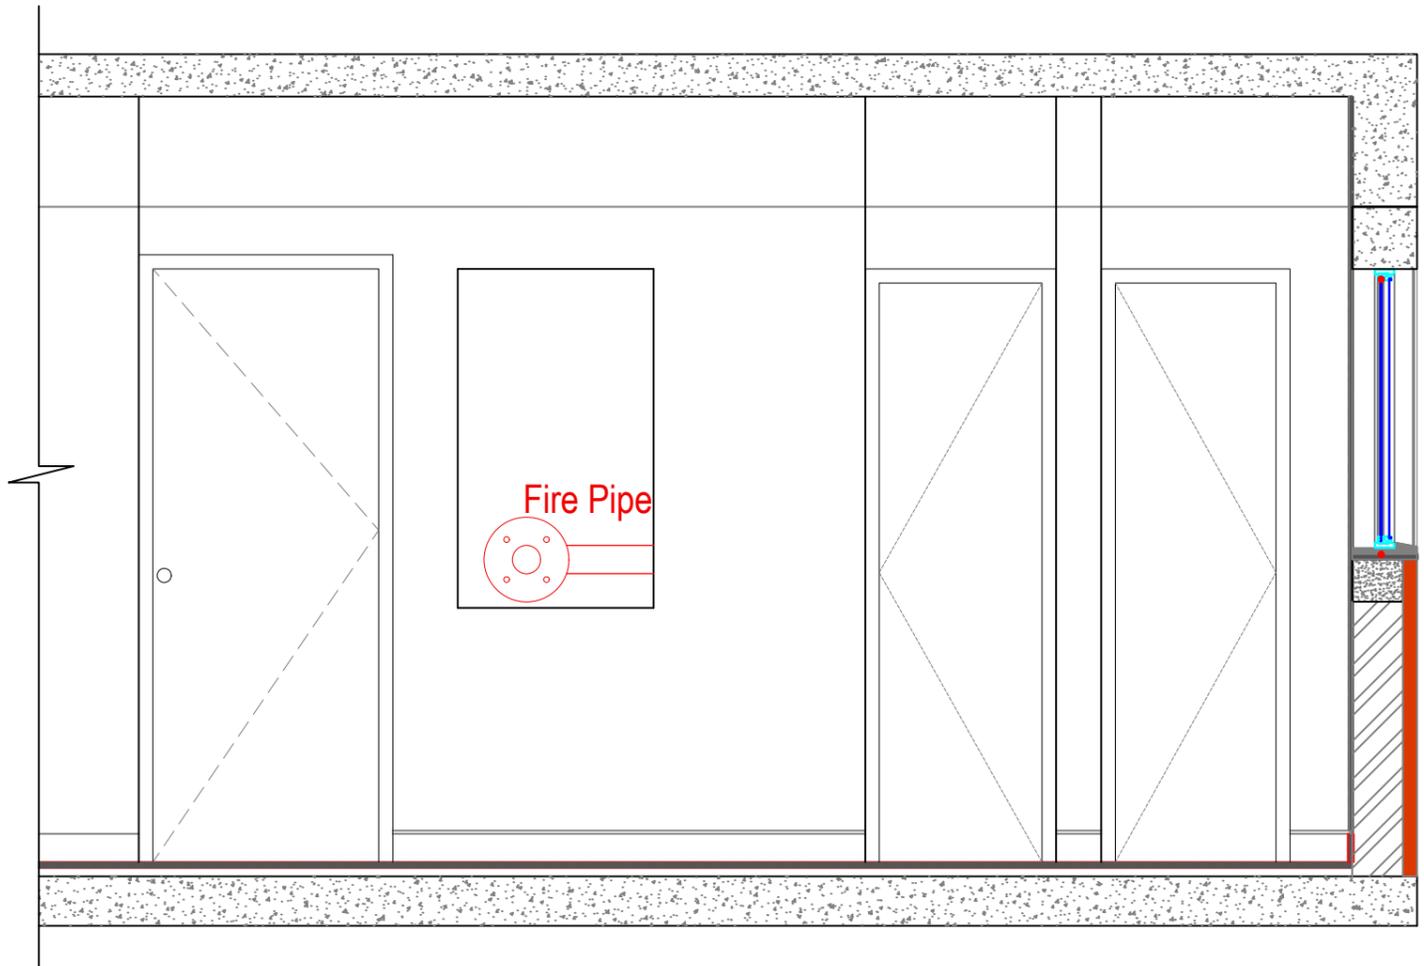


02 Sectional Elevation-A
Scale -1:25

NOTE:
THIS DRAWING IS A COPYRIGHT. IT IS THE PROPERTY OF STUDIO VANRO AND IS NOT TO BE REPRODUCED, COPIED, HANDED OVER TO A THIRD PARTY OR USED FOR ANY PURPOSE OTHER THAN THAT FOR WHICH IT HAS BEEN LOANED.

GENERAL NOTES:
ALL DIMENSIONS INDICATED ARE IN MILLIMETER UNLESS MENTIONED OTHERWISE
ALL DIMENSIONS ARE TO BE CROSS CHECKED AT SITE AND ANY DISCREPANCY SHALL BE BROUGHT TO NOTICE BEFORE EXECUTION.
ALL SERVICE DRAWINGS SHALL BE READ IN CONJUNCTION WITH THIS DRAWING AND OTHER DETAILS.
ANY DISCREPANCIES IN DRAWING MUST BE REPORTED IMMEDIATELY TO PMCI/ARCHITECT FOR FINAL DECISION BEFORE EXECUTION.

S.NO	DATE	DRAWN	CHECKED	VERIFIED	REMARKS

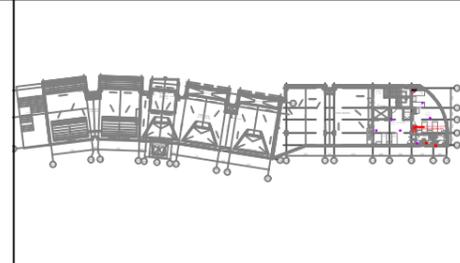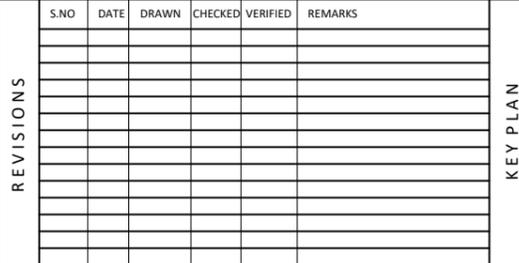


CLIENT		PROJECT	
J D Centre of Art		J D Centre of Art, Bhubaneswar	
ARCHITECT		DRAWING	
VASTU SHILPA Consultants/ STUDIO VanRO		THIRD FLOOR PLAN (FIRE FIGHTING)	
STRUCTURAL CONSULTANT		SCALE	COMPUTER FILE
Mahendra Raj Consultants Pvt. Ltd		A3@1:75,1:25	01.JDCA_Third Floor_Fire Safety_20250514-MP
MUSEUM DESIGN		DRAWN BY	CHECKED BY
Siddhartha Das Studio		MAHESH PRAKASH	VIVEK NAMDEV
SANITARY, ELECTRICAL, HVAC, FIRE FIGHTING CONSULTANT		DATE	DRAWING TITLE
		14-05-2025	




Fire Trench


Detailed

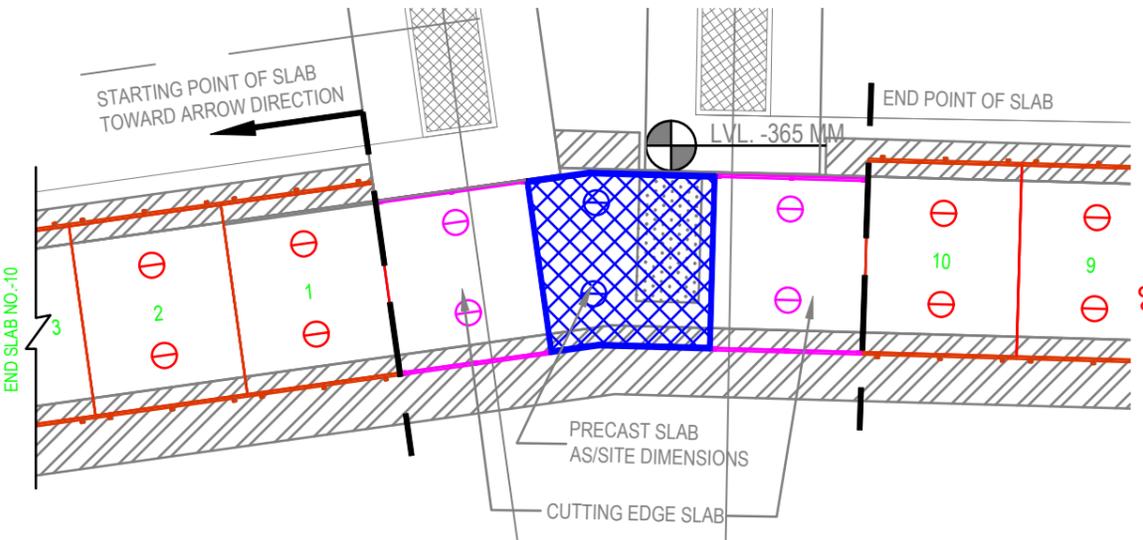


FIRE TRANCH PLAN

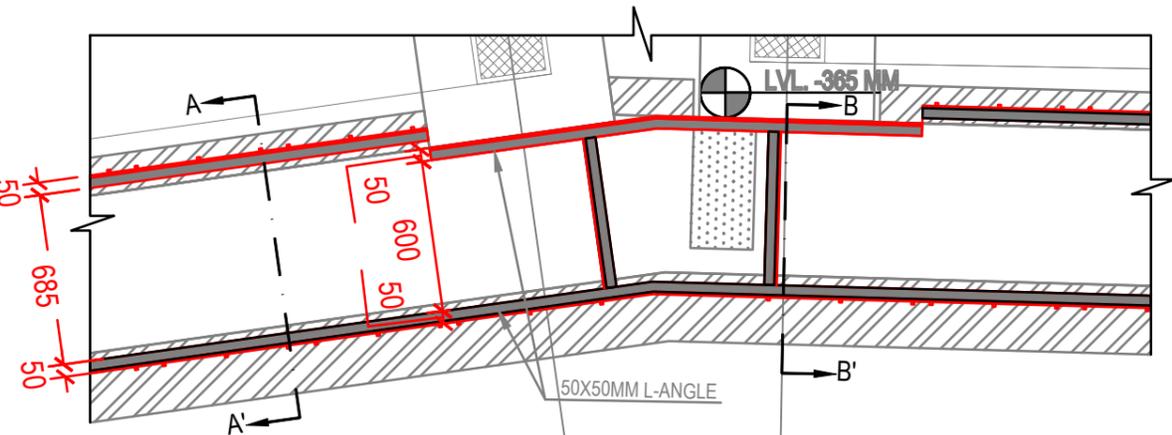


L-ANGLE DETAIL

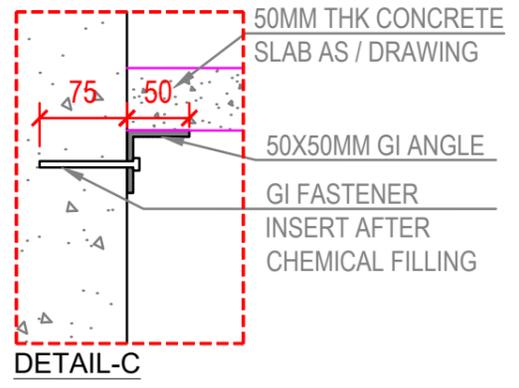


DETAIL-C

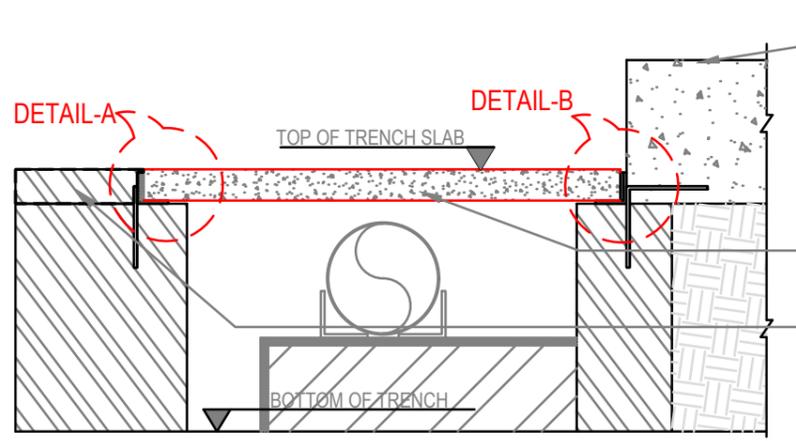


SECTION-AA

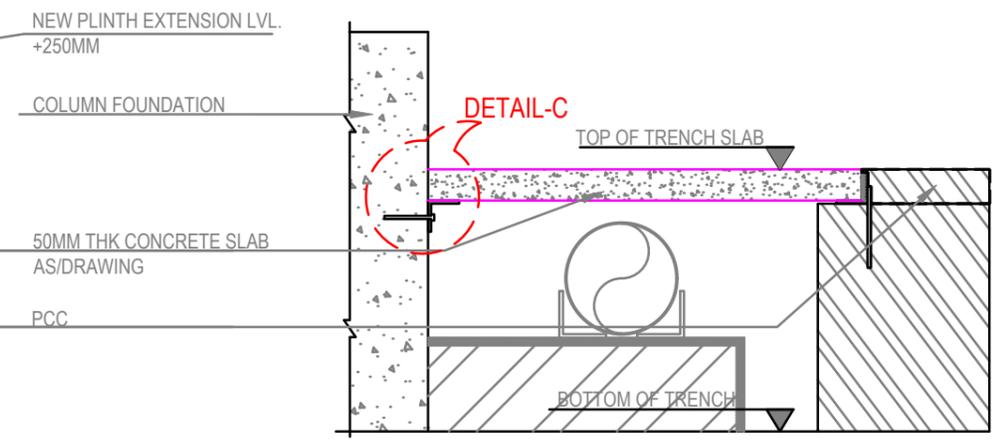


SECTION-BB

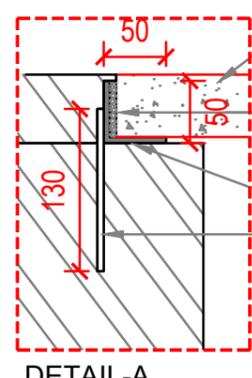

DETAIL-A

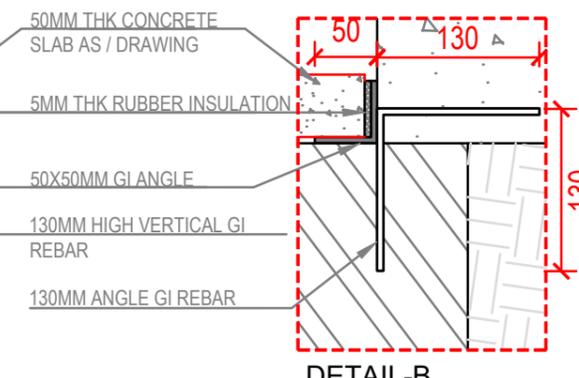

DETAIL-B

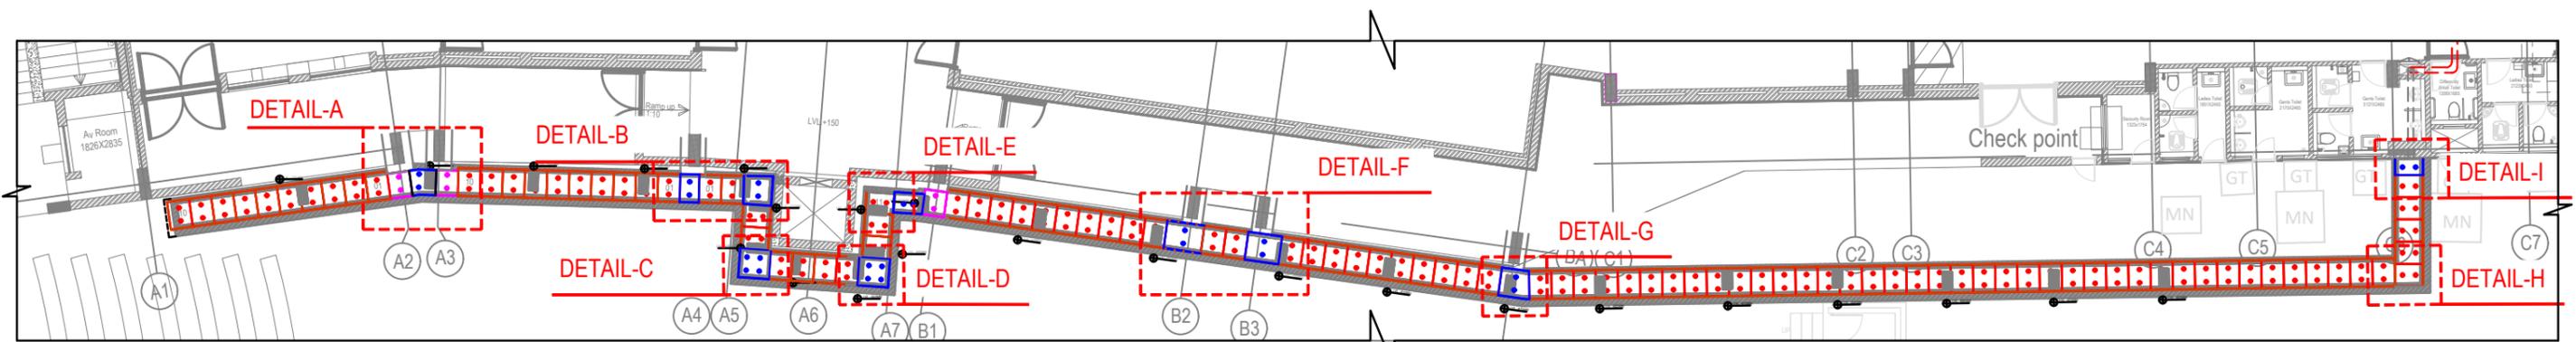

KEY PLAN

NOTE:
THIS DRAWING IS A COPYRIGHT. IT IS THE PROPERTY OF STUDIO VANRO AND IS NOT TO BE REPRODUCED, COPIED, HANDED OVER TO A THIRD PARTY OR USED FOR ANY PURPOSE OTHER THAN THAT FOR WHICH IT HAS BEEN LOANED.


GENERAL NOTES:
ALL DIMENSIONS INDICATED ARE IN MILLIMETER UNLESS MENTIONED OTHERWISE
ALL DIMENSIONS ARE TO BE CROSS CHECKED AT SITE AND ANY DISCREPANCY SHALL BE BROUGHT TO NOTICE BEFORE EXECUTION.
ALL SERVICE DRAWINGS SHALL BE READ IN CONJUNCTION WITH THIS DRAWING AND OTHER DETAILS.
ANY DISCREPANCIES IN DRAWING MUST BE REPORTED IMMEDIATELY TO PMCI/ARCHITECT FOR FINAL DECISION BEFORE EXECUTION.

S.NO	DATE	DRAWN	CHECKED	VERIFIED	REMARKS


CLIENT	PROJECT
J D Centre of Art	J D Centre of Art, Bhubaneswar
ARCHITECT	DRAWING
STUDIO VanRO	FIRE TRENCH - DETAIL SHEET-A
STRUCTURAL CONSULTANT	SCALE
Mahendra Raj Consultants Pvt. Ltd	COMPUTER FILE
MUSEUM DESIGN	DRAWN BY
Siddhartha Das Studio	CHECKED BY
SANITARY, ELECTRICAL, HVAC, FIRE FIGHTING CONSULTANT	MAHESH PRAKASH
DATE	VIVEK NAMDEV
26-06-2024	DRAWING TITLE

REVISIONS


KEY PLAN

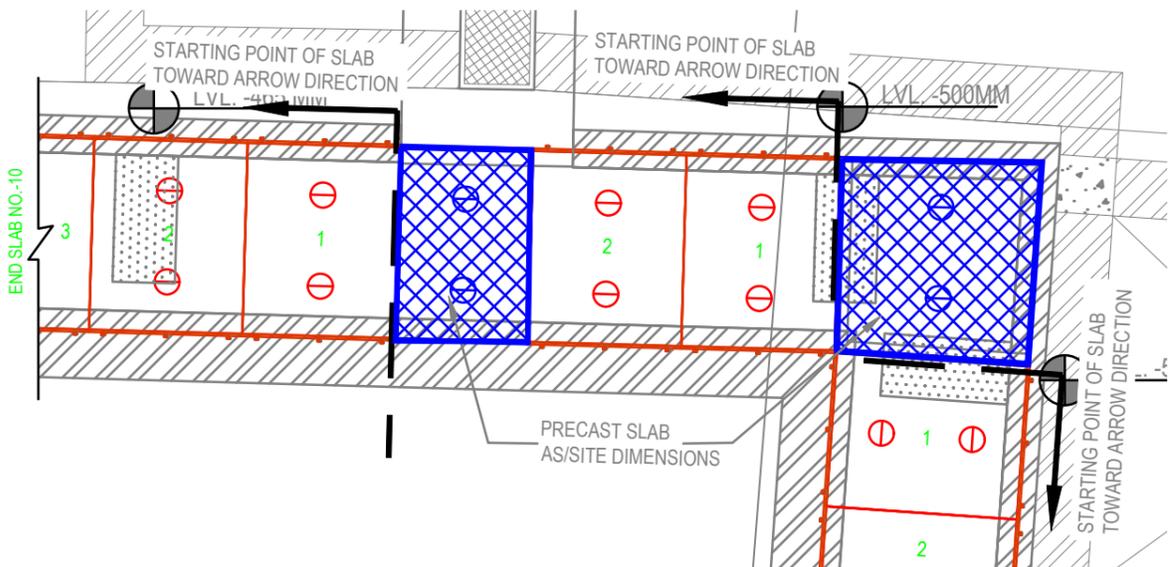


FIRE TRENCH PLAN

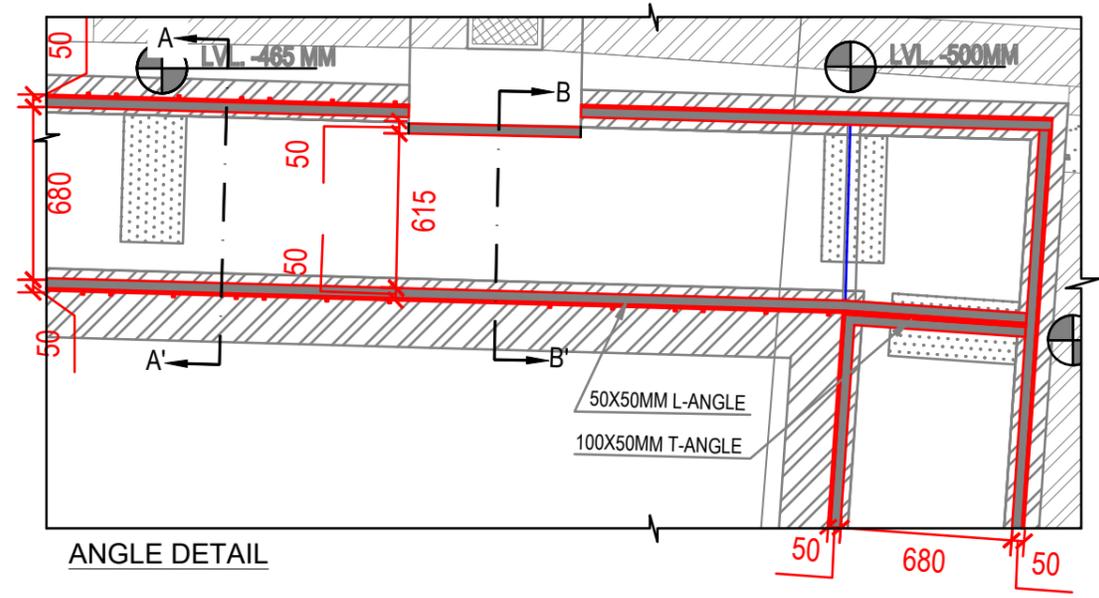

ANGLE DETAIL

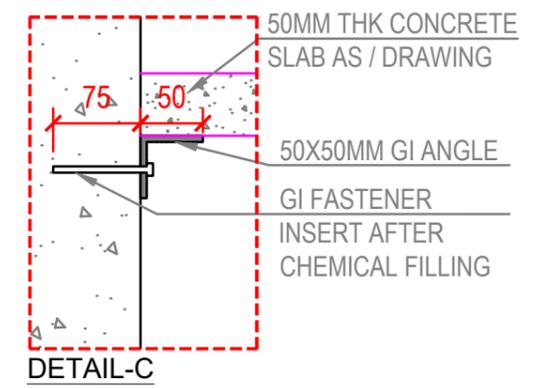


DETAIL-C

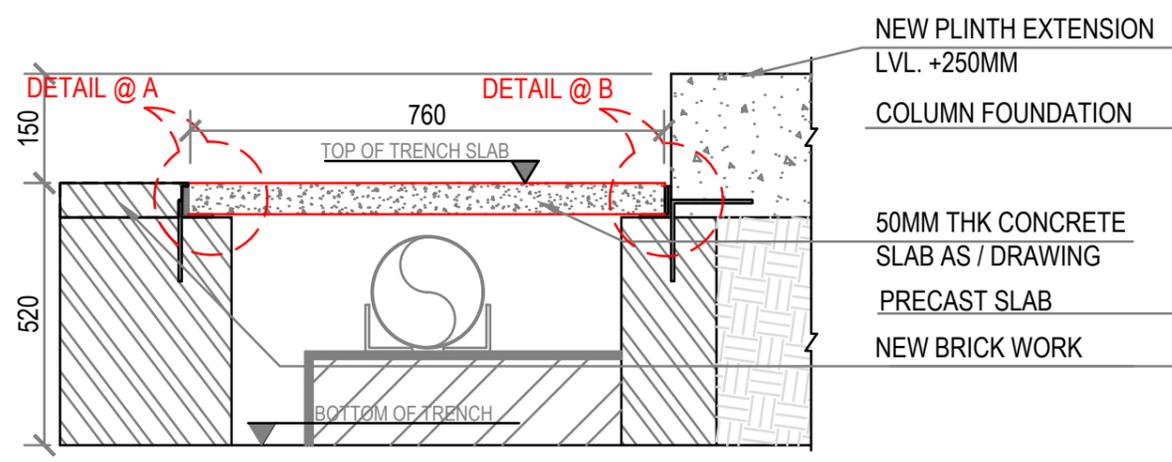



SECTION A-A'

SCALE - 1:16

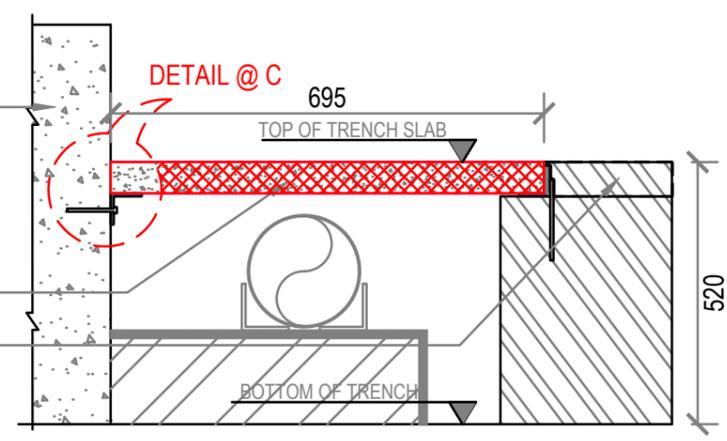

SECTION B-B'

SCALE - 1:16

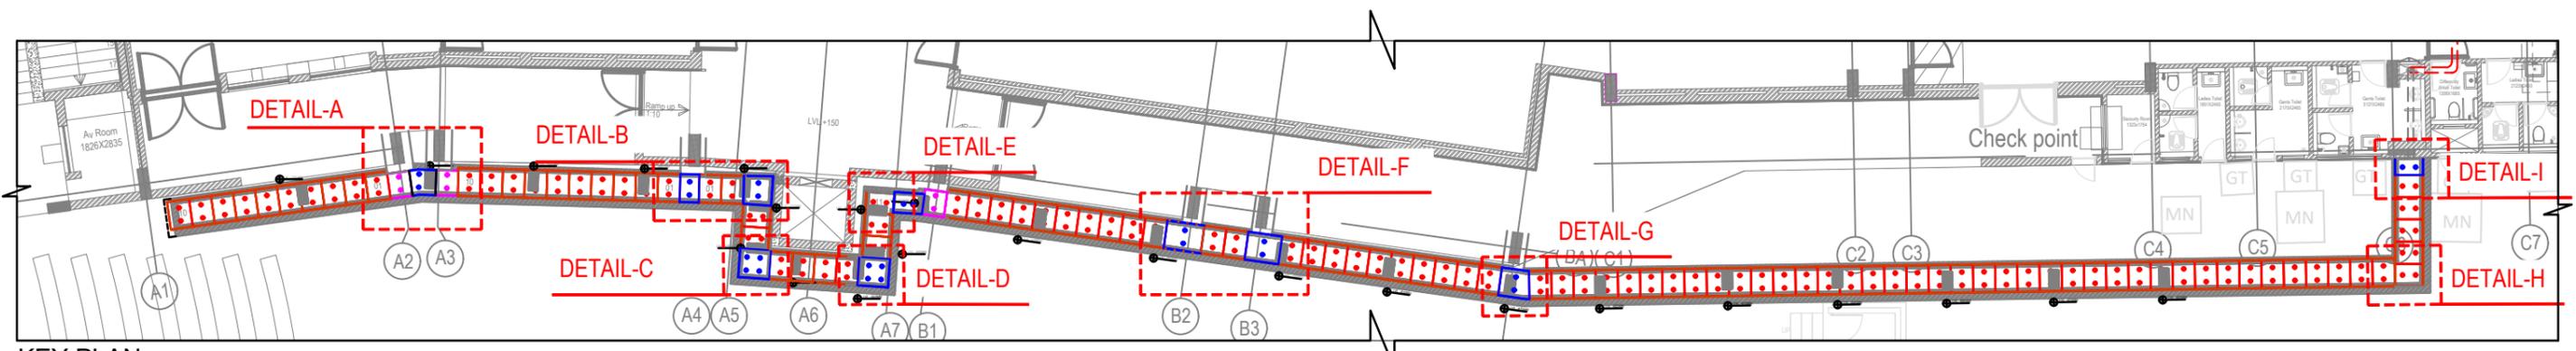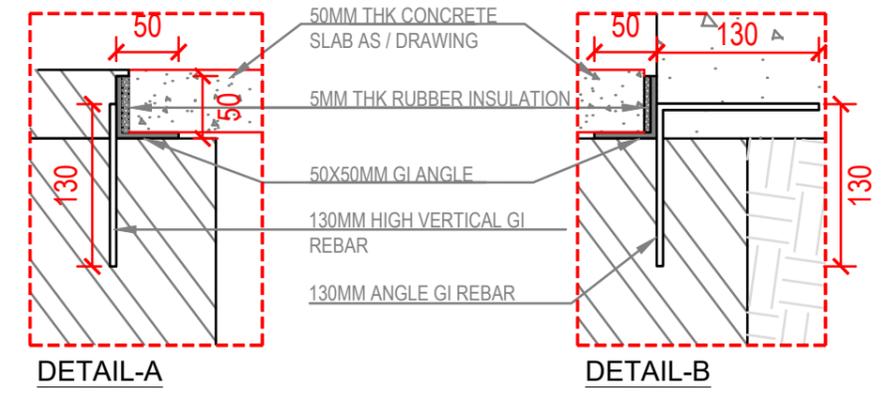

KEY PLAN


NOTE:
THIS DRAWING IS A COPYRIGHT. IT IS THE PROPERTY OF STUDIO VANRO AND IS NOT TO BE REPRODUCED, COPIED, HANDED OVER TO A THIRD PARTY OR USED FOR ANY PURPOSE OTHER THAN THAT FOR WHICH IT HAS BEEN LOANED.

GENERAL NOTES:
ALL DIMENSIONS INDICATED ARE IN MILLIMETER UNLESS MENTIONED OTHERWISE
ALL DIMENSIONS ARE TO BE CROSS CHECKED AT SITE AND ANY DISCREPANCY SHALL BE BROUGHT TO NOTICE BEFORE EXECUTION.
ALL SERVICE DRAWINGS SHALL BE READ IN CONJUNCTION WITH THIS DRAWING AND OTHER DETAILS.
ANY DISCREPANCIES IN DRAWING MUST BE REPORTED IMMEDIATELY TO PMCI/ARCHITECT FOR FINAL DECISION BEFORE EXECUTION.


S.NO	DATE	DRAWN	CHECKED	VERIFIED	REMARKS

CLIENT	PROJECT
J D Centre of Art	J D Centre of Art, Bhubaneswar
ARCHITECT	DRAWING
STUDIO VanRO	FIRE TRENCH - DETAIL SHEET-B
STRUCTURAL CONSULTANT	SCALE
Mahendra Raj Consultants Pvt. Ltd	COMPUTER FILE
MUSEUM DESIGN	DRAWN BY
Siddhartha Das Studio	CHECKED BY
SANITARY, ELECTRICAL, HVAC, FIRE FIGHTING CONSULTANT	MAHESH PRAKASH VIVEK NAMDEV
	DATE
	DRAWING TITLE
	26-06-2024


REVISIONS	KEY PLAN	
-----------	----------	--

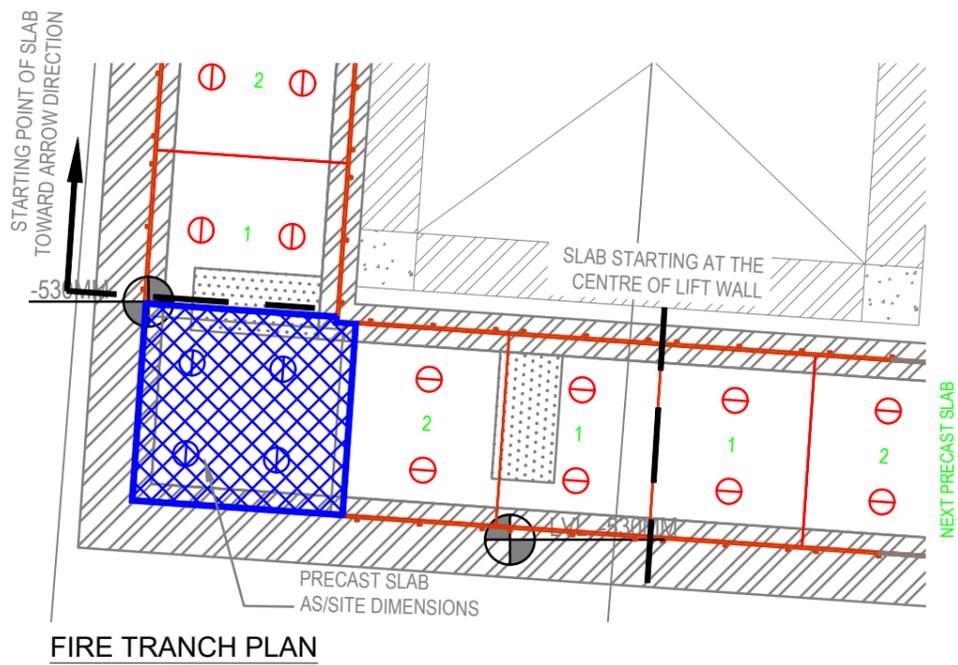



FIRE TRANCH PLAN

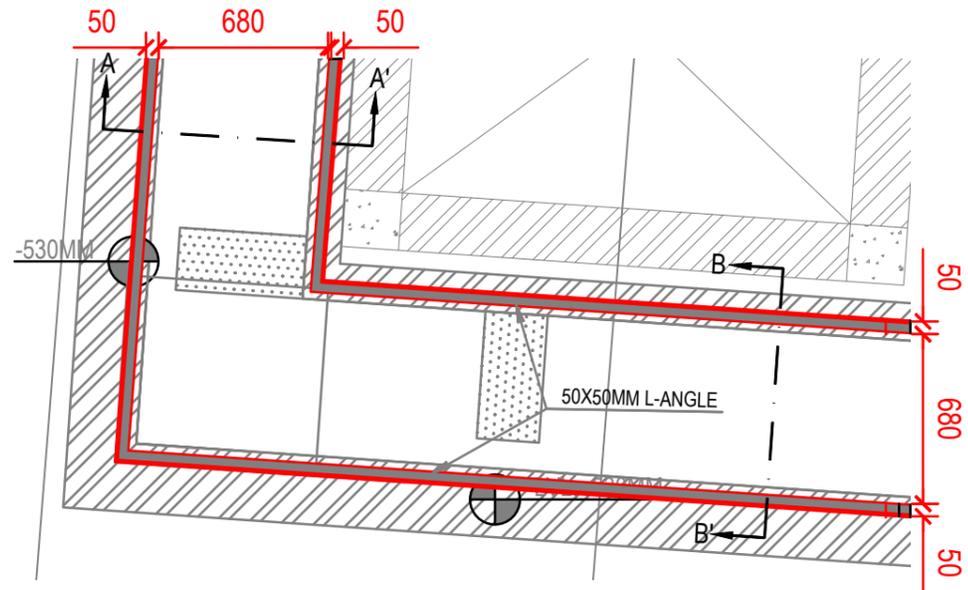

ANGLE DETAIL

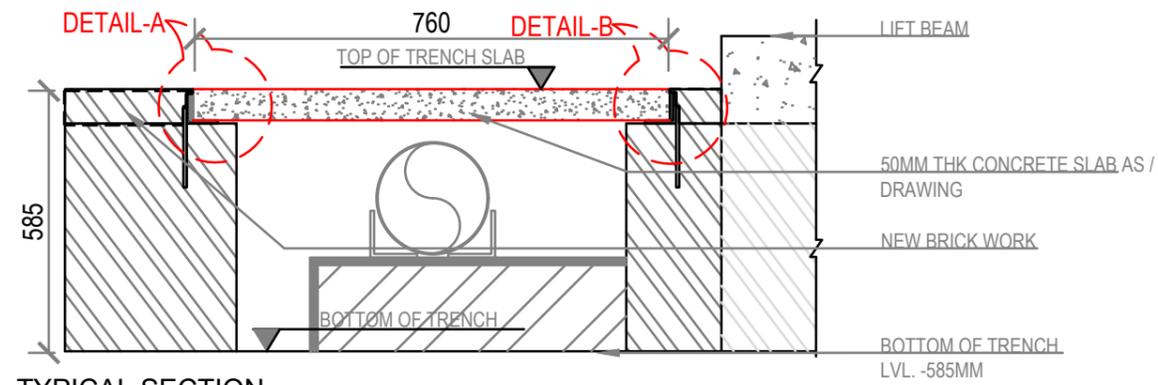

TYPICAL SECTION

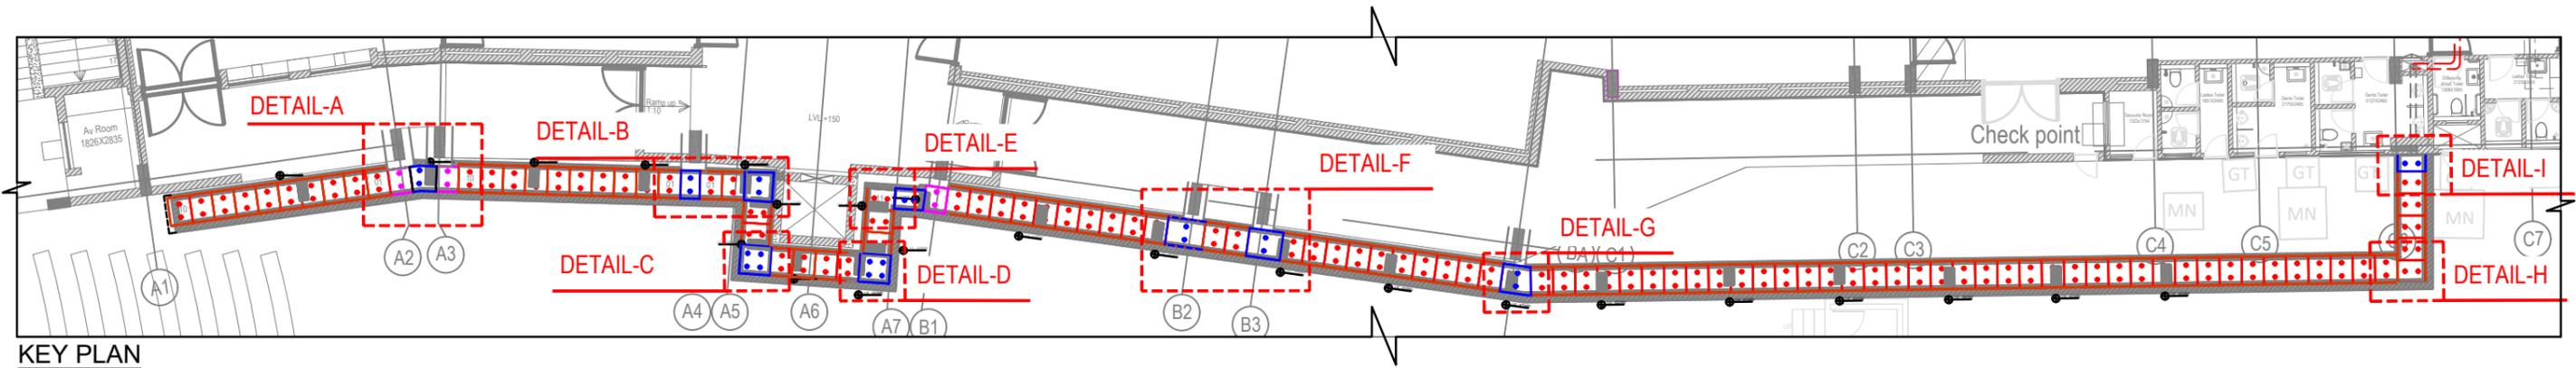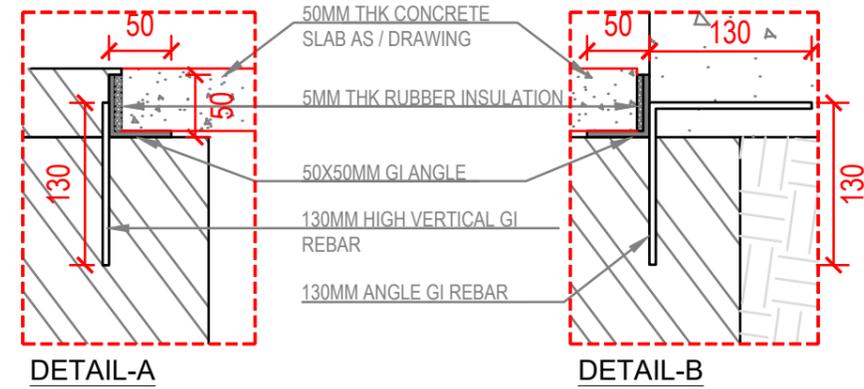

KEY PLAN

NOTE:
THIS DRAWING IS A COPYRIGHT. IT IS THE PROPERTY OF STUDIO VANRO AND IS NOT TO BE REPRODUCED, COPIED, HANDED OVER TO A THIRD PARTY OR USED FOR ANY PURPOSE OTHER THAN THAT FOR WHICH IT HAS BEEN LOANED.

GENERAL NOTES:
ALL DIMENSIONS INDICATED ARE IN MILLIMETER UNLESS MENTIONED OTHERWISE
ALL DIMENSIONS ARE TO BE CROSS CHECKED AT SITE AND ANY DISCREPANCY SHALL BE BROUGHT TO NOTICE BEFORE EXECUTION.
ALL SERVICE DRAWINGS SHALL BE READ IN CONJUNCTION WITH THIS DRAWING AND OTHER DETAILS.
ANY DISCREPANCIES IN DRAWING MUST BE REPORTED IMMEDIATELY TO PMCI/ARCHITECT FOR FINAL DECISION BEFORE EXECUTION.

S.NO	DATE	DRAWN	CHECKED	VERIFIED	REMARKS







REVISIONS

KEY PLAN

CLIENT	PROJECT	
J D Centre of Art	J D Centre of Art, Bhubaneswar	
ARCHITECT	DRAWING	
STUDIO VanRO	FIRE TRENCH - DETAIL SHEET-C	
STRUCTURAL CONSULTANT	SCALE	COMPUTER FILE
Mahendra Raj Consultants Pvt. Ltd		
MUSEUM DESIGN	DRAWN BY	CHECKED BY
Siddhartha Das Studio	MAHESH PRAKASH	VIVEK NAMDEV
SANITARY, ELECTRICAL, HVAC, FIRE FIGHTING CONSULTANT	DATE	DRAWING TITLE
	26-06-2024	



DETAIL SHEET - D

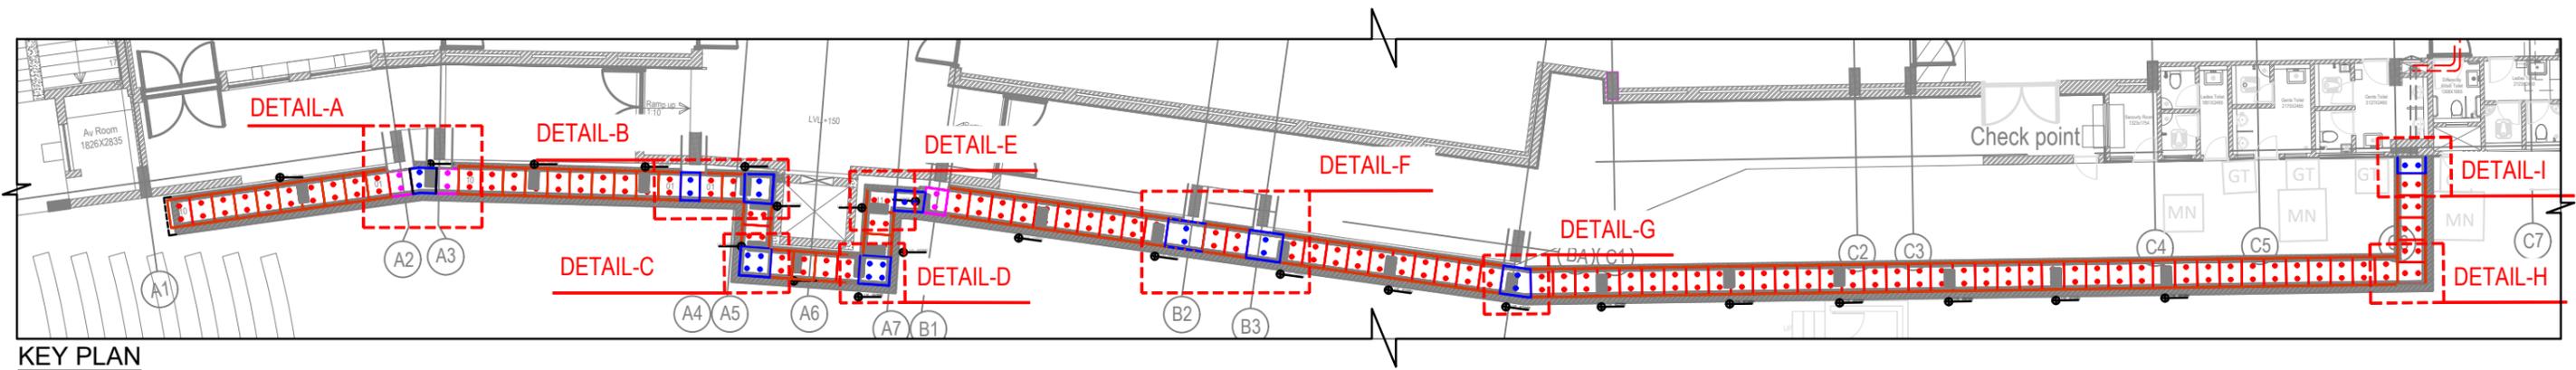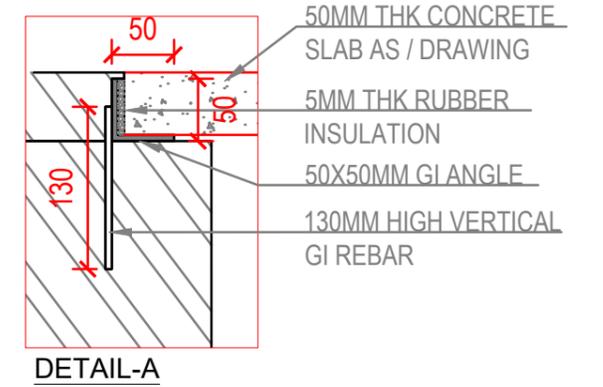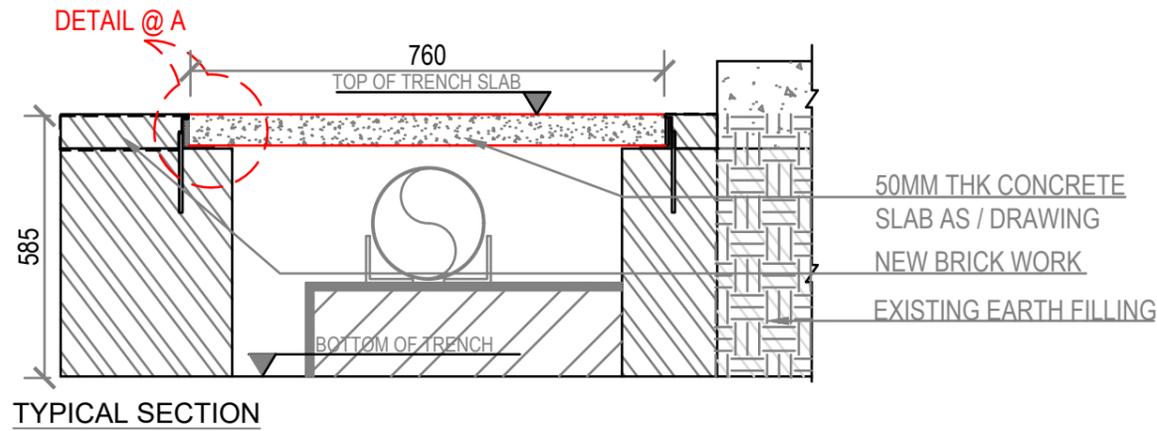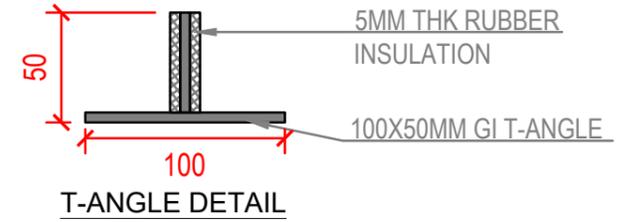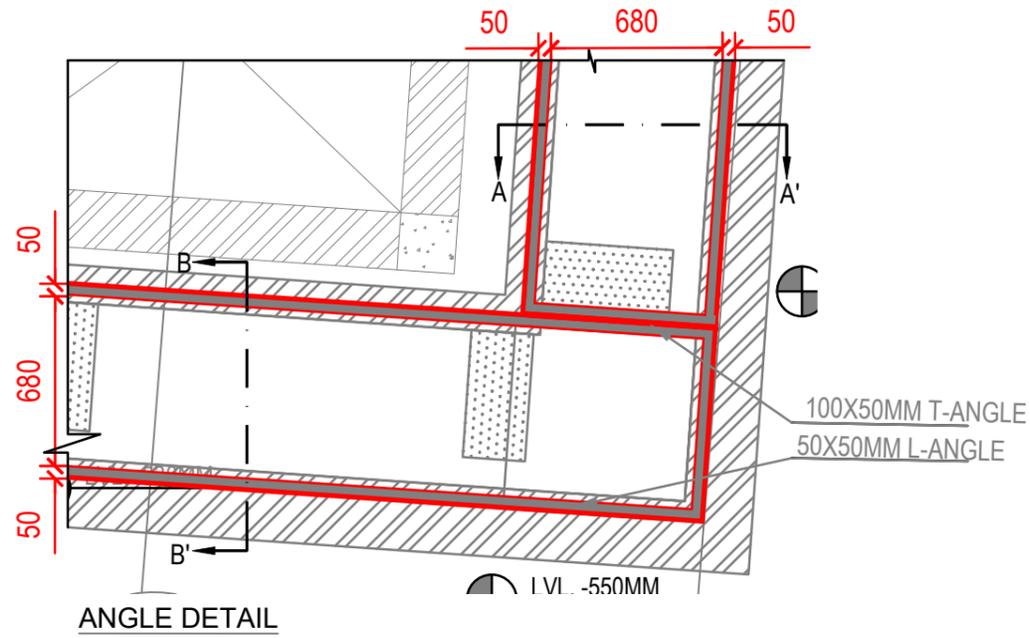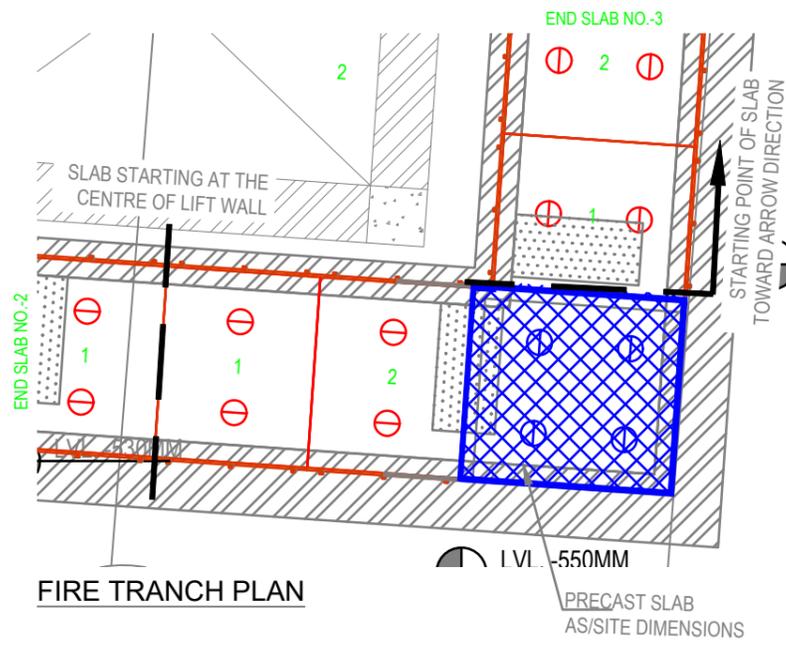

NOTE:
THIS DRAWING IS A COPYRIGHT. IT IS THE PROPERTY OF STUDIO VANRO AND IS NOT TO BE REPRODUCED, COPIED, HANDED OVER TO A THIRD PARTY OR USED FOR ANY PURPOSE OTHER THAN THAT FOR WHICH IT HAS BEEN LOANED.

GENERAL NOTES:
ALL DIMENSIONS INDICATED ARE IN MILLIMETER UNLESS MENTIONED OTHERWISE
ALL DIMENSIONS ARE TO BE CROSS CHECKED AT SITE AND ANY DISCREPANCY SHALL BE BROUGHT TO NOTICE BEFORE EXECUTION.
ALL SERVICE DRAWINGS SHALL BE READ IN CONJUNCTION WITH THIS DRAWING AND OTHER DETAILS.
ANY DISCREPANCIES IN DRAWING MUST BE REPORTED IMMEDIATELY TO PM/ARCHITECT FOR FINAL DECISION BEFORE EXECUTION.

S.NO	DATE	DRAWN	CHECKED	VERIFIED	REMARKS


REVISIONS

KEY PLAN


CLIENT		PROJECT	
J D Centre of Art		J D Centre of Art, Bhubaneswar	
ARCHITECT		DRAWING	
STUDIO VanRO		FIRE TRENCH - DETAIL SHEET-D	
STRUCTURAL CONSULTANT		SCALE	COMPUTER FILE
Mahendra Raj Consultants Pvt. Ltd			
MUSEUM DESIGN		DRAWN BY	CHECKED BY
Siddhartha Das Studio		MAHESH PRAKASH	VIVEK NAMDEV
SANITARY, ELECTRICAL, HVAC, FIRE FIGHTING CONSULTANT		DATE	DRAWING TITLE
		26-06-2024	




DETAIL SHEET - E

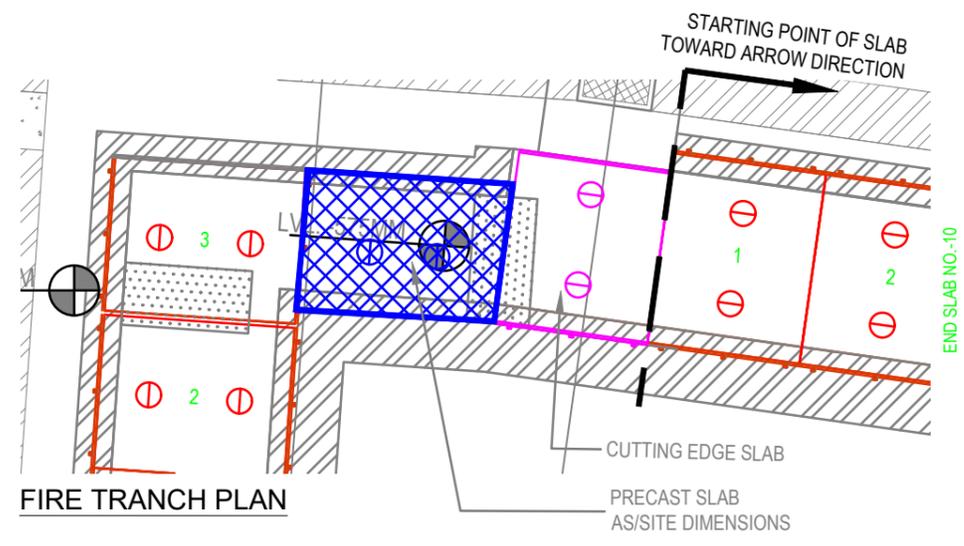


FIRE TRENCH PLAN

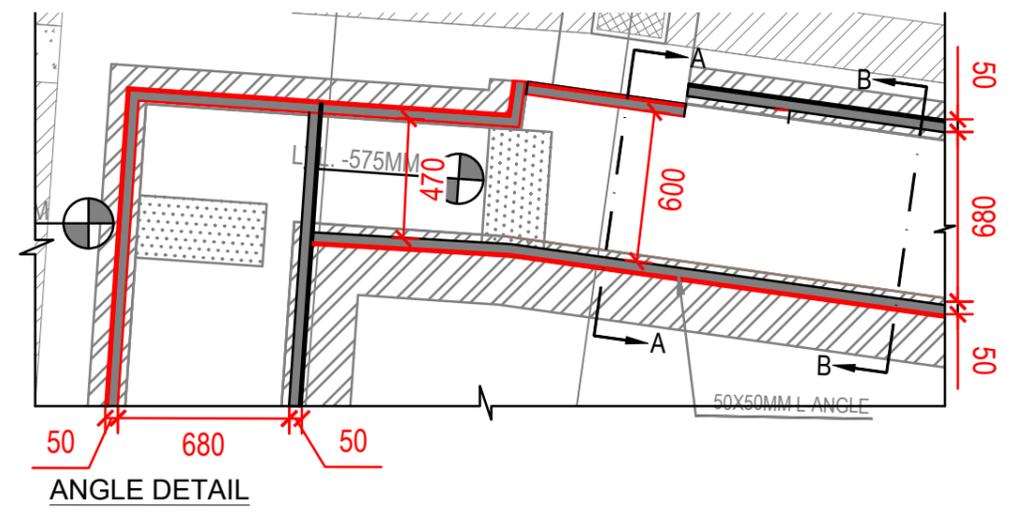


ANGLE DETAIL

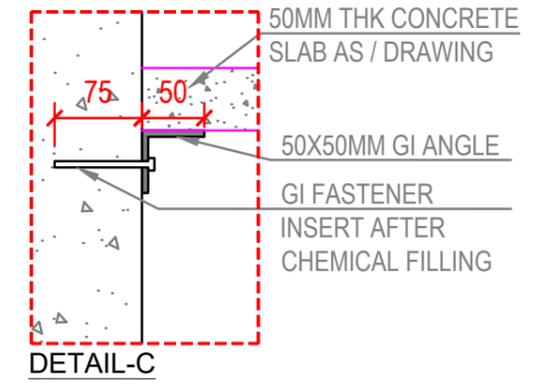


DETAIL-C

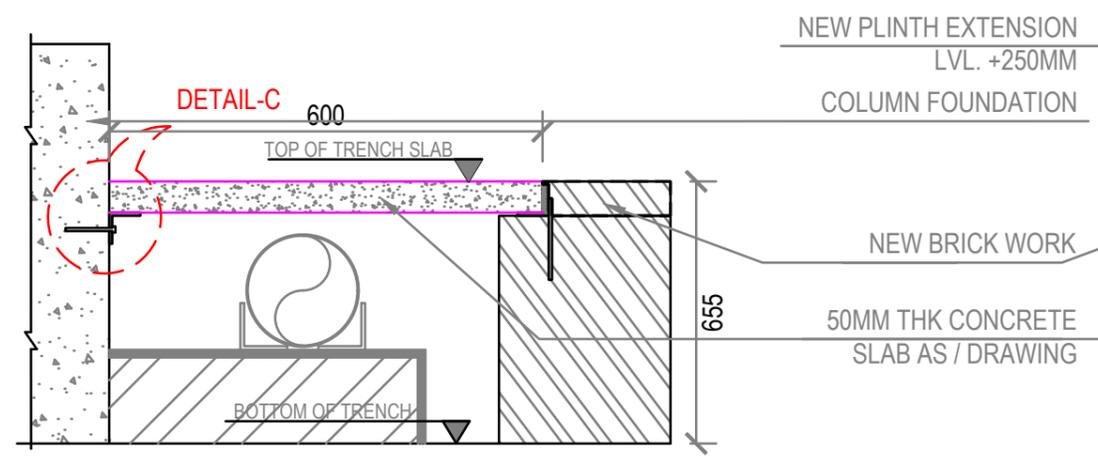

SECTION-AA

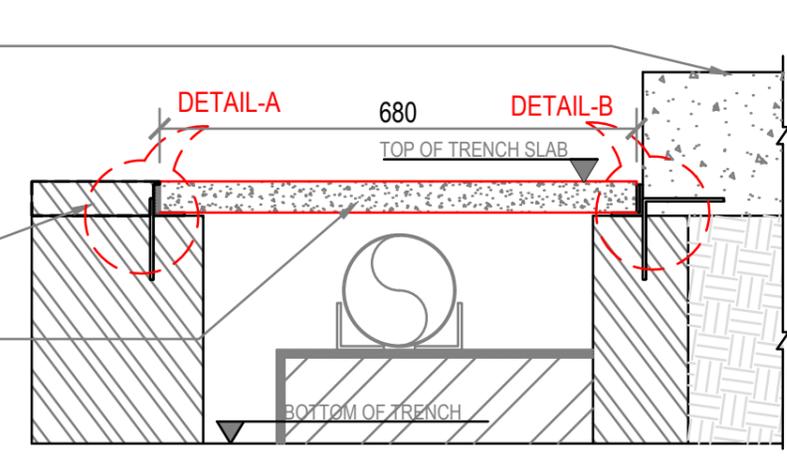


SECTION-BB

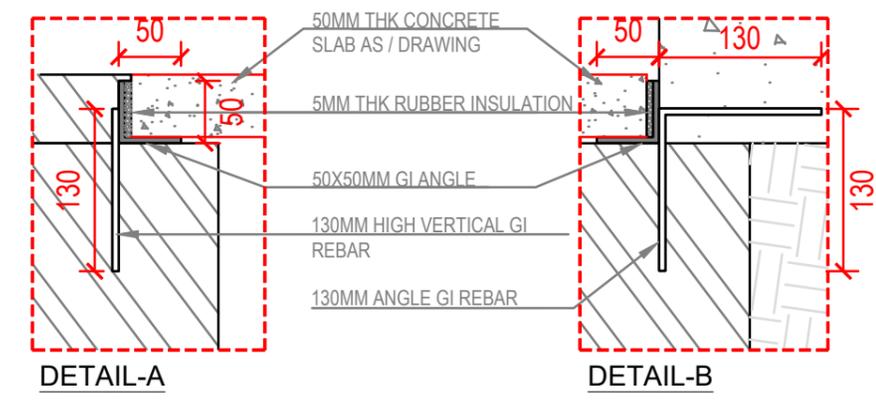

DETAIL-A

DETAIL-B

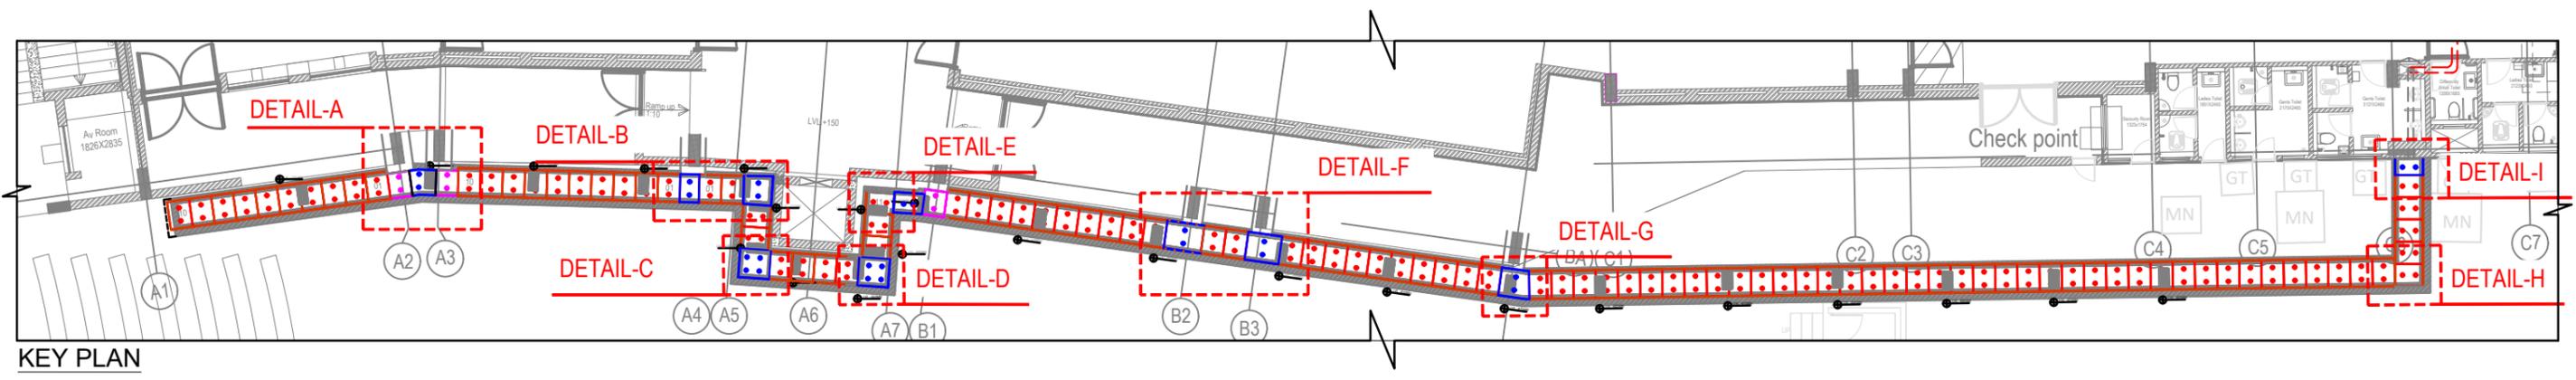

KEY PLAN

NOTE:
THIS DRAWING IS A COPYRIGHT. IT IS THE PROPERTY OF STUDIO VANRO AND IS NOT TO BE REPRODUCED, COPIED, HANDED OVER TO A THIRD PARTY OR USED FOR ANY PURPOSE OTHER THAN THAT FOR WHICH IT HAS BEEN LOANED.







GENERAL NOTES:
ALL DIMENSIONS INDICATED ARE IN MILLIMETER UNLESS MENTIONED OTHERWISE
ALL DIMENSIONS ARE TO BE CROSS CHECKED AT SITE AND ANY DISCREPANCY SHALL BE BROUGHT TO NOTICE BEFORE EXECUTION.
ALL SERVICE DRAWINGS SHALL BE READ IN CONJUNCTION WITH THIS DRAWING AND OTHER DETAILS.
ANY DISCREPANCIES IN DRAWING MUST BE REPORTED IMMEDIATELY TO PMCI/ARCHITECT FOR FINAL DECISION BEFORE EXECUTION.

S.NO	DATE	DRAWN	CHECKED	VERIFIED	REMARKS

CLIENT	PROJECT
J D Centre of Art	J D Centre of Art, Bhubaneswar
ARCHITECT	DRAWING
STUDIO VanRO	FIRE TRENCH - DETAIL SHEET-E
STRUCTURAL CONSULTANT	SCALE
Mahendra Raj Consultants Pvt. Ltd	COMPUTER FILE
MUSEUM DESIGN	DRAWN BY
Siddhartha Das Studio	CHECKED BY
SANITARY, ELECTRICAL, HVAC, FIRE FIGHTING CONSULTANT	MAHESH PRAKASH
	VIVEK NAMDEV
	DATE
	DRAWING TITLE
	26-06-2024

REVISIONS

KEY PLAN

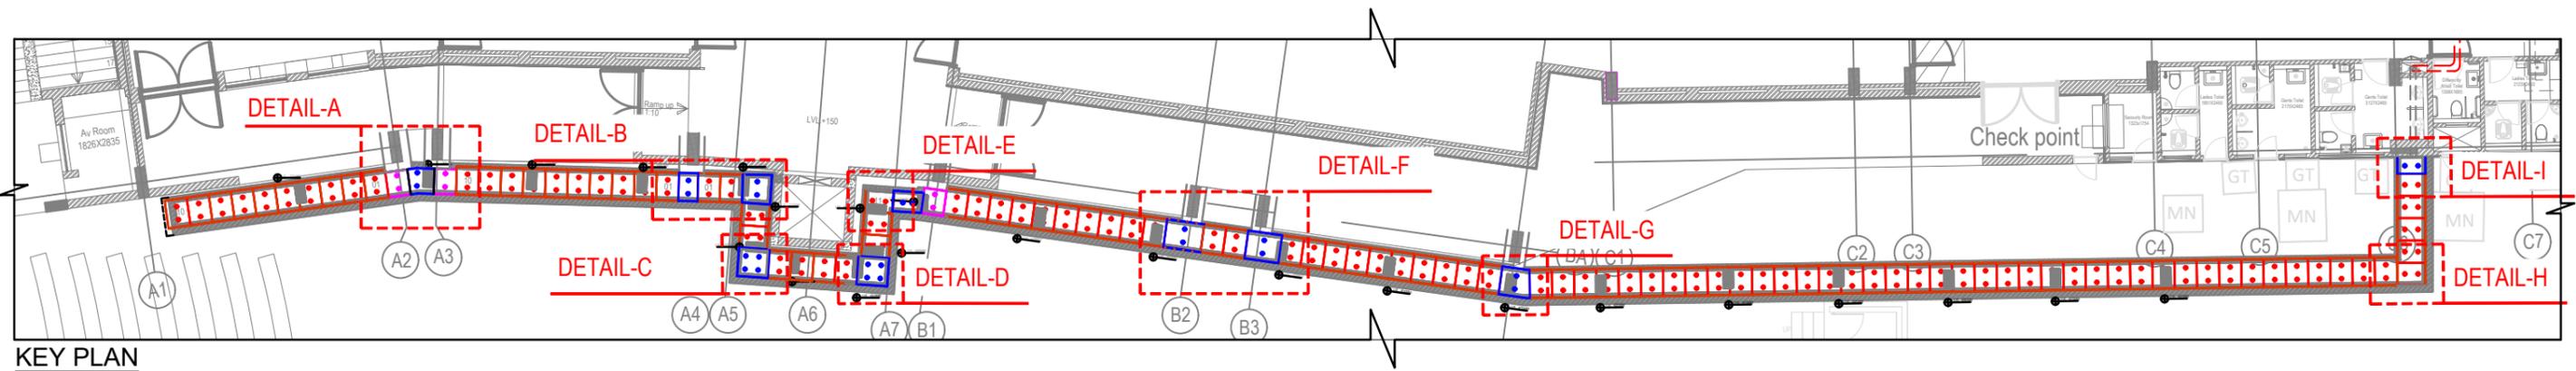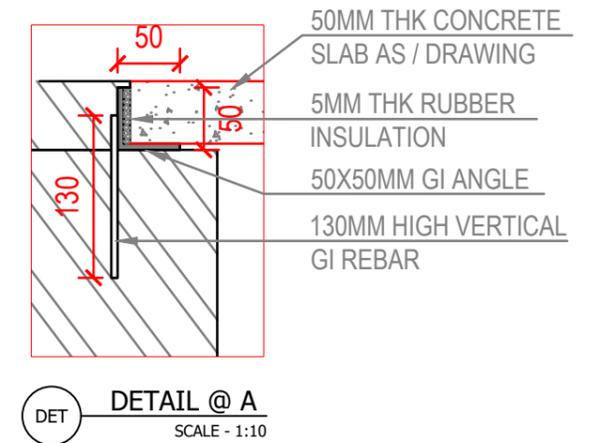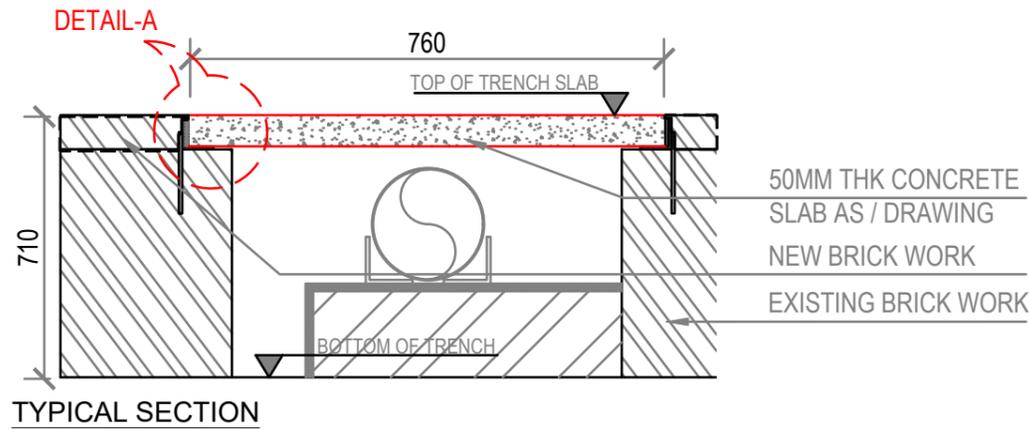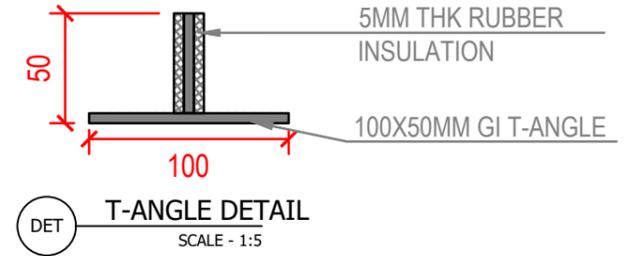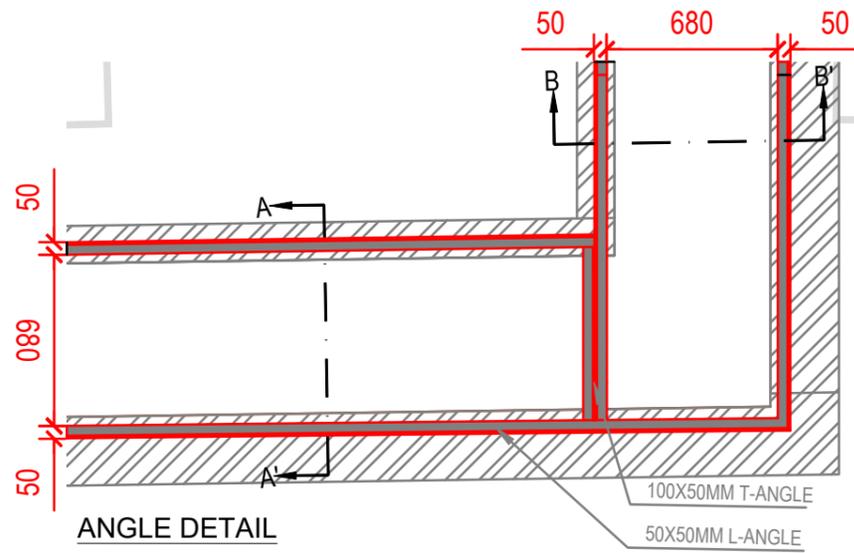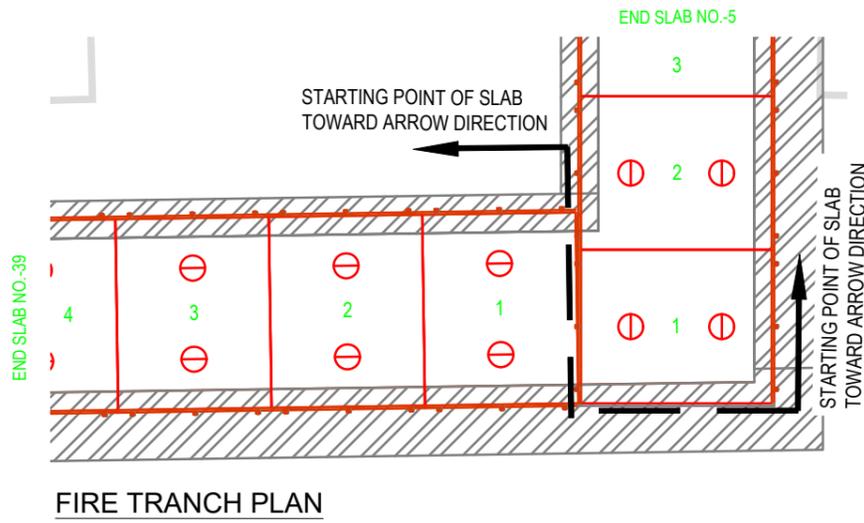

NOTE:
THIS DRAWING IS A COPYRIGHT. IT IS THE PROPERTY OF STUDIO VANRO AND IS NOT TO BE REPRODUCED, COPIED, HANDED OVER TO A THIRD PARTY OR USED FOR ANY PURPOSE OTHER THAN THAT FOR WHICH IT HAS BEEN LOANED.

GENERAL NOTES:
ALL DIMENSIONS INDICATED ARE IN MILLIMETER UNLESS MENTIONED OTHERWISE
ALL DIMENSIONS ARE TO BE CROSS CHECKED AT SITE AND ANY DISCREPANCY SHALL BE BROUGHT TO NOTICE BEFORE EXECUTION.
ALL SERVICE DRAWINGS SHALL BE READ IN CONJUNCTION WITH THIS DRAWING AND OTHER DETAILS.
ANY DISCREPANCIES IN DRAWING MUST BE REPORTED IMMEDIATELY TO PMCI/ARCHITECT FOR FINAL DECISION BEFORE EXECUTION.

S.NO	DATE	DRAWN	CHECKED	VERIFIED	REMARKS

REVISIONS

KEY PLAN

CLIENT	J D Centre of Art		PROJECT	J D Centre of Art, Bhubaneswar	
ARCHITECT	STUDIO VanRO		DRAWING	FIRE TRENCH - DETAIL SHEET-H	
STRUCTURAL CONSULTANT	Mahendra Raj Consultants Pvt. Ltd		SCALE	COMPUTER FILE	
MUSEUM DESIGN	Siddhartha Das Studio		DRAWN BY	MAHESH PRAKASH	CHECKED BY
SANITARY, ELECTRICAL, HVAC, FIRE FIGHTING CONSULTANT			DATE	26-06-2024	VIVEK NAMDEV
			DRAWING TITLE		



