

**02** Basement Plan  
Scale - 1:50

**NOTE:**  
THIS DRAWING IS A COPYRIGHT. IT IS THE PROPERTY OF STUDIO VANRO AND IS NOT TO BE REPRODUCED, COPIED, HANDED OVER TO A THIRD PARTY OR USED FOR ANY PURPOSE OTHER THAN THAT FOR WHICH IT HAS BEEN LOANED.


**GENERAL NOTES:**  
ALL DIMENSIONS INDICATED ARE IN MILLIMETER UNLESS MENTIONED OTHERWISE  
ALL DIMENSIONS ARE TO BE CROSS CHECKED AT SITE AND ANY DISCREPANCY SHALL BE BROUGHT TO NOTICE BEFORE EXECUTION.  
ALL SERVICE DRAWINGS SHALL BE READ IN CONJUNCTION WITH THIS DRAWING AND OTHER DETAILS.  
ANY DISCREPANCIES IN DRAWING MUST BE REPORTED IMMEDIATELY TO PMCI/ARCHITECT FOR FINAL DECISION BEFORE EXECUTION.


S.NO	DATE	DRAWN	CHECKED	VERIFIED	REMARKS
R0	07 12 16	D. PANCHAL	RRM	RRM	TENDER DRAWING

**REVISIONS**

**KEY PLAN**

<b>CLIENT</b> J D Centre of Art		<b>PROJECT</b> J D Centre of Art, Bhubaneswar	
<b>ARCHITECT</b> VASTU SHILPA Consultants/ STUDIO VanRO		<b>DRAWING</b> BASEMENT PLAN (HVAC)	
<b>STRUCTURAL CONSULTANT</b> Mahendra Raj Consultants Pvt. Ltd		<b>SCALE</b>	<b>COMPUTER FILE</b>
<b>MUSEUM DESIGN</b> Siddhartha Das Studio		<b>DRAWN BY</b> MAHESH PRAKASH	<b>CHECKED BY</b> RIZWAN
<b>SANITARY, ELECTRICAL, HVAC, FIRE FIGHTING CONSULTANT</b>		<b>DATE</b> 22-04-2024	<b>DRAWING TITLE</b>

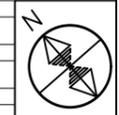

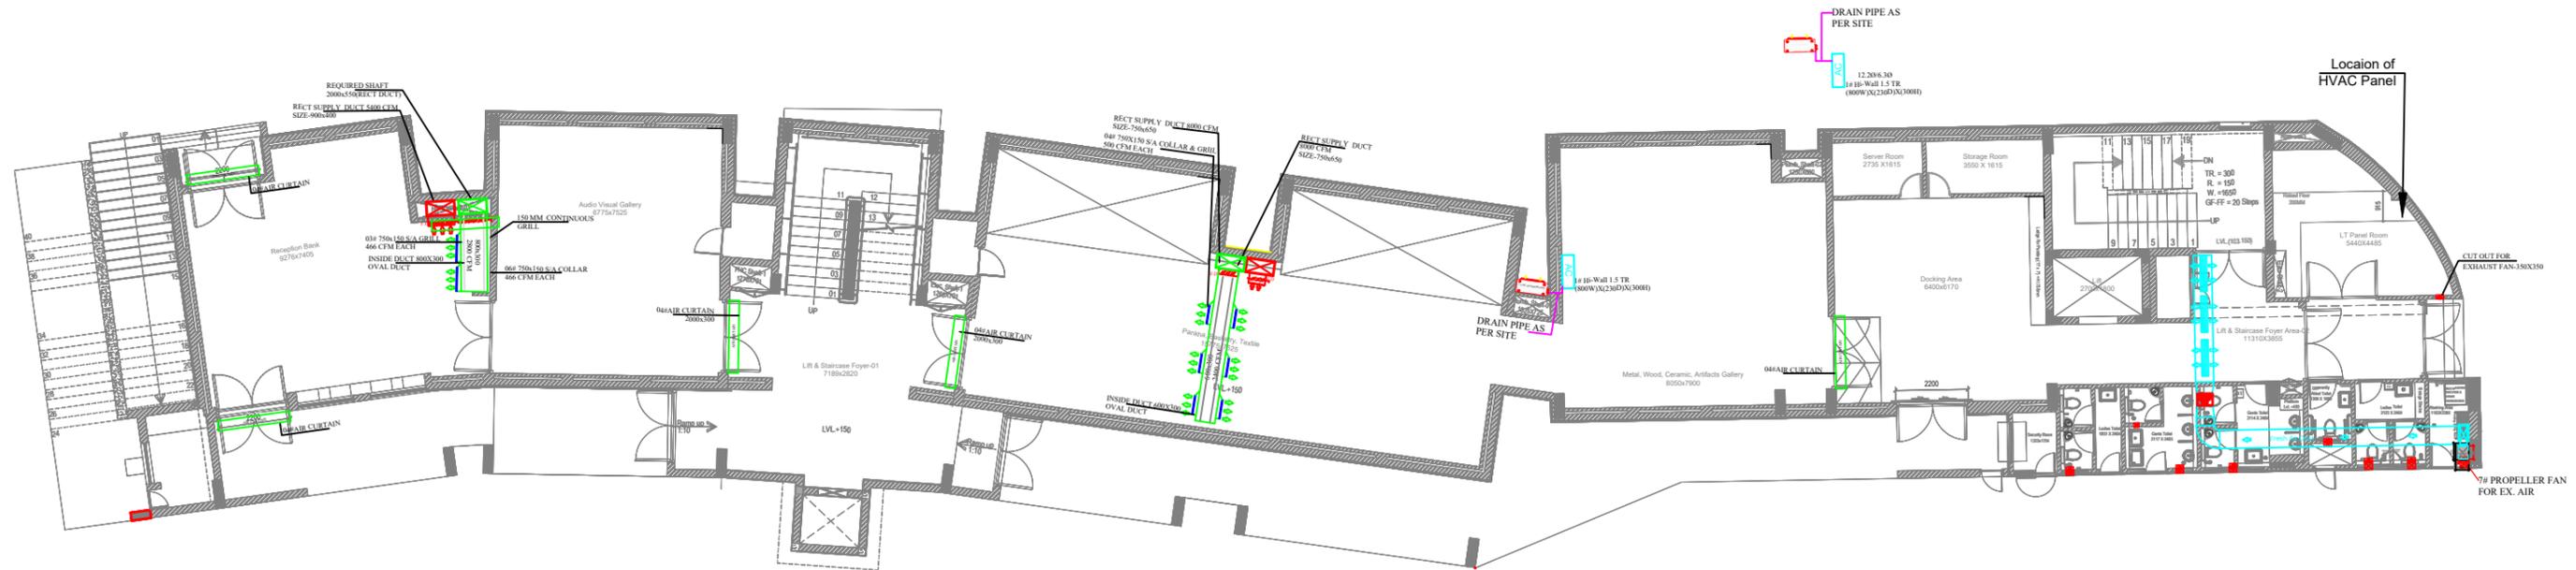

**03** Ground Floor Plan  
Scale - 1:100

**NOTE:**  
THIS DRAWING IS A COPYRIGHT. IT IS THE PROPERTY OF STUDIO VANRO AND IS NOT TO BE REPRODUCED, COPIED, HANDED OVER TO A THIRD PARTY OR USED FOR ANY PURPOSE OTHER THAN THAT FOR WHICH IT HAS BEEN LOANED.


**GENERAL NOTES:**  
ALL DIMENSIONS INDICATED ARE IN MILLIMETER UNLESS MENTIONED OTHERWISE  
ALL DIMENSIONS ARE TO BE CROSS CHECKED AT SITE AND ANY DISCREPANCY SHALL BE BROUGHT TO NOTICE BEFORE EXECUTION.  
ALL SERVICE DRAWINGS SHALL BE READ IN CONJUNCTION WITH THIS DRAWING AND OTHER DETAILS.  
ANY DISCREPANCIES IN DRAWING MUST BE REPORTED IMMEDIATELY TO PM/ARCHITECT FOR FINAL DECISION BEFORE EXECUTION.


S.NO	DATE	DRAWN	CHECKED	VERIFIED	REMARKS
R0	07 12 16	D. PANCHAL	RRM	RRM	TENDER DRAWING

**REVISIONS**

**KEY PLAN**

<b>CLIENT</b> J D Centre of Art		<b>PROJECT</b> J D Centre of Art, Bhubaneswar	
<b>ARCHITECT</b> VASTU SHILPA Consultants/ STUDIO VanRO		<b>DRAWING</b> GROUND FLOOR PLAN(HVAC)	
<b>STRUCTURAL CONSULTANT</b> Mahendra Raj Consultants Pvt. Ltd	<b>SCALE</b>	<b>COMPUTER FILE</b>	
<b>MUSEUM DESIGN</b> Siddhartha Das Studio	<b>DRAWN BY</b> MAHESH PRAKASH	<b>CHECKED BY</b> RIZWAN	
<b>SANITARY, ELECTRICAL, HVAC, FIRE FIGHTING CONSULTANT</b>	<b>DATE</b> 22-04-2024	<b>DRAWING TITLE</b>	

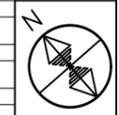

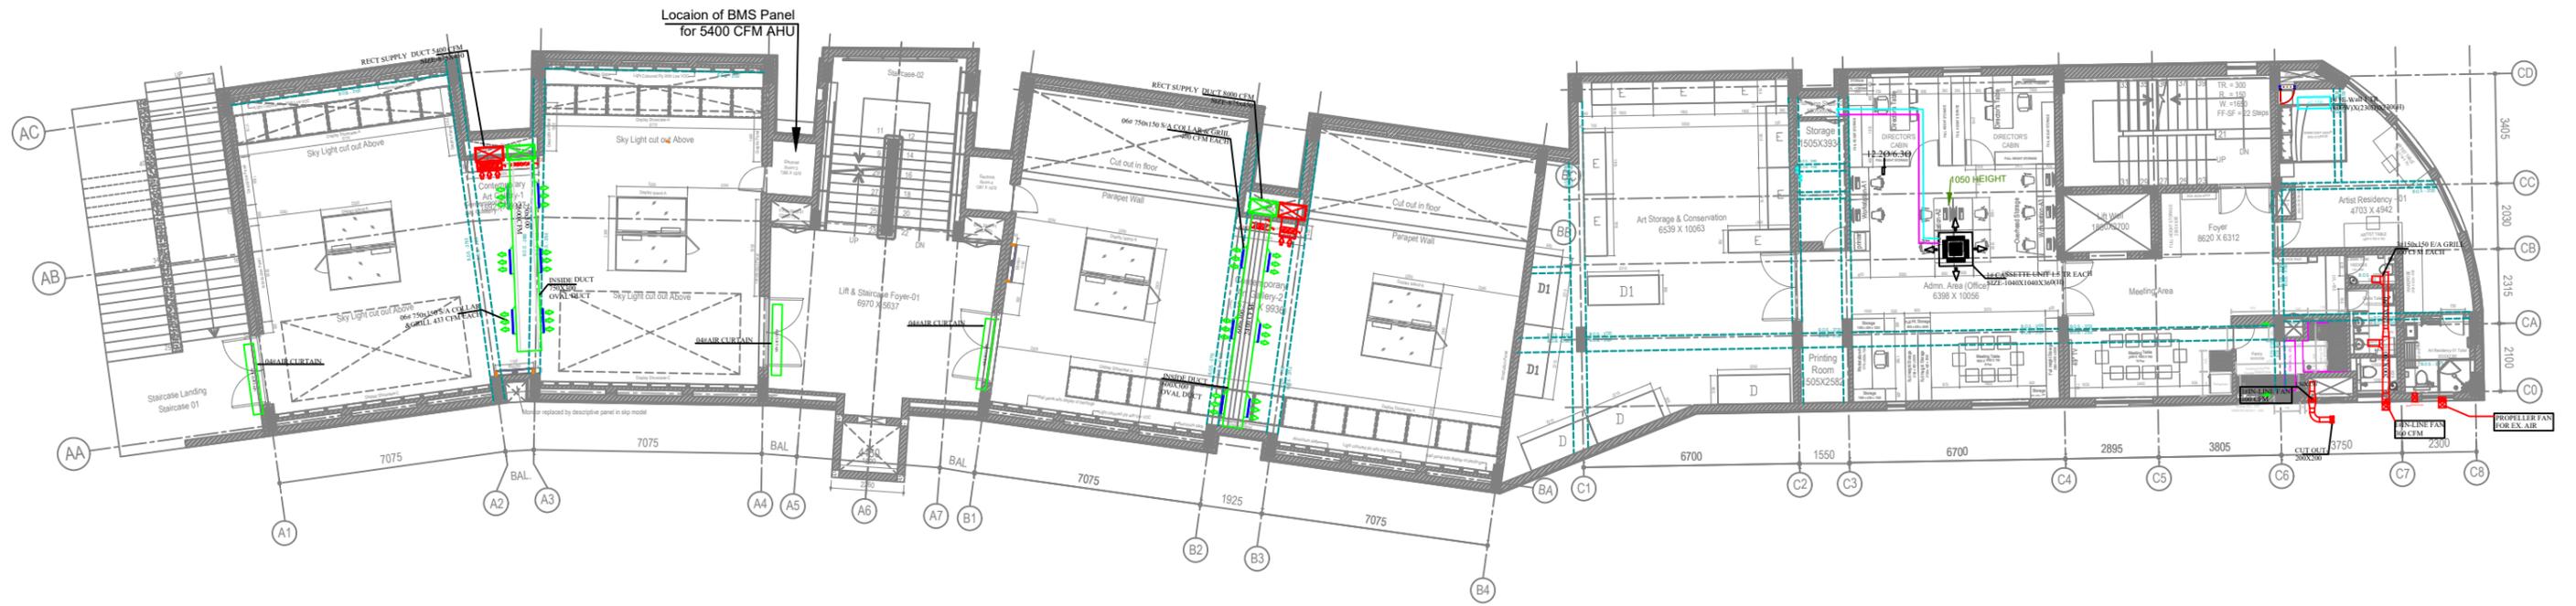

**04** First Floor Plan  
Scale - 1:100

**NOTE:**  
THIS DRAWING IS A COPYRIGHT. IT IS THE PROPERTY OF STUDIO VANRO AND IS NOT TO BE REPRODUCED, COPIED, HANDED OVER TO A THIRD PARTY OR USED FOR ANY PURPOSE OTHER THAN THAT FOR WHICH IT HAS BEEN LOANED.

**GENERAL NOTES:**  
ALL DIMENSIONS INDICATED ARE IN MILLIMETER UNLESS MENTIONED OTHERWISE  
ALL DIMENSIONS ARE TO BE CROSS CHECKED AT SITE AND ANY DISCREPANCY SHALL BE BROUGHT TO NOTICE BEFORE EXECUTION.  
ALL SERVICE DRAWINGS SHALL BE READ IN CONJUNCTION WITH THIS DRAWING AND OTHER DETAILS.  
ANY DISCREPANCIES IN DRAWING MUST BE REPORTED IMMEDIATELY TO PM/ARCHITECT FOR FINAL DECISION BEFORE EXECUTION.


S.NO	DATE	DRAWN	CHECKED	VERIFIED	REMARKS
R0	07 12 16	D. PANCHAL	RRM	RRM	TENDER DRAWING

**REVISIONS**

**KEY PLAN**

<b>CLIENT</b> J D Centre of Art		<b>PROJECT</b> J D Centre of Art, Bhubaneswar	
<b>ARCHITECT</b> VASTU SHILPA Consultants/ STUDIO VanRO		<b>DRAWING</b> FIRST FLOOR PLAN (HVAC)	
<b>STRUCTURAL CONSULTANT</b> Mahendra Raj Consultants Pvt. Ltd		<b>SCALE</b>	<b>COMPUTER FILE</b>
<b>MUSEUM DESIGN</b> Siddhartha Das Studio		<b>DRAWN BY</b> MAHESH PRAKASH	<b>CHECKED BY</b> RIZWAN
<b>SANITARY, ELECTRICAL, HVAC, FIRE FIGHTING CONSULTANT</b>		<b>DATE</b> 22-04-2024	<b>DRAWING TITLE</b>



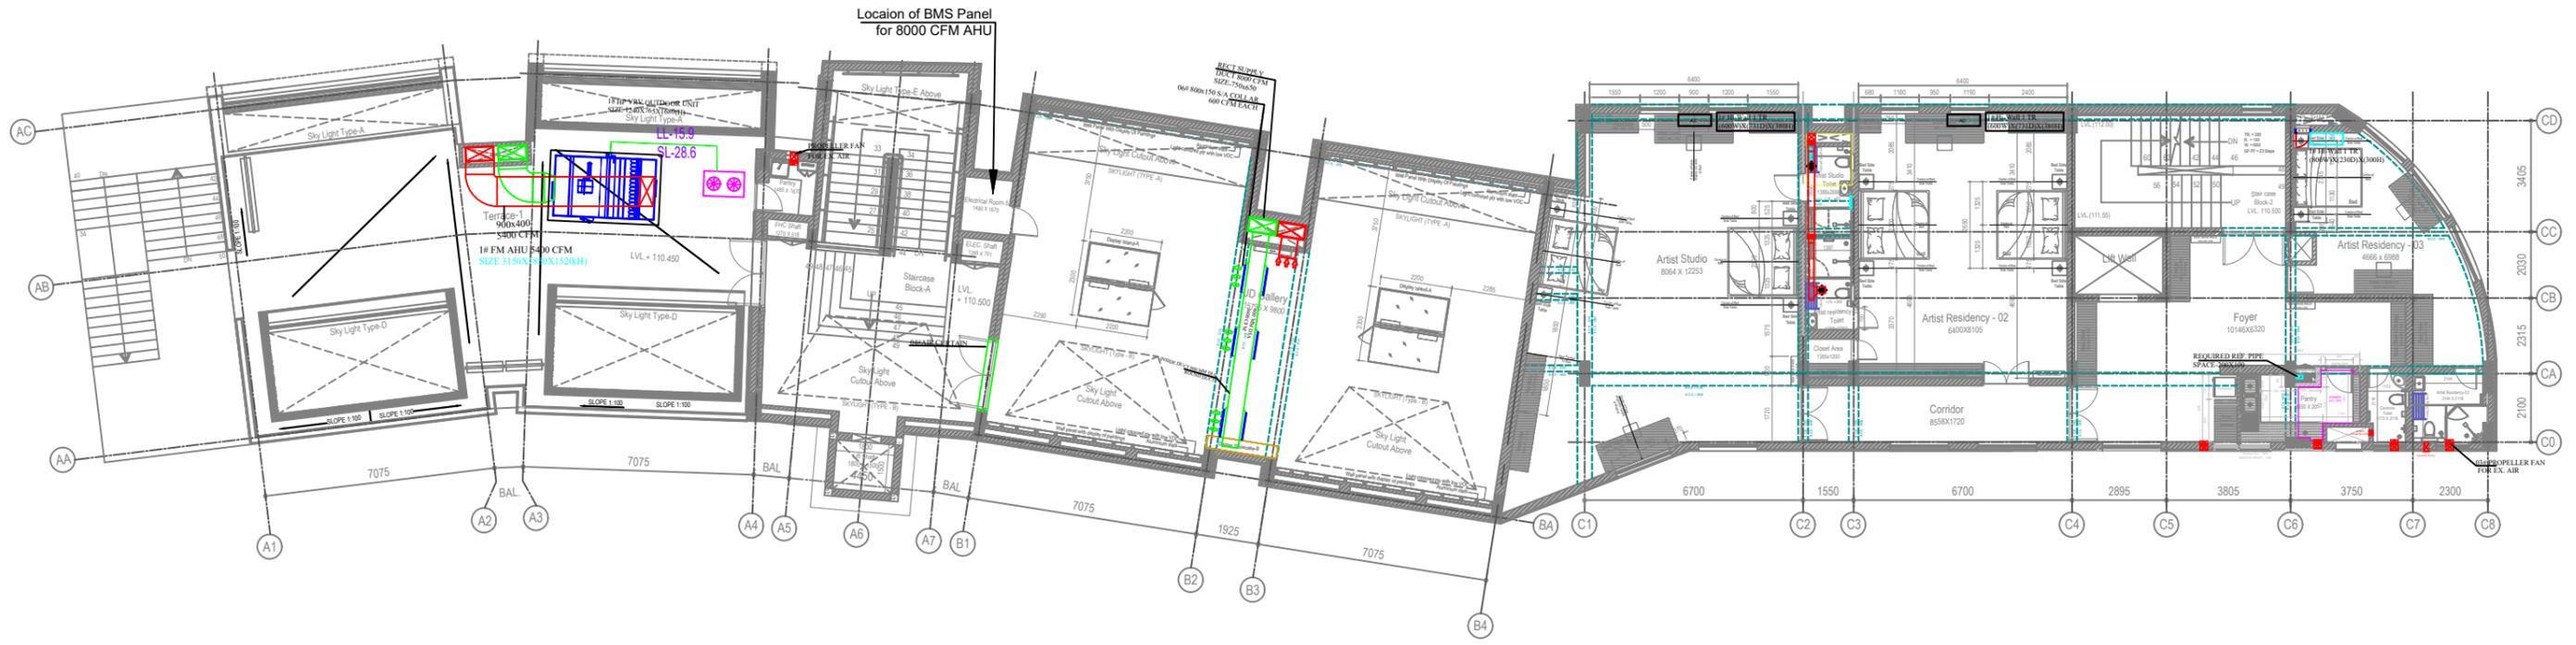

**05** Second Floor Plan  
Scale -1:100

**NOTE:**  
THIS DRAWING IS A COPYRIGHT. IT IS THE PROPERTY OF STUDIO VANRO AND IS NOT TO BE REPRODUCED, COPIED, HANDED OVER TO A THIRD PARTY OR USED FOR ANY PURPOSE OTHER THAN THAT FOR WHICH IT HAS BEEN LOANED.

**GENERAL NOTES:**  
ALL DIMENSIONS INDICATED ARE IN MILLIMETER UNLESS MENTIONED OTHERWISE  
ALL DIMENSIONS ARE TO BE CROSS CHECKED AT SITE AND ANY DISCREPANCY SHALL BE BROUGHT TO NOTICE BEFORE EXECUTION.  
ALL SERVICE DRAWINGS SHALL BE READ IN CONJUNCTION WITH THIS DRAWING AND OTHER DETAILS.  
ANY DISCREPANCIES IN DRAWING MUST BE REPORTED IMMEDIATELY TO PMCI/ARCHITECT FOR FINAL DECISION BEFORE EXECUTION.

S.NO	DATE	DRAWN	CHECKED	VERIFIED	REMARKS
R0	07 12 16	D. PANCHAL	RRM	RRM	TENDER DRAWING


**REVISIONS**

**KEY PLAN**

<b>CLIENT</b> J D Centre of Art		<b>PROJECT</b> J D Centre of Art, Bhubaneswar	
<b>ARCHITECT</b> VASTU SHILPA Consultants/ STUDIO VanRO		<b>DRAWING</b> SECOND FLOOR PLAN (HVAC)	
<b>STRUCTURAL CONSULTANT</b> Mahendra Raj Consultants Pvt. Ltd	<b>SCALE</b>	<b>COMPUTER FILE</b>	
<b>MUSEUM DESIGN</b> Siddhartha Das Studio	<b>DRAWN BY</b> MAHESH PRAKASH	<b>CHECKED BY</b> RIZWAN	
<b>SANITARY, ELECTRICAL, HVAC, FIRE FIGHTING CONSULTANT</b>	<b>DATE</b> 22-03-2024	<b>DRAWING TITLE</b>	





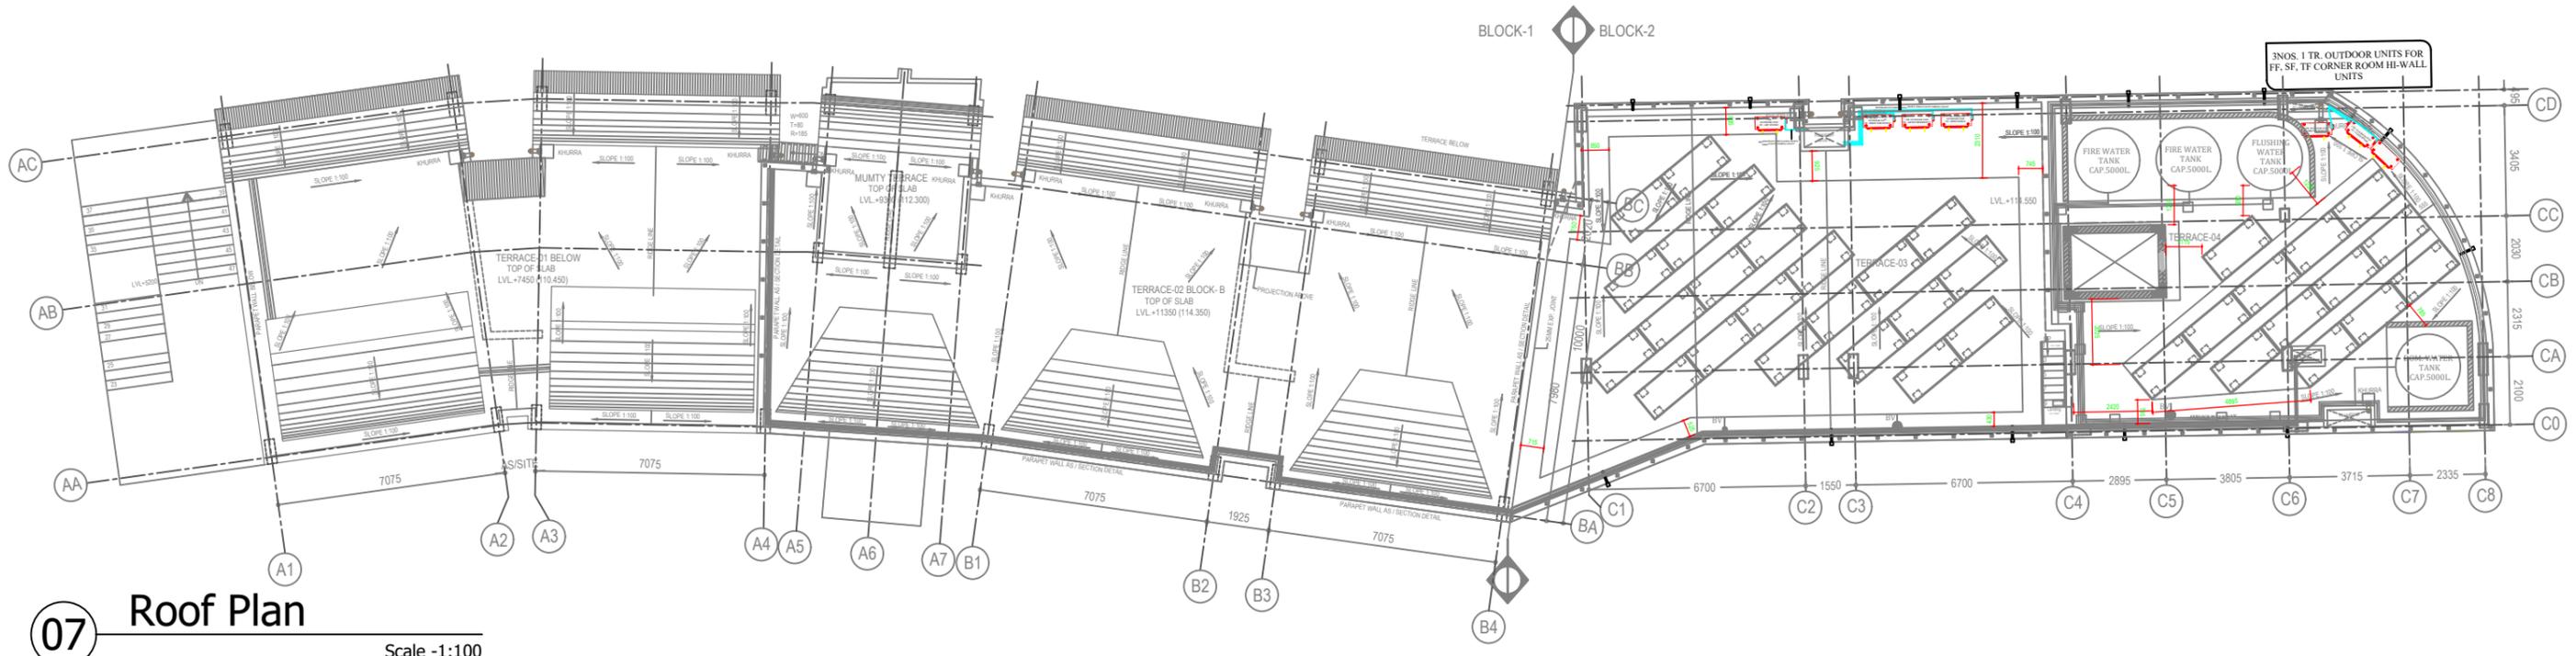

**07** Roof Plan  
Scale -1:100


**NOTE:**  
THIS DRAWING IS A COPYRIGHT. IT IS THE PROPERTY OF STUDIO VANRO AND IS NOT TO BE REPRODUCED, COPIED, HANDED OVER TO A THIRD PARTY OR USED FOR ANY PURPOSE OTHER THAN THAT FOR WHICH IT HAS BEEN LOANED.

**GENERAL NOTES:**  
ALL DIMENSIONS INDICATED ARE IN MILLIMETER UNLESS MENTIONED OTHERWISE  
ALL DIMENSIONS ARE TO BE CROSS CHECKED AT SITE AND ANY DISCREPANCY SHALL BE BROUGHT TO NOTICE BEFORE EXECUTION.  
ALL SERVICE DRAWINGS SHALL BE READ IN CONJUNCTION WITH THIS DRAWING AND OTHER DETAILS.  
ANY DISCREPANCIES IN DRAWING MUST BE REPORTED IMMEDIATELY TO PMCI/ARCHITECT FOR FINAL DECISION BEFORE EXECUTION.

S.NO	DATE	DRAWN	CHECKED	VERIFIED	REMARKS
R0	07 12 16	D. PANCHAL	RRM	RRM	TENDER DRAWING

REVISIONS	KEY PLAN
-----------	----------

CLIENT <b>J D Centre of Art</b>		PROJECT <b>J D Centre of Art, Bhubaneswar</b>	
ARCHITECT <b>VASTU SHILPA Consultants/ STUDIO VanRO</b>		DRAWING <b>ROOF PLAN</b>	
STRUCTURAL CONSULTANT <b>Mahendra Raj Consultants Pvt. Ltd</b>		SCALE	COMPUTER FILE
MUSEUM DESIGN <b>Siddhartha Das Studio</b>		DRAWN BY MAHESH PRAKASH	CHECKED BY RIZWAN
SANITARY, ELECTRICAL, HVAC, FIRE FIGHTING CONSULTANT		DATE 22-04-2024	DRAWING TITLE

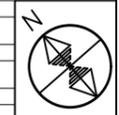











HVAC

As Built




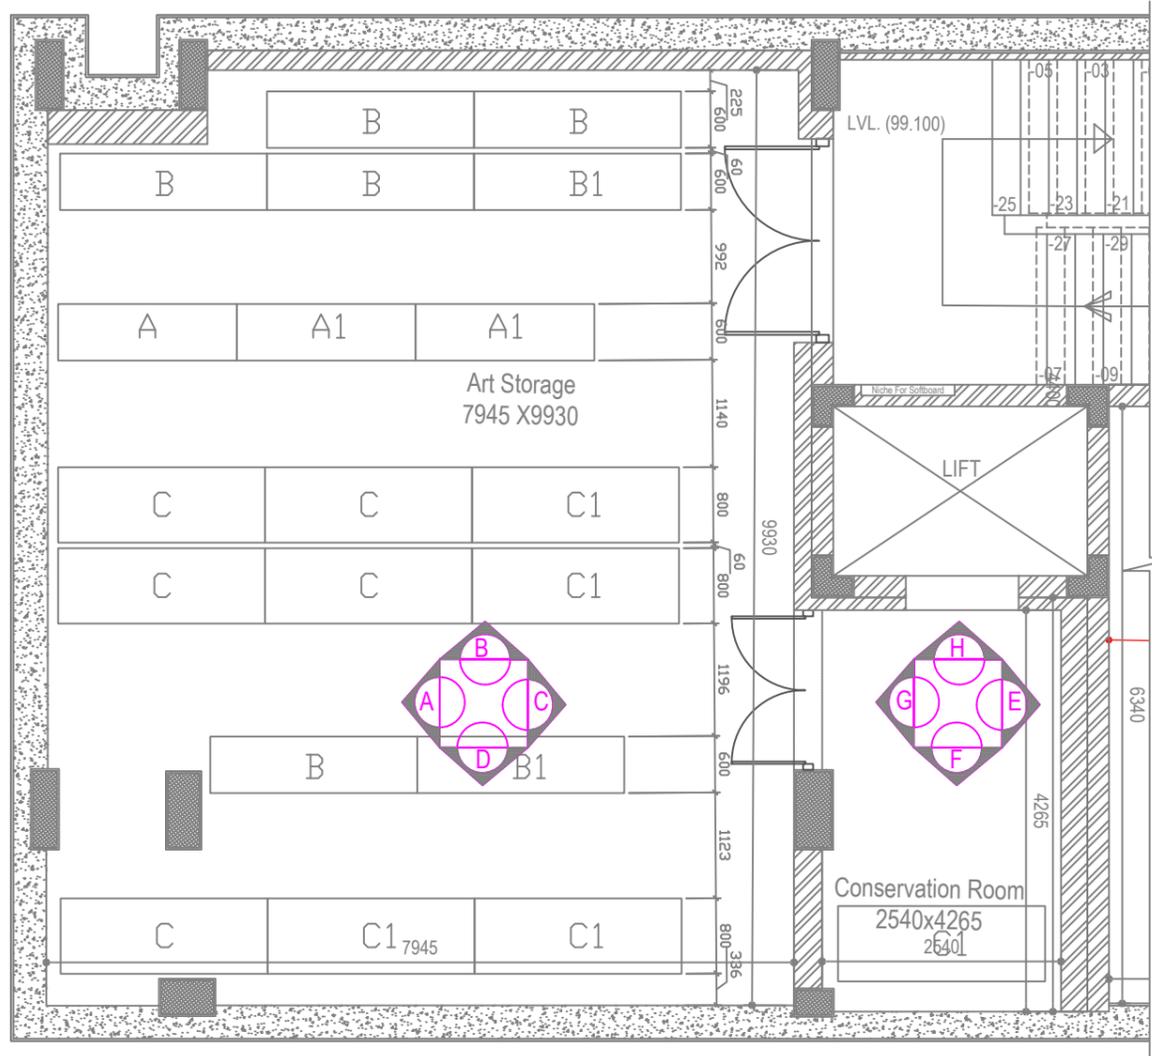


01 Art Storage & Conservation Room  
Basement  
Scale -1:75

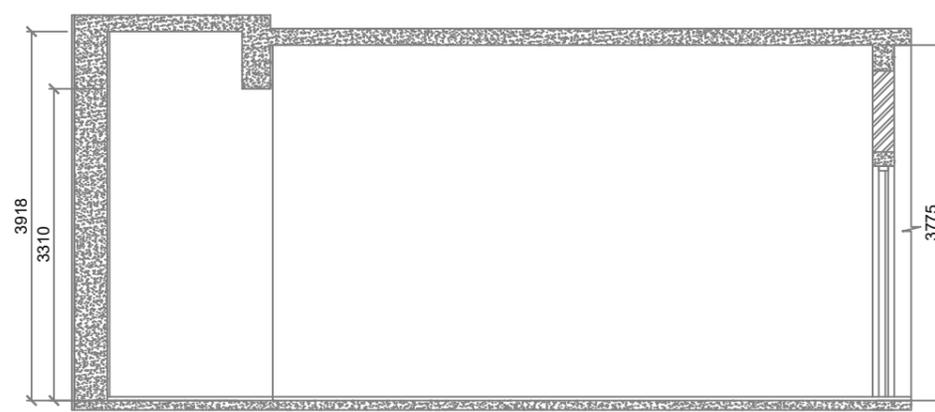


03 Sectional Elevation-B  
Scale -1:75

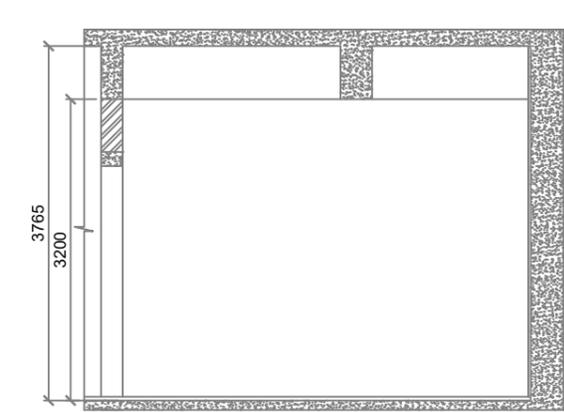

06 Sectional Elevation-E  
Scale -1:75

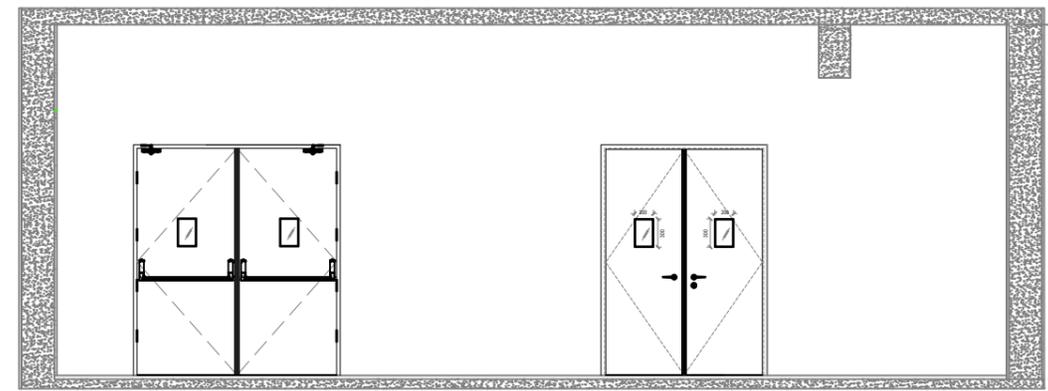

04 Sectional Elevation-C  
Scale -1:75

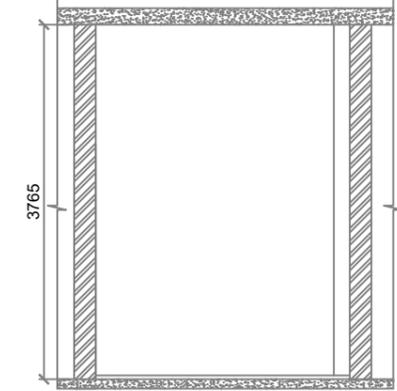


07 Sectional Elevation-F  
Scale -1:75




02 Sectional Elevation-A  
Scale -1:75



05 Sectional Elevation-D  
Scale -1:75

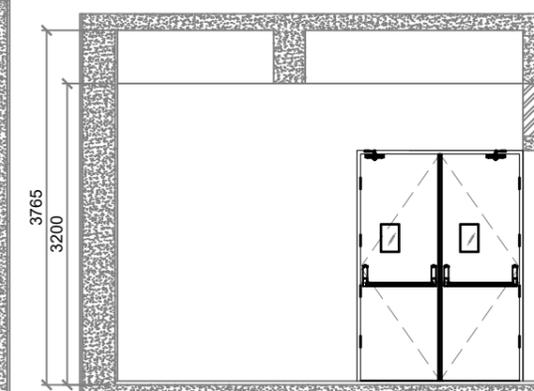

08 Sectional Elevation-G  
Scale -1:75


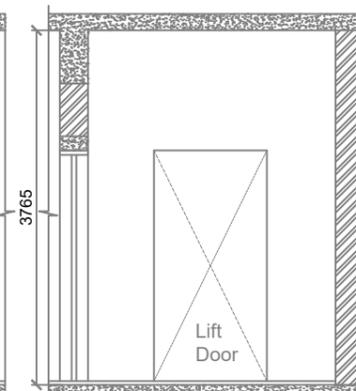


09 Sectional Elevation-H  
Scale -1:75


NOTE:  
THIS DRAWING IS A COPYRIGHT. IT IS THE PROPERTY OF STUDIO VANRO AND IS NOT TO BE REPRODUCED, COPIED, HANDED OVER TO A THIRD PARTY OR USED FOR ANY PURPOSE OTHER THAN THAT FOR WHICH IT HAS BEEN LOANED.

GENERAL NOTES:  
ALL DIMENSIONS INDICATED ARE IN MILLIMETER UNLESS MENTIONED OTHERWISE  
ALL DIMENSIONS ARE TO BE CROSS CHECKED AT SITE AND ANY DISCREPANCY SHALL BE BROUGHT TO NOTICE BEFORE EXECUTION.  
ALL SERVICE DRAWINGS SHALL BE READ IN CONJUNCTION WITH THIS DRAWING AND OTHER DETAILS.  
ANY DISCREPANCIES IN DRAWING MUST BE REPORTED IMMEDIATELY TO PMCI/ARCHITECT FOR FINAL DECISION BEFORE EXECUTION.

S.NO	DATE	DRAWN	CHECKED	VERIFIED	REMARKS

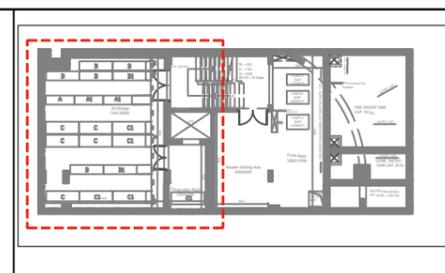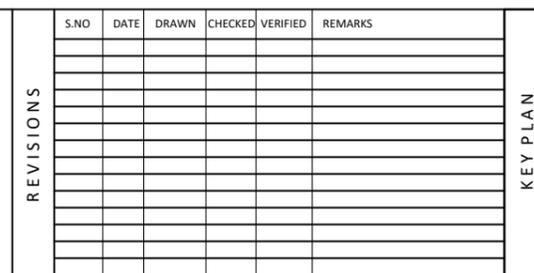


CLIENT	J D Centre of Art	PROJECT	J D Centre of Art, Bhubaneswar
ARCHITECT	VASTU SHILPA Consultants/ STUDIO VanRO	DRAWING	BASEMENT FLOOR PLAN ART STORAGE CONSERVATION HVAC AS BUILT
STRUCTURAL CONSULTANT	Mahendra Raj Consultants Pvt. Ltd	SCALE	A3@1:75
MUSEUM DESIGN	Siddhartha Das Studio	COMPUTER FILE	
SANITARY, ELECTRICAL, HVAC, FIRE FIGHTING CONSULTANT		DRAWN BY	MAHESH PRAKASH
		CHECKED BY	VIKESH NAMDEV
		DATE	07-05-2025
		DRAWING TITLE	

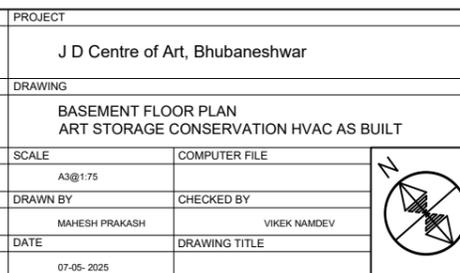





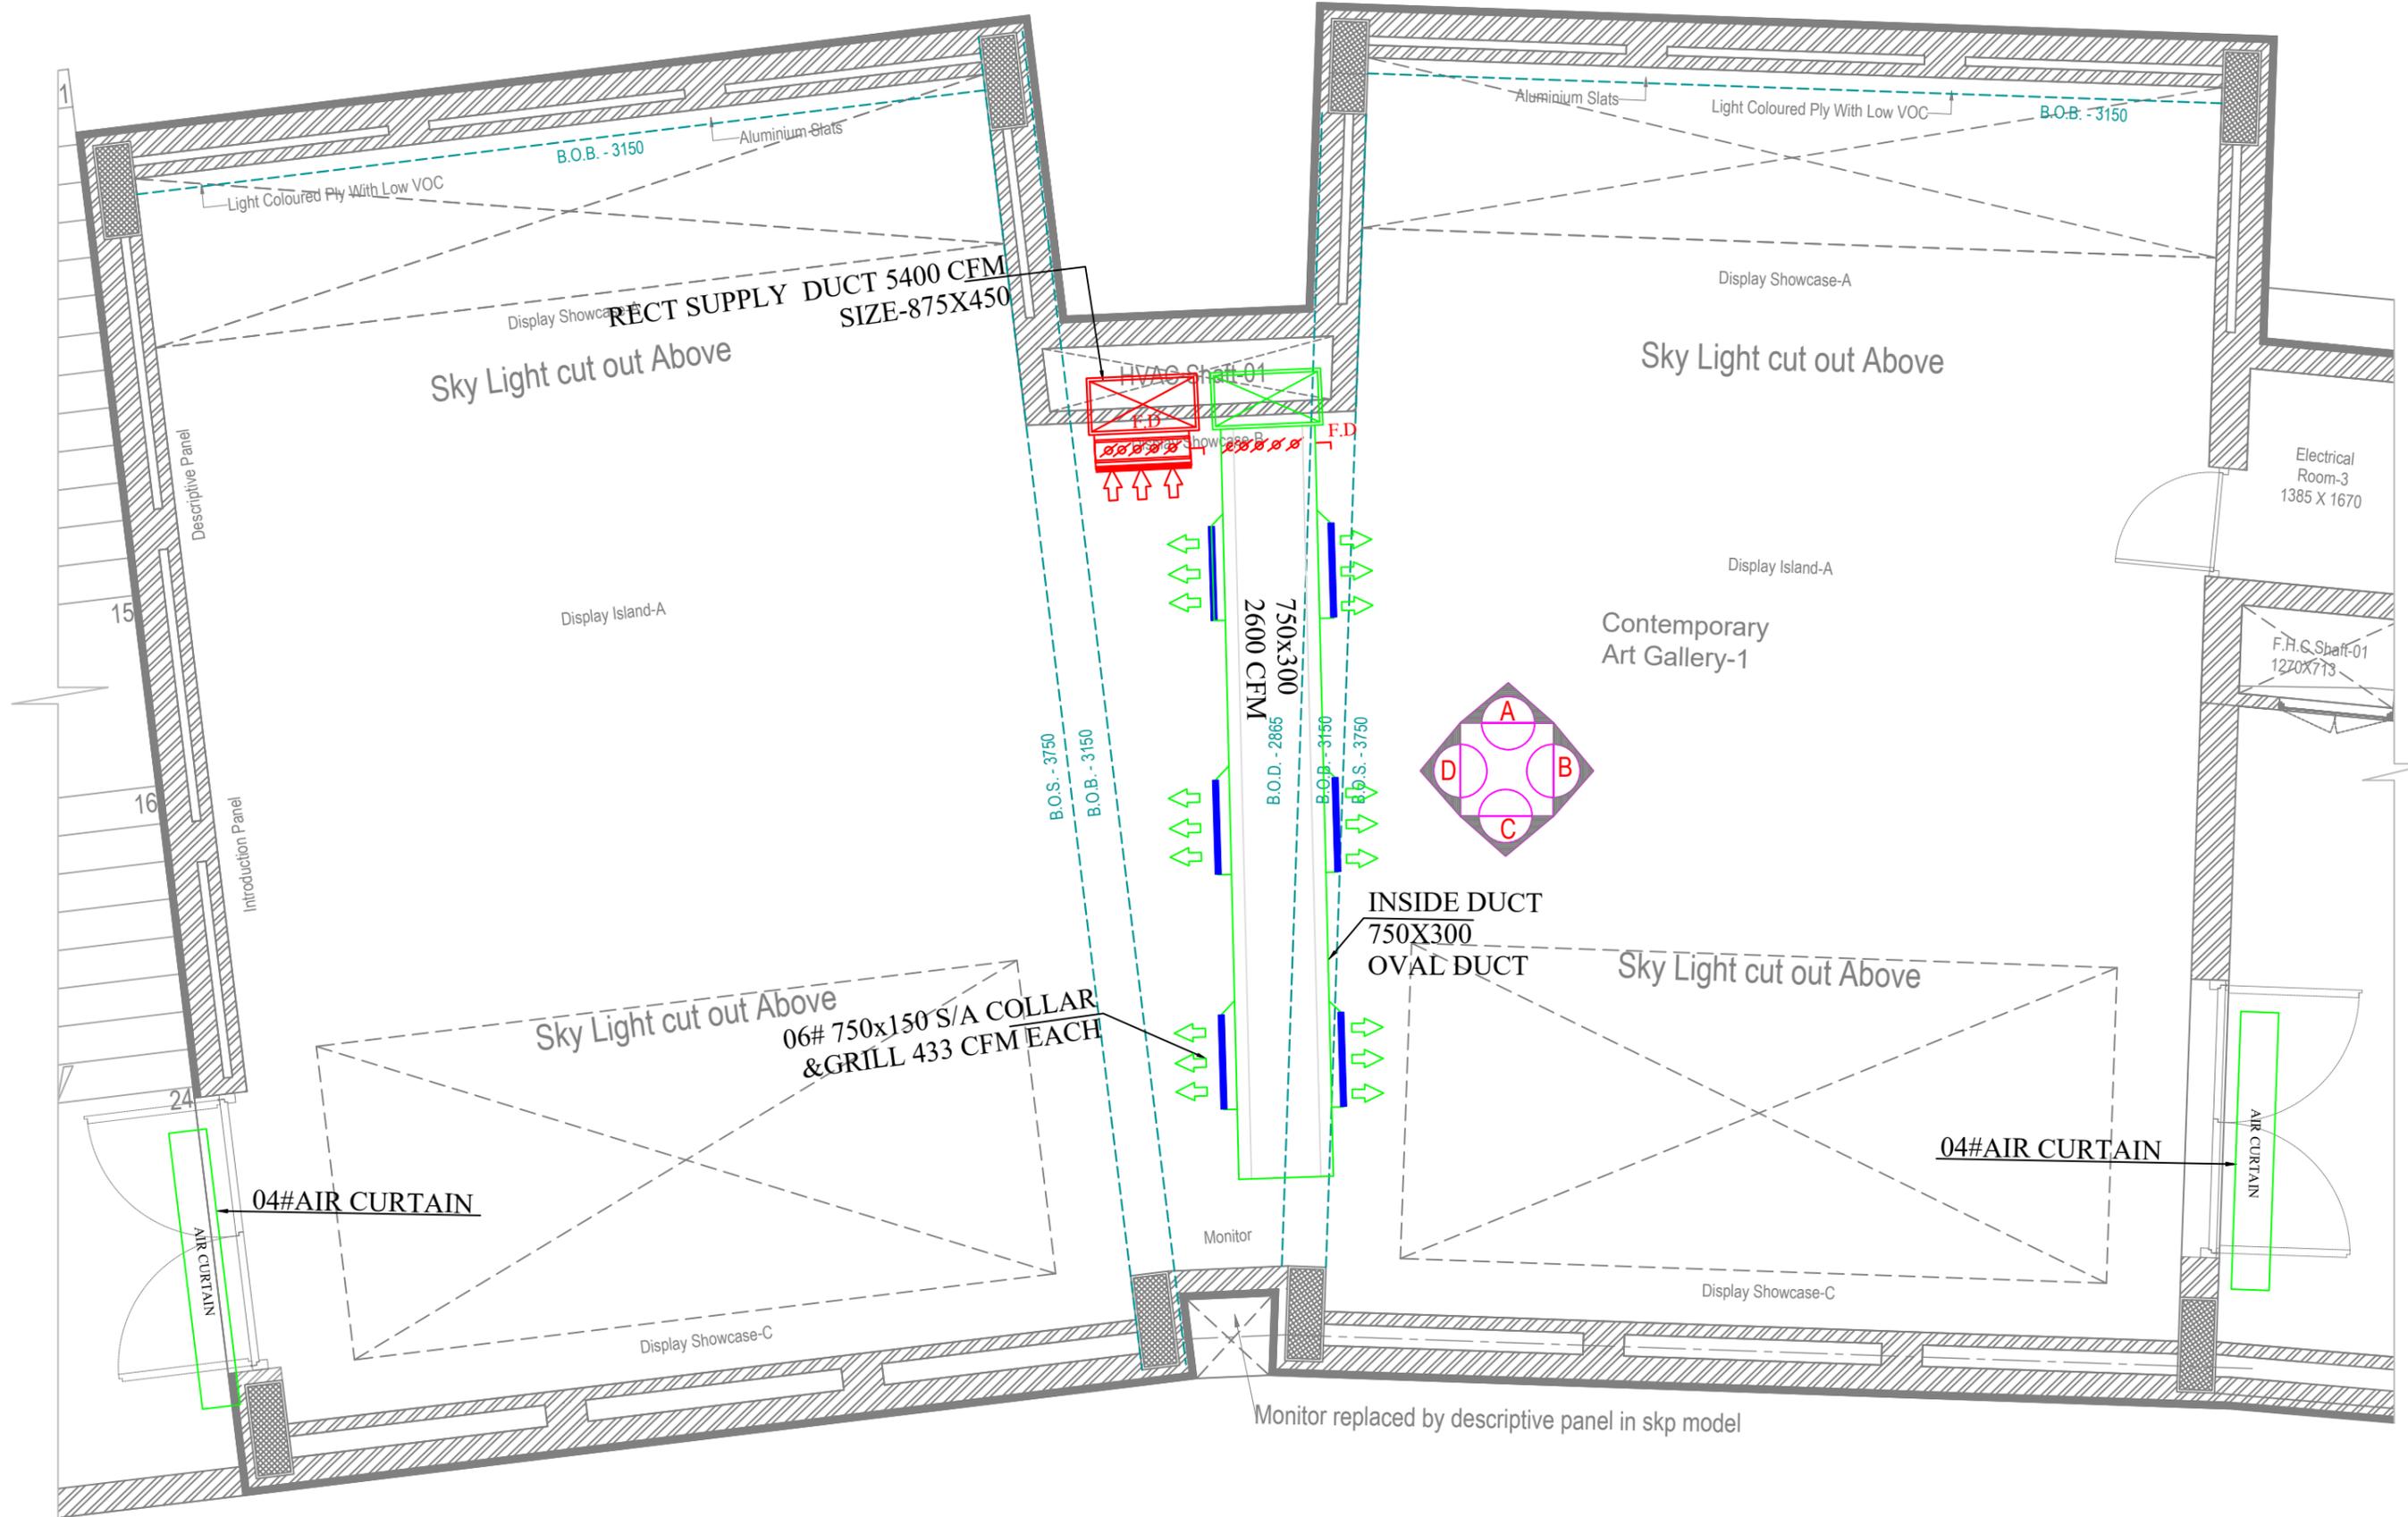


**01 Contemporary Art Gallery 01**  
**First Floor** Scale -1:50


**NOTE:**  
 THIS DRAWING IS A COPYRIGHT. IT IS THE PROPERTY OF STUDIO VANRO AND IS NOT TO BE REPRODUCED, COPIED, HANDED OVER TO A THIRD PARTY OR USED FOR ANY PURPOSE OTHER THAN THAT FOR WHICH IT HAS BEEN LOANED.

**GENERAL NOTES:**  
 ALL DIMENSIONS INDICATED ARE IN MILLIMETER UNLESS MENTIONED OTHERWISE  
 ALL DIMENSIONS ARE TO BE CROSS CHECKED AT SITE AND ANY DISCREPANCY SHALL BE BROUGHT TO NOTICE BEFORE EXECUTION.  
 ALL SERVICE DRAWINGS SHALL BE READ IN CONJUNCTION WITH THIS DRAWING AND OTHER DETAILS.  
 ANY DISCREPANCIES IN DRAWING MUST BE REPORTED IMMEDIATELY TO PMCI/ARCHITECT FOR FINAL DECISION BEFORE EXECUTION.

S.NO	DATE	DRAWN	CHECKED	VERIFIED	REMARKS

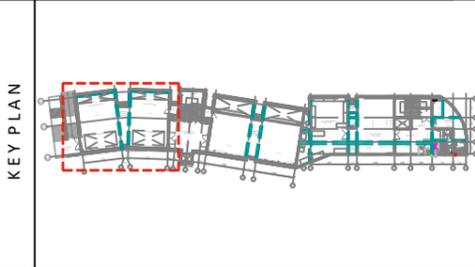

<b>CLIENT</b> J D Centre of Art		<b>PROJECT</b> J D Centre of Art, Bhubaneswar	
<b>ARCHITECT</b> VASTU SHILPA Consultants/ STUDIO VanRO		<b>DRAWING</b> FIRST FLOOR PLAN CONTEMPORARY ART GALLERY 01 HVAC AS BUILT	
<b>STRUCTURAL CONSULTANT</b> Mahendra Raj Consultants Pvt. Ltd		<b>SCALE</b> COMPUTER FILE	
<b>MUSEUM DESIGN</b> Siddhartha Das Studio		<b>DRAWN BY</b> MAHESH PRAKASH	<b>CHECKED BY</b> VIKEK NAMDEV
<b>SANITARY, ELECTRICAL, HVAC, FIRE FIGHTING CONSULTANT</b>		<b>DATE</b> 08-05-2025	<b>DRAWING TITLE</b>

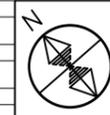














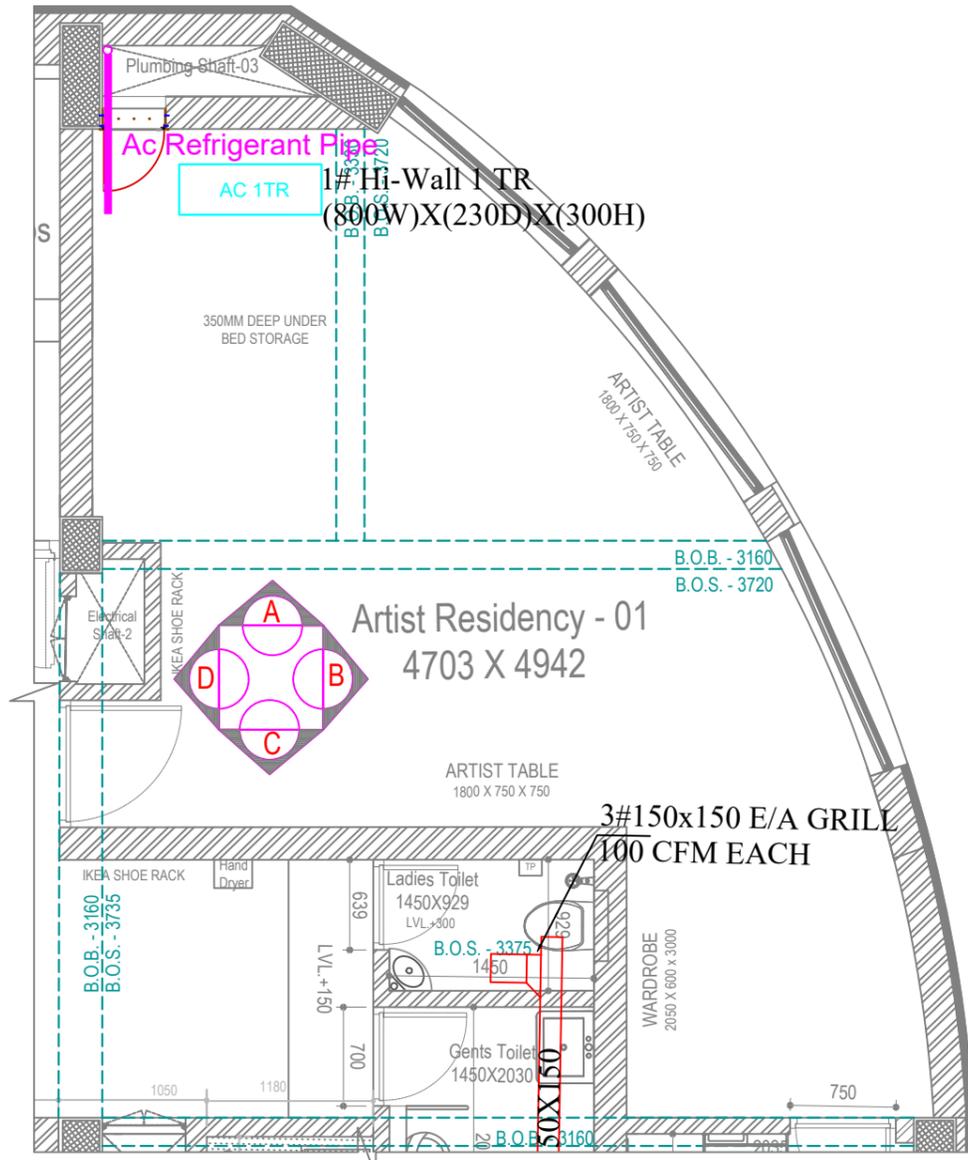


**01** Artist Residency-01  
First Floor  
Scale -1:50

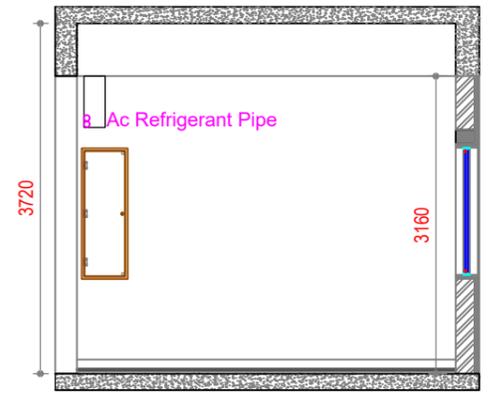


**02** Sectional Elevation-A  
Scale -1:75

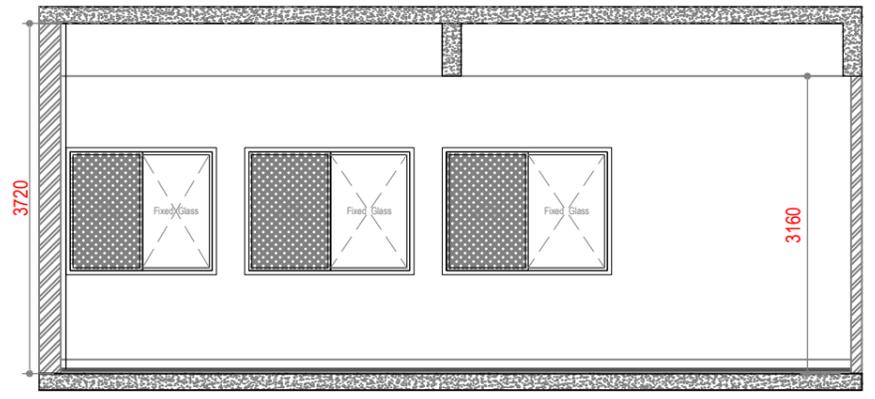

**03** Sectional Elevation-B  
Scale -1:75

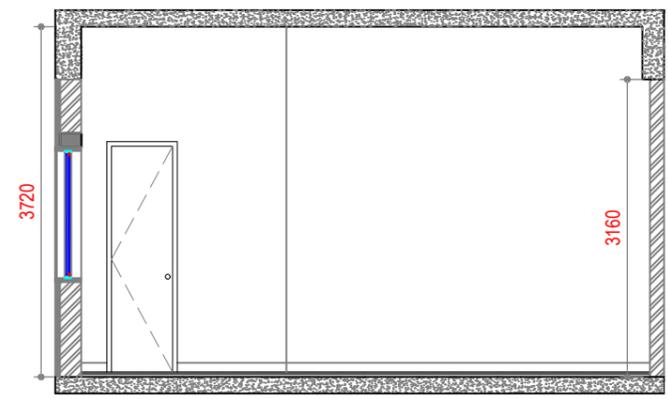

**04** Sectional Elevation-C  
Scale -1:75

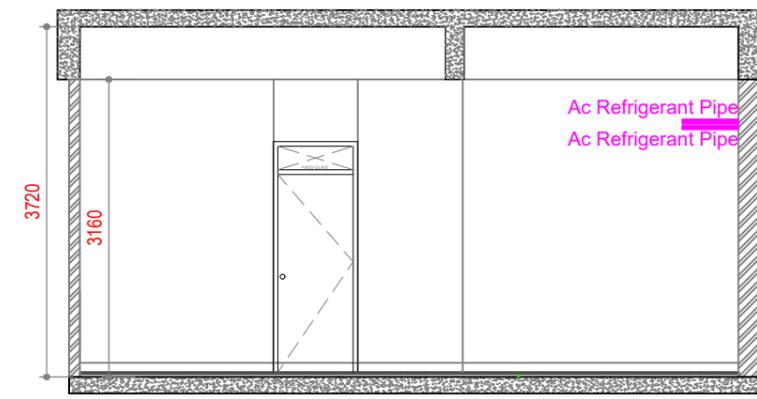

**04** Sectional Elevation-C  
Scale -1:75

**NOTE:**  
THIS DRAWING IS A COPYRIGHT. IT IS THE PROPERTY OF STUDIO VANRO AND IS NOT TO BE REPRODUCED, COPIED, HANDED OVER TO A THIRD PARTY OR USED FOR ANY PURPOSE OTHER THAN THAT FOR WHICH IT HAS BEEN LOANED.


**GENERAL NOTES:**  
ALL DIMENSIONS INDICATED ARE IN MILLIMETER UNLESS MENTIONED OTHERWISE  
ALL DIMENSIONS ARE TO BE CROSS CHECKED AT SITE AND ANY DISCREPANCY SHALL BE BROUGHT TO NOTICE BEFORE EXECUTION.  
ALL SERVICE DRAWINGS SHALL BE READ IN CONJUNCTION WITH THIS DRAWING AND OTHER DETAILS.  
ANY DISCREPANCIES IN DRAWING MUST BE REPORTED IMMEDIATELY TO PMCI/ARCHITECT FOR FINAL DECISION BEFORE EXECUTION.

S.NO	DATE	DRAWN	CHECKED	VERIFIED	REMARKS




CLIENT	J D Centre of Art
ARCHITECT	VASTU SHILPA Consultants/ STUDIO VanRO
STRUCTURAL CONSULTANT	Mahendra Raj Consultants Pvt. Ltd
MUSEUM DESIGN	Siddhartha Das Studio
SANITARY, ELECTRICAL, HVAC, FIRE FIGHTING CONSULTANT	


PROJECT	J D Centre of Art, Bhubaneswar
DRAWING	FIRST FLOOR PLAN ARTIST RESIDENCY-1 AS BUILT HVAC
SCALE	COMPUTER FILE
DRAWN BY	CHECKED BY
MAHESH PRAKASH	VIKEK NAMDEV
DATE	DRAWING TITLE
05-05-2024	

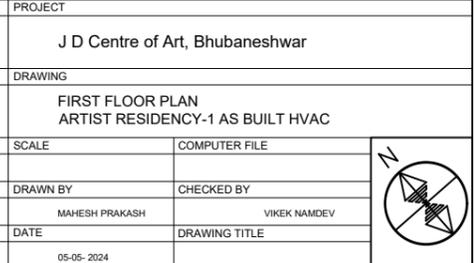




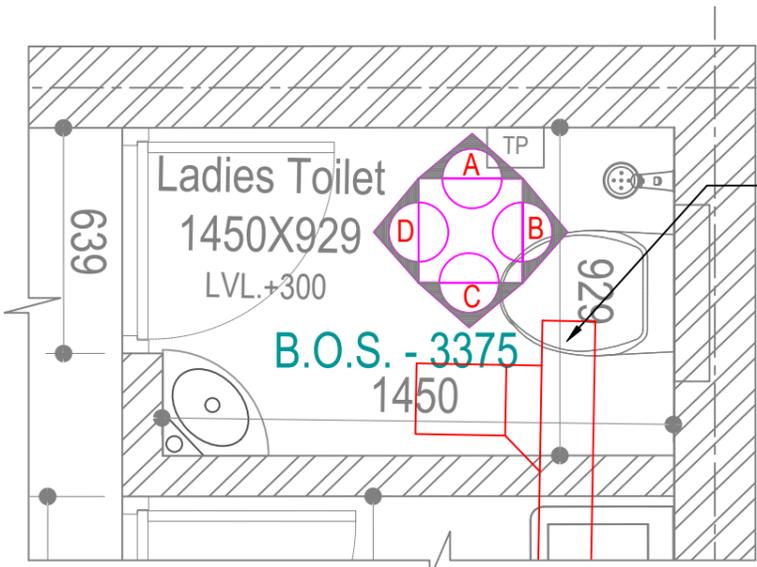


**01 Ladies Toilet**  
First Floor Scale -1:20

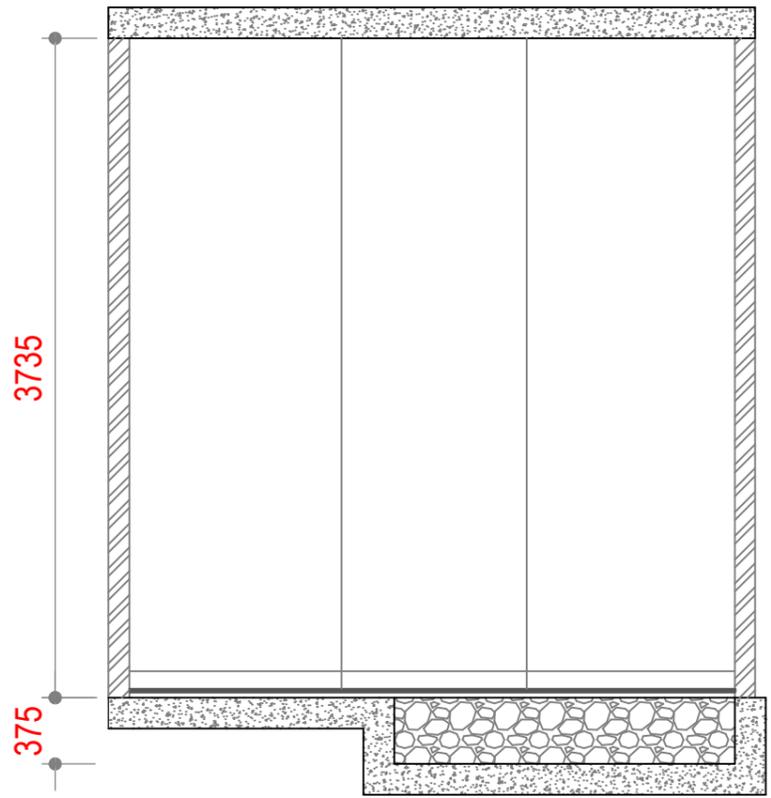


**02 Sectional Elevation-A**  
Scale -1:50

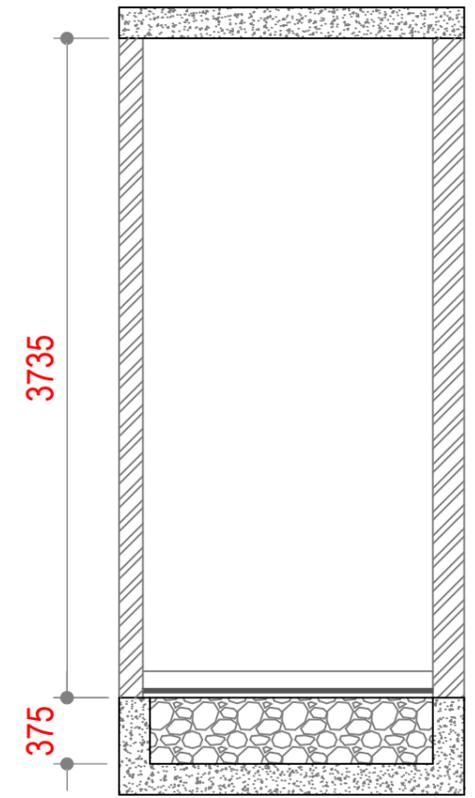

**03 Sectional Elevation-B**  
Scale -1:50

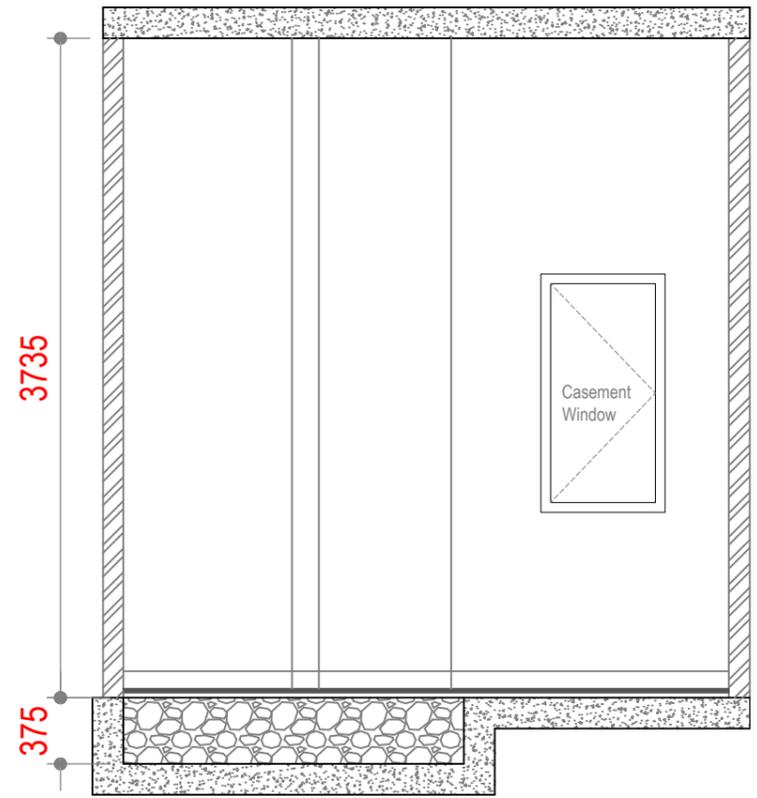

**04 Sectional Elevation-C**  
Scale -1:50

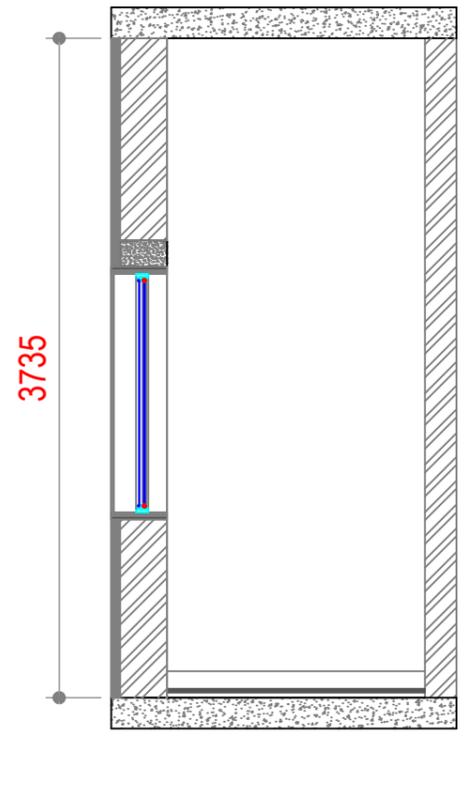


**05 Sectional Elevation-D**  
Scale -1:50

**NOTE:**  
THIS DRAWING IS A COPYRIGHT. IT IS THE PROPERTY OF STUDIO VANRO AND IS NOT TO BE REPRODUCED, COPIED, HANDED OVER TO A THIRD PARTY OR USED FOR ANY PURPOSE OTHER THAN THAT FOR WHICH IT HAS BEEN LOANED.

**GENERAL NOTES:**  
ALL DIMENSIONS INDICATED ARE IN MILLIMETER UNLESS MENTIONED OTHERWISE  
ALL DIMENSIONS ARE TO BE CROSS CHECKED AT SITE AND ANY DISCREPANCY SHALL BE BROUGHT TO NOTICE BEFORE EXECUTION.  
ALL SERVICE DRAWINGS SHALL BE READ IN CONJUNCTION WITH THIS DRAWING AND OTHER DETAILS.  
ANY DISCREPANCIES IN DRAWING MUST BE REPORTED IMMEDIATELY TO PMCI/ARCHITECT FOR FINAL DECISION BEFORE EXECUTION.


S.NO	DATE	DRAWN	CHECKED	VERIFIED	REMARKS

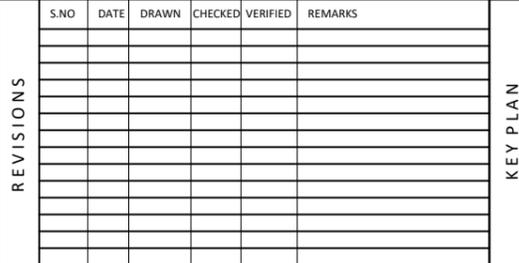


CLIENT	J D Centre of Art
ARCHITECT	VASTU SHILPA Consultants/ STUDIO VanRO
STRUCTURAL CONSULTANT	Mahendra Raj Consultants Pvt. Ltd
MUSEUM DESIGN	Siddhartha Das Studio
SANITARY, ELECTRICAL, HVAC, FIRE FIGHTING CONSULTANT	

PROJECT	J D Centre of Art, Bhubaneshwar
DRAWING	FIRST FLOOR PLAN LADIES TOILET AS BUILT HVAC
SCALE	COMPUTER FILE
DRAWN BY	CHECKED BY
MAHESH PRAKASH	VIKEK NAMDEV
DATE	DRAWING TITLE
05-05-2024	




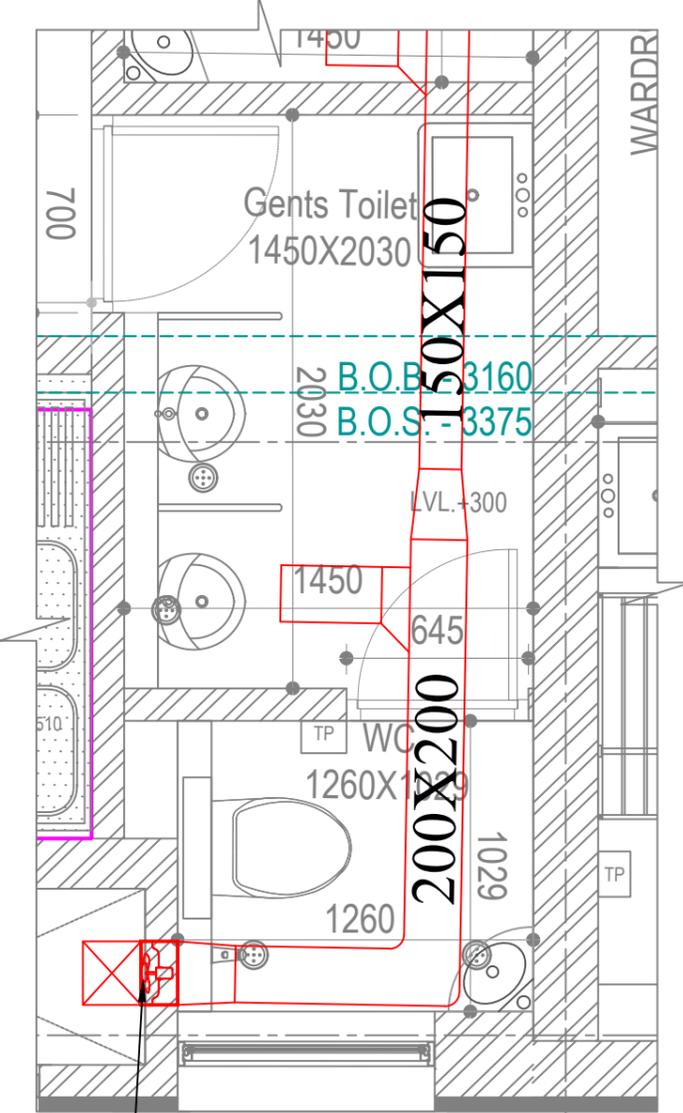


**01** Gents Toilet  
First Floor Scale -1:20

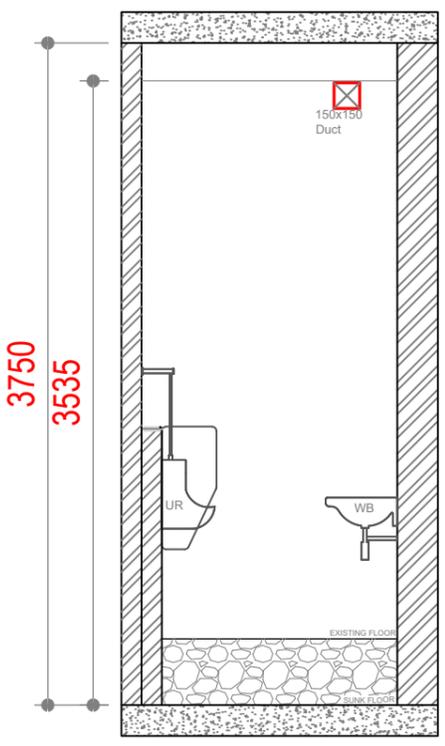


**02** Sectional Elevation-A  
Scale -1:40

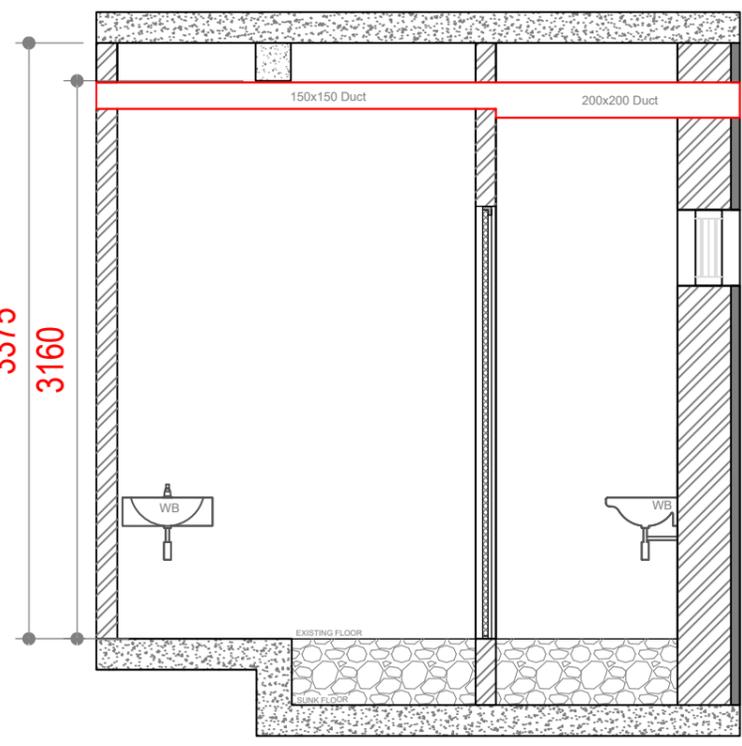


**03** Sectional Elevation-B  
Scale -1:40

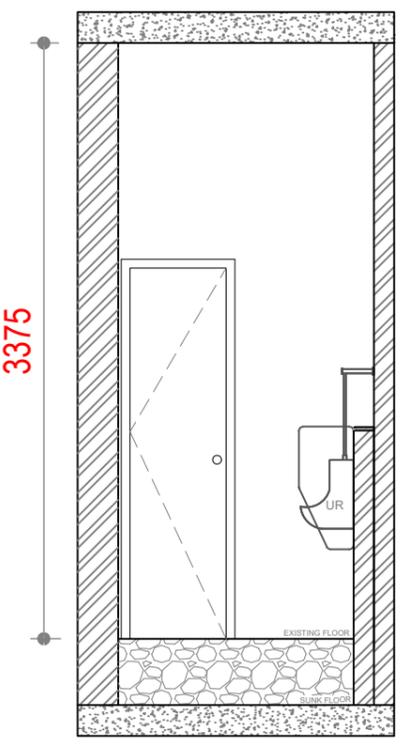


**04** Sectional Elevation-C  
Scale -1:40

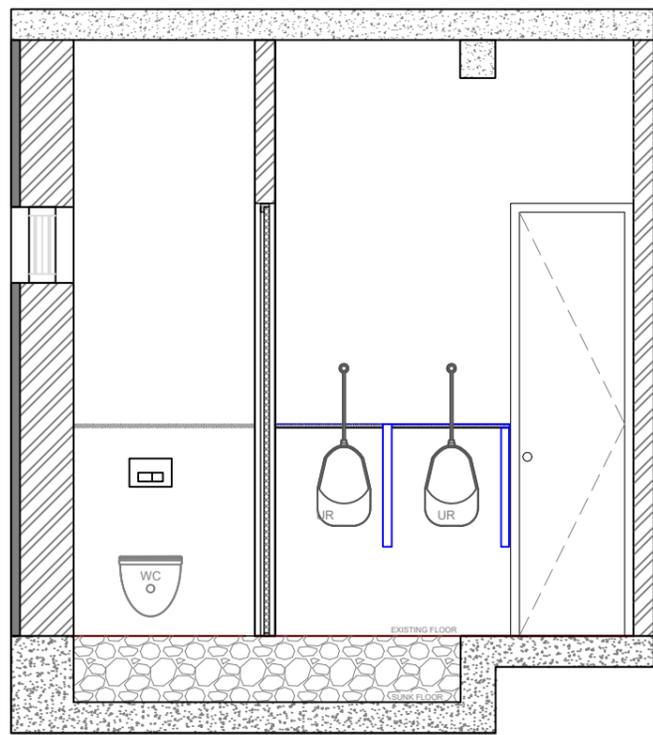

**05** Sectional Elevation-D  
Scale -1:40

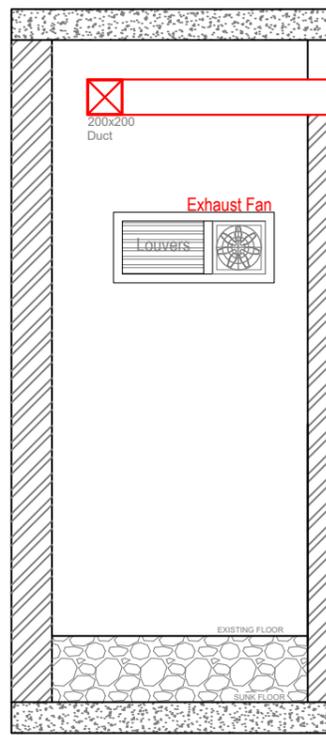

**6** Sectional Elevation-E  
Scale -1:40

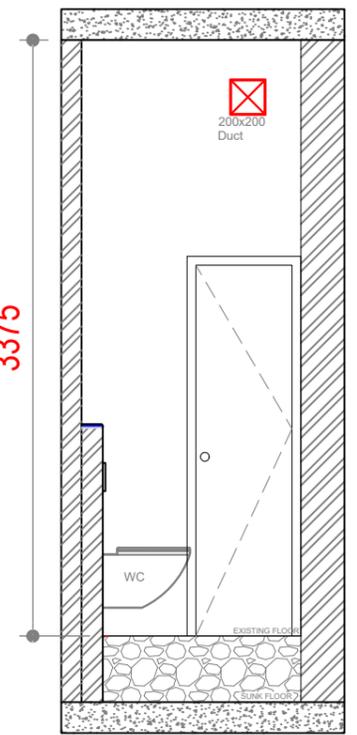


**7** Sectional Elevation-F  
Scale -1:40

**NOTE:**  
THIS DRAWING IS A COPYRIGHT. IT IS THE PROPERTY OF STUDIO VANRO AND IS NOT TO BE REPRODUCED, COPIED, HANDED OVER TO A THIRD PARTY OR USED FOR ANY PURPOSE OTHER THAN THAT FOR WHICH IT HAS BEEN LOANED.


**GENERAL NOTES:**  
ALL DIMENSIONS INDICATED ARE IN MILLIMETER UNLESS MENTIONED OTHERWISE  
ALL DIMENSIONS ARE TO BE CROSS CHECKED AT SITE AND ANY DISCREPANCY SHALL BE BROUGHT TO NOTICE BEFORE EXECUTION.  
ALL SERVICE DRAWINGS SHALL BE READ IN CONJUNCTION WITH THIS DRAWING AND OTHER DETAILS.  
ANY DISCREPANCIES IN DRAWING MUST BE REPORTED IMMEDIATELY TO PMCI/ARCHITECT FOR FINAL DECISION BEFORE EXECUTION.

S.NO	DATE	DRAWN	CHECKED	VERIFIED	REMARKS

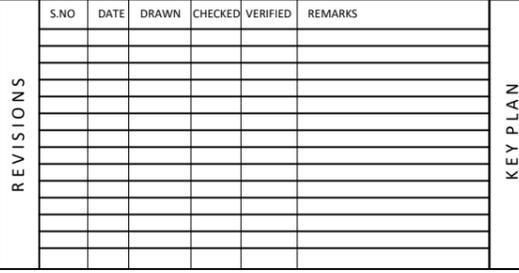

CLIENT	J D Centre of Art
ARCHITECT	VASTU SHILPA Consultants/ STUDIO VanRO
STRUCTURAL CONSULTANT	Mahendra Raj Consultants Pvt. Ltd
MUSEUM DESIGN	Siddhartha Das Studio
SANITARY, ELECTRICAL, HVAC, FIRE FIGHTING CONSULTANT	


PROJECT	J D Centre of Art, Bhubaneswar
DRAWING	FIRST FLOOR PLAN GENTS TOILET AS BUILT HVAC
SCALE	COMPUTER FILE
DRAWN BY	CHECKED BY
MAHESH PRAKASH	VIKEK NAMDEV
DATE	DRAWING TITLE
05-05-2024	

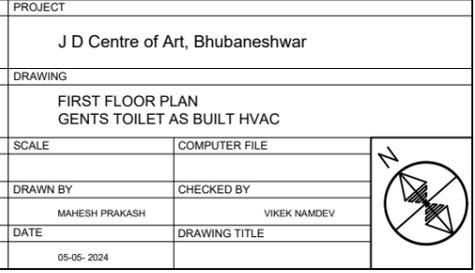



# HVAC SERVICES

## HVAC layout

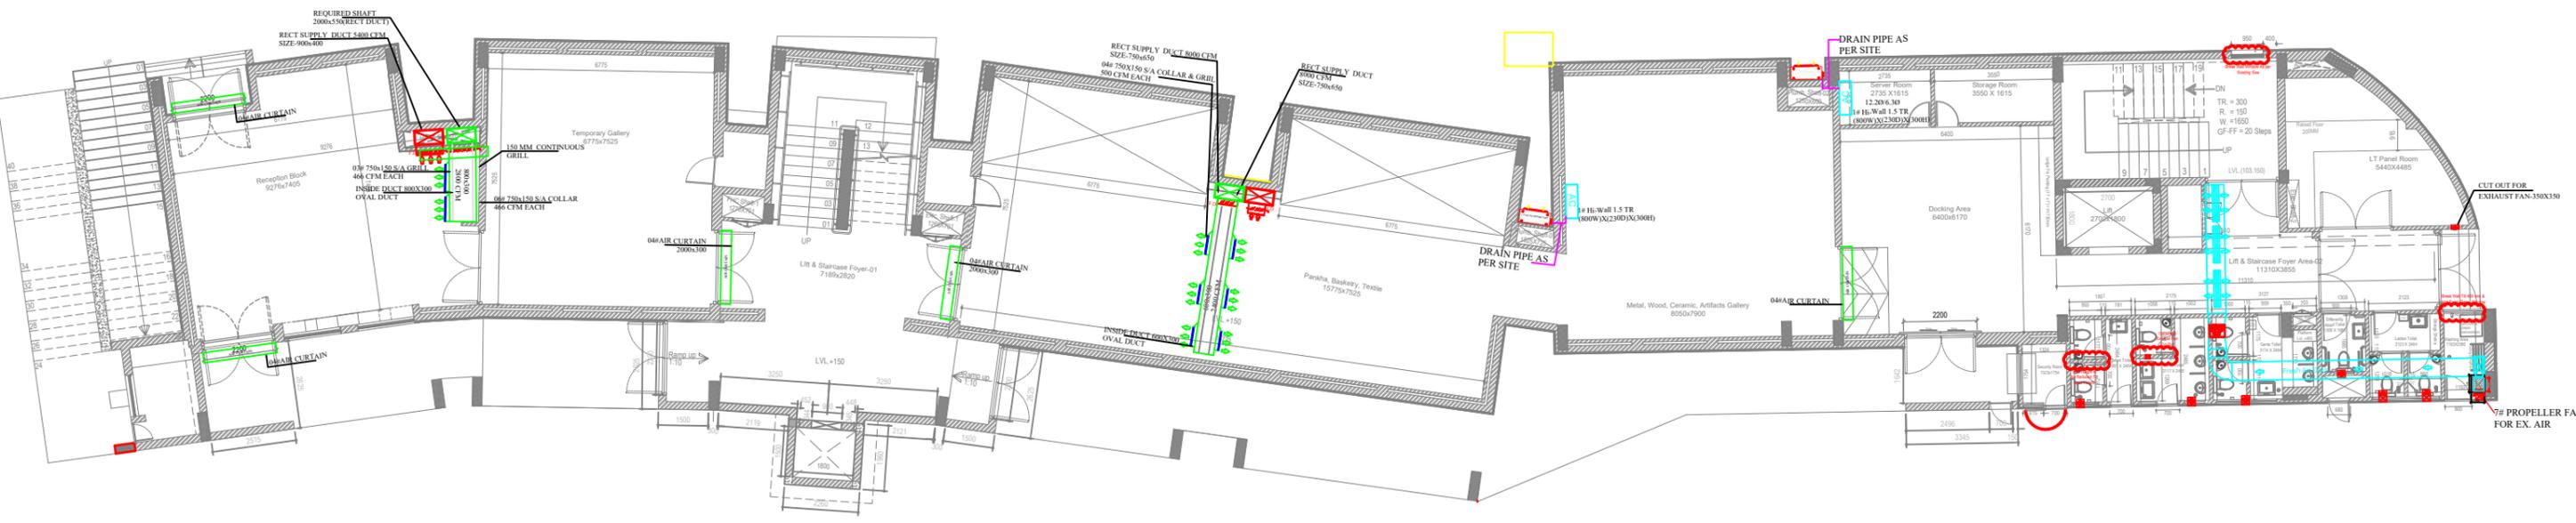


**01** Ground Floor Plan-HVAC Layout  
Scale -NTS


**NOTE:**  
THIS DRAWING IS A COPYRIGHT. IT IS THE PROPERTY OF STUDIO VANRO AND IS NOT TO BE REPRODUCED, COPIED, HANDED OVER TO A THIRD PARTY OR USED FOR ANY PURPOSE OTHER THAN THAT FOR WHICH IT HAS BEEN LOANED.


**GENERAL NOTES:**  
ALL DIMENSIONS INDICATED ARE IN MILLIMETER UNLESS MENTIONED OTHERWISE  
ALL DIMENSIONS ARE TO BE CROSS CHECKED AT SITE AND ANY DISCREPANCY SHALL BE BROUGHT TO NOTICE BEFORE EXECUTION.  
ALL SERVICE DRAWINGS SHALL BE READ IN CONJUNCTION WITH THIS DRAWING AND OTHER DETAILS.  
ANY DISCREPANCIES IN DRAWING MUST BE REPORTED IMMEDIATELY TO PMC/ARCHITECT FOR FINAL DECISION BEFORE EXECUTION.

S.NO	DATE	DRAWN	CHECKED	VERIFIED	REMARKS

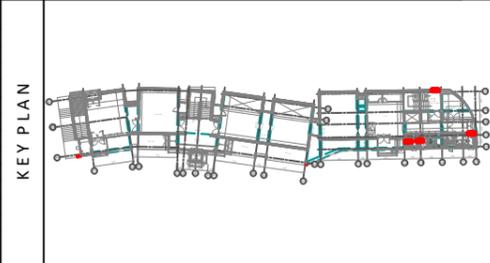


<b>CLIENT</b> J D Centre of Art		<b>PROJECT</b> J D Centre of Art, Bhubaneswar	
<b>ARCHITECT</b> VASTU SHILPA Consultants/ STUDIO VanRO		<b>DRAWING</b> GROUND FLOOR - HVAC LAYOUT	
<b>STRUCTURAL CONSULTANT</b> Mahendra Raj Consultants Pvt. Ltd		<b>SCALE</b>	<b>COMPUTER FILE</b>
<b>MUSEUM DESIGN</b> Siddhartha Das Studio		<b>DRAWN BY</b> MAHESH PRAKASH	<b>CHECKED BY</b> VIKEK NAMDEV
<b>SANITARY, ELECTRICAL, HVAC, FIRE FIGHTING CONSULTANT</b>		<b>DATE</b> 09-06-2025	<b>DRAWING TITLE</b>

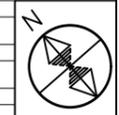


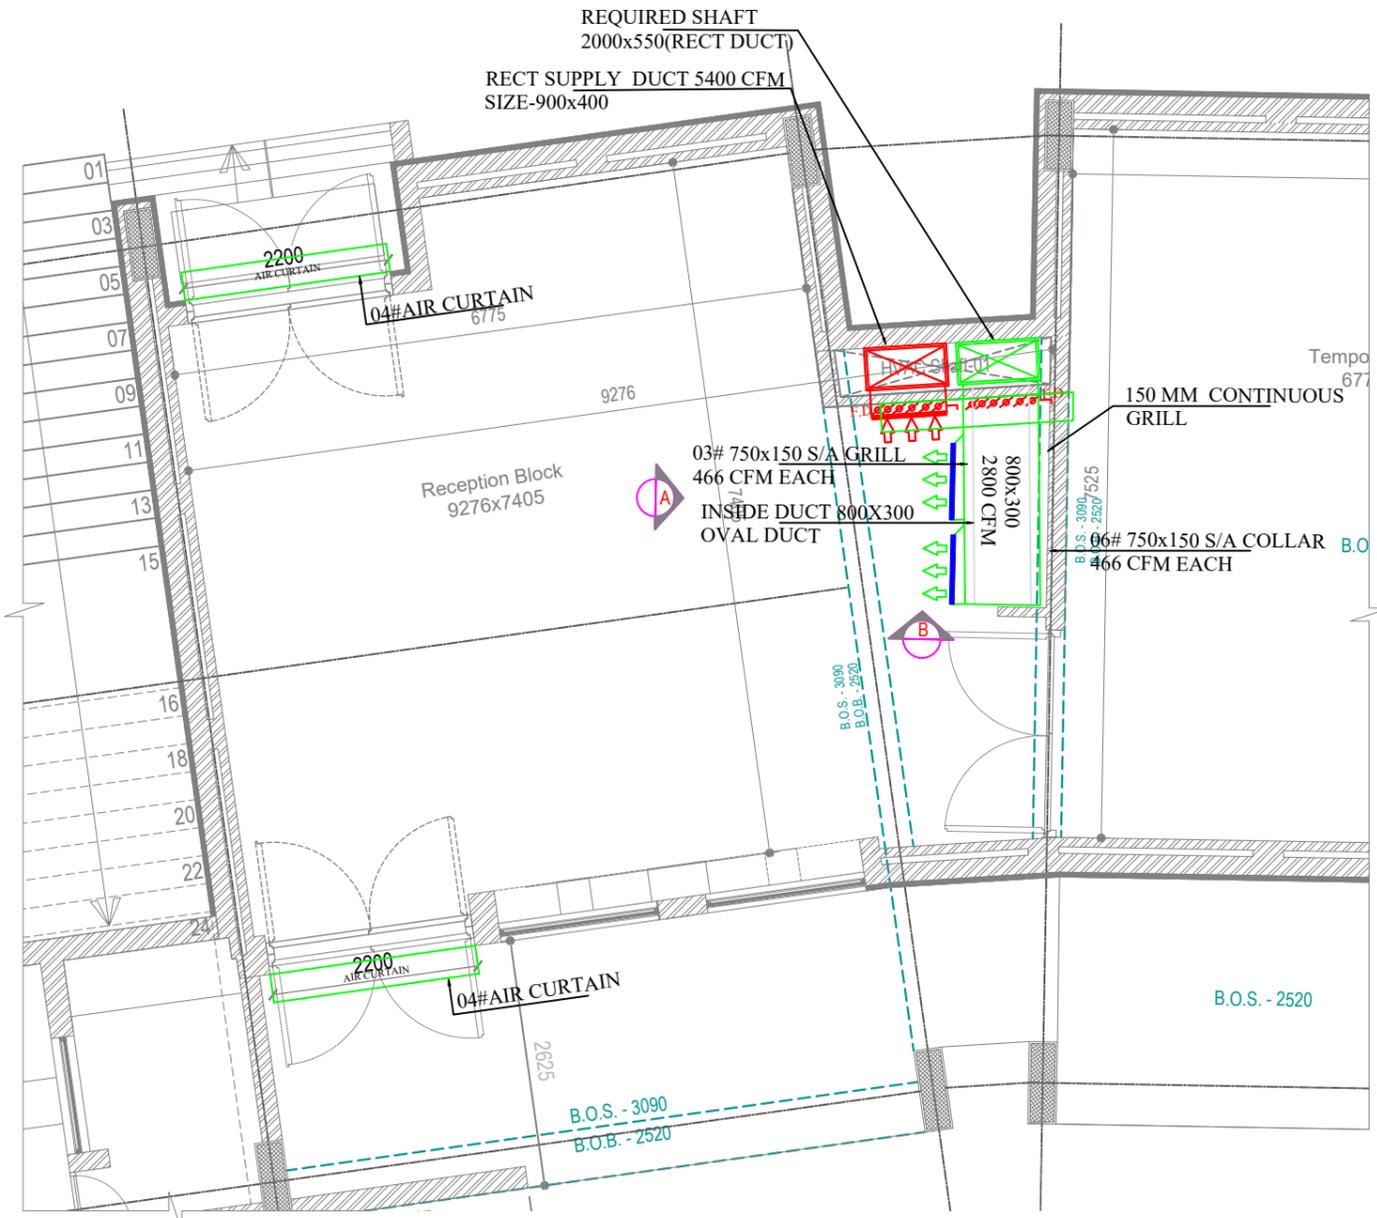

**01** Reception Block  
GROUND FLOOR Scale -1:75

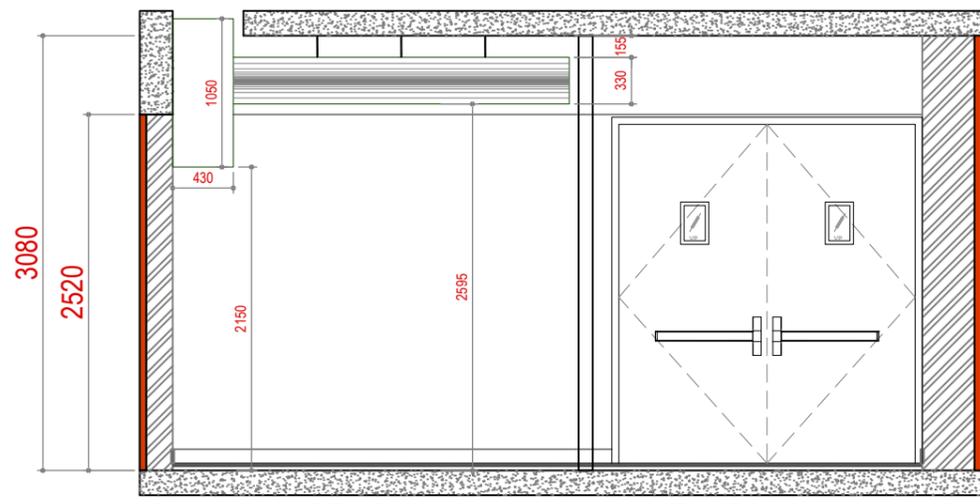

**02** Sectional Elevation-A  
Scale -1:50

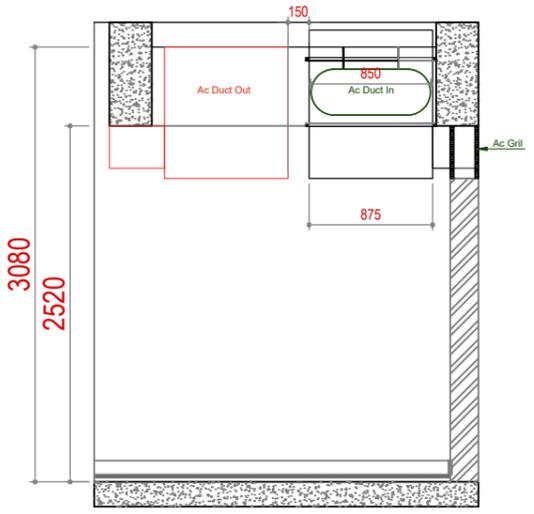


**03** Sectional Elevation-B  
Scale -1:50


**NOTE:**  
THIS DRAWING IS A COPYRIGHT. IT IS THE PROPERTY OF STUDIO VANRO AND IS NOT TO BE REPRODUCED, COPIED, HANDED OVER TO A THIRD PARTY OR USED FOR ANY PURPOSE OTHER THAN THAT FOR WHICH IT HAS BEEN LOANED.

**GENERAL NOTES:**  
ALL DIMENSIONS INDICATED ARE IN MILLIMETER UNLESS MENTIONED OTHERWISE  
ALL DIMENSIONS ARE TO BE CROSS CHECKED AT SITE AND ANY DISCREPANCY SHALL BE BROUGHT TO NOTICE BEFORE EXECUTION.  
ALL SERVICE DRAWINGS SHALL BE READ IN CONJUNCTION WITH THIS DRAWING AND OTHER DETAILS.  
ANY DISCREPANCIES IN DRAWING MUST BE REPORTED IMMEDIATELY TO PMCI/ARCHITECT FOR FINAL DECISION BEFORE EXECUTION.


S.NO	DATE	DRAWN	CHECKED	VERIFIED	REMARKS

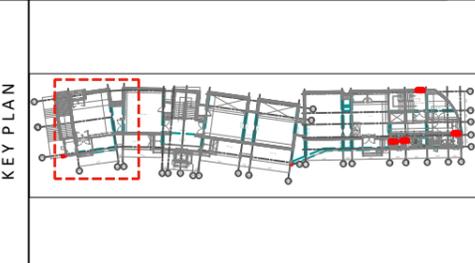

CLIENT	J D Centre of Art	PROJECT	J D Centre of Art, Bhubaneswar
ARCHITECT	VASTU SHILPA Consultants/ STUDIO VanRO	DRAWING	GROUND FLOOR PLAN RECEPTION BLOCK HVAC AS BUILT
STRUCTURAL CONSULTANT	Mahendra Raj Consultants Pvt. Ltd	SCALE	COMPUTER FILE
MUSEUM DESIGN	Siddhartha Das Studio	DRAWN BY	CHECKED BY
SANITARY, ELECTRICAL, HVAC, FIRE FIGHTING CONSULTANT		MAHESH PRAKASH	VIKEK NAMDEV
		DATE	DRAWING TITLE
		09-12-2025	

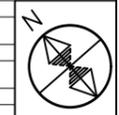



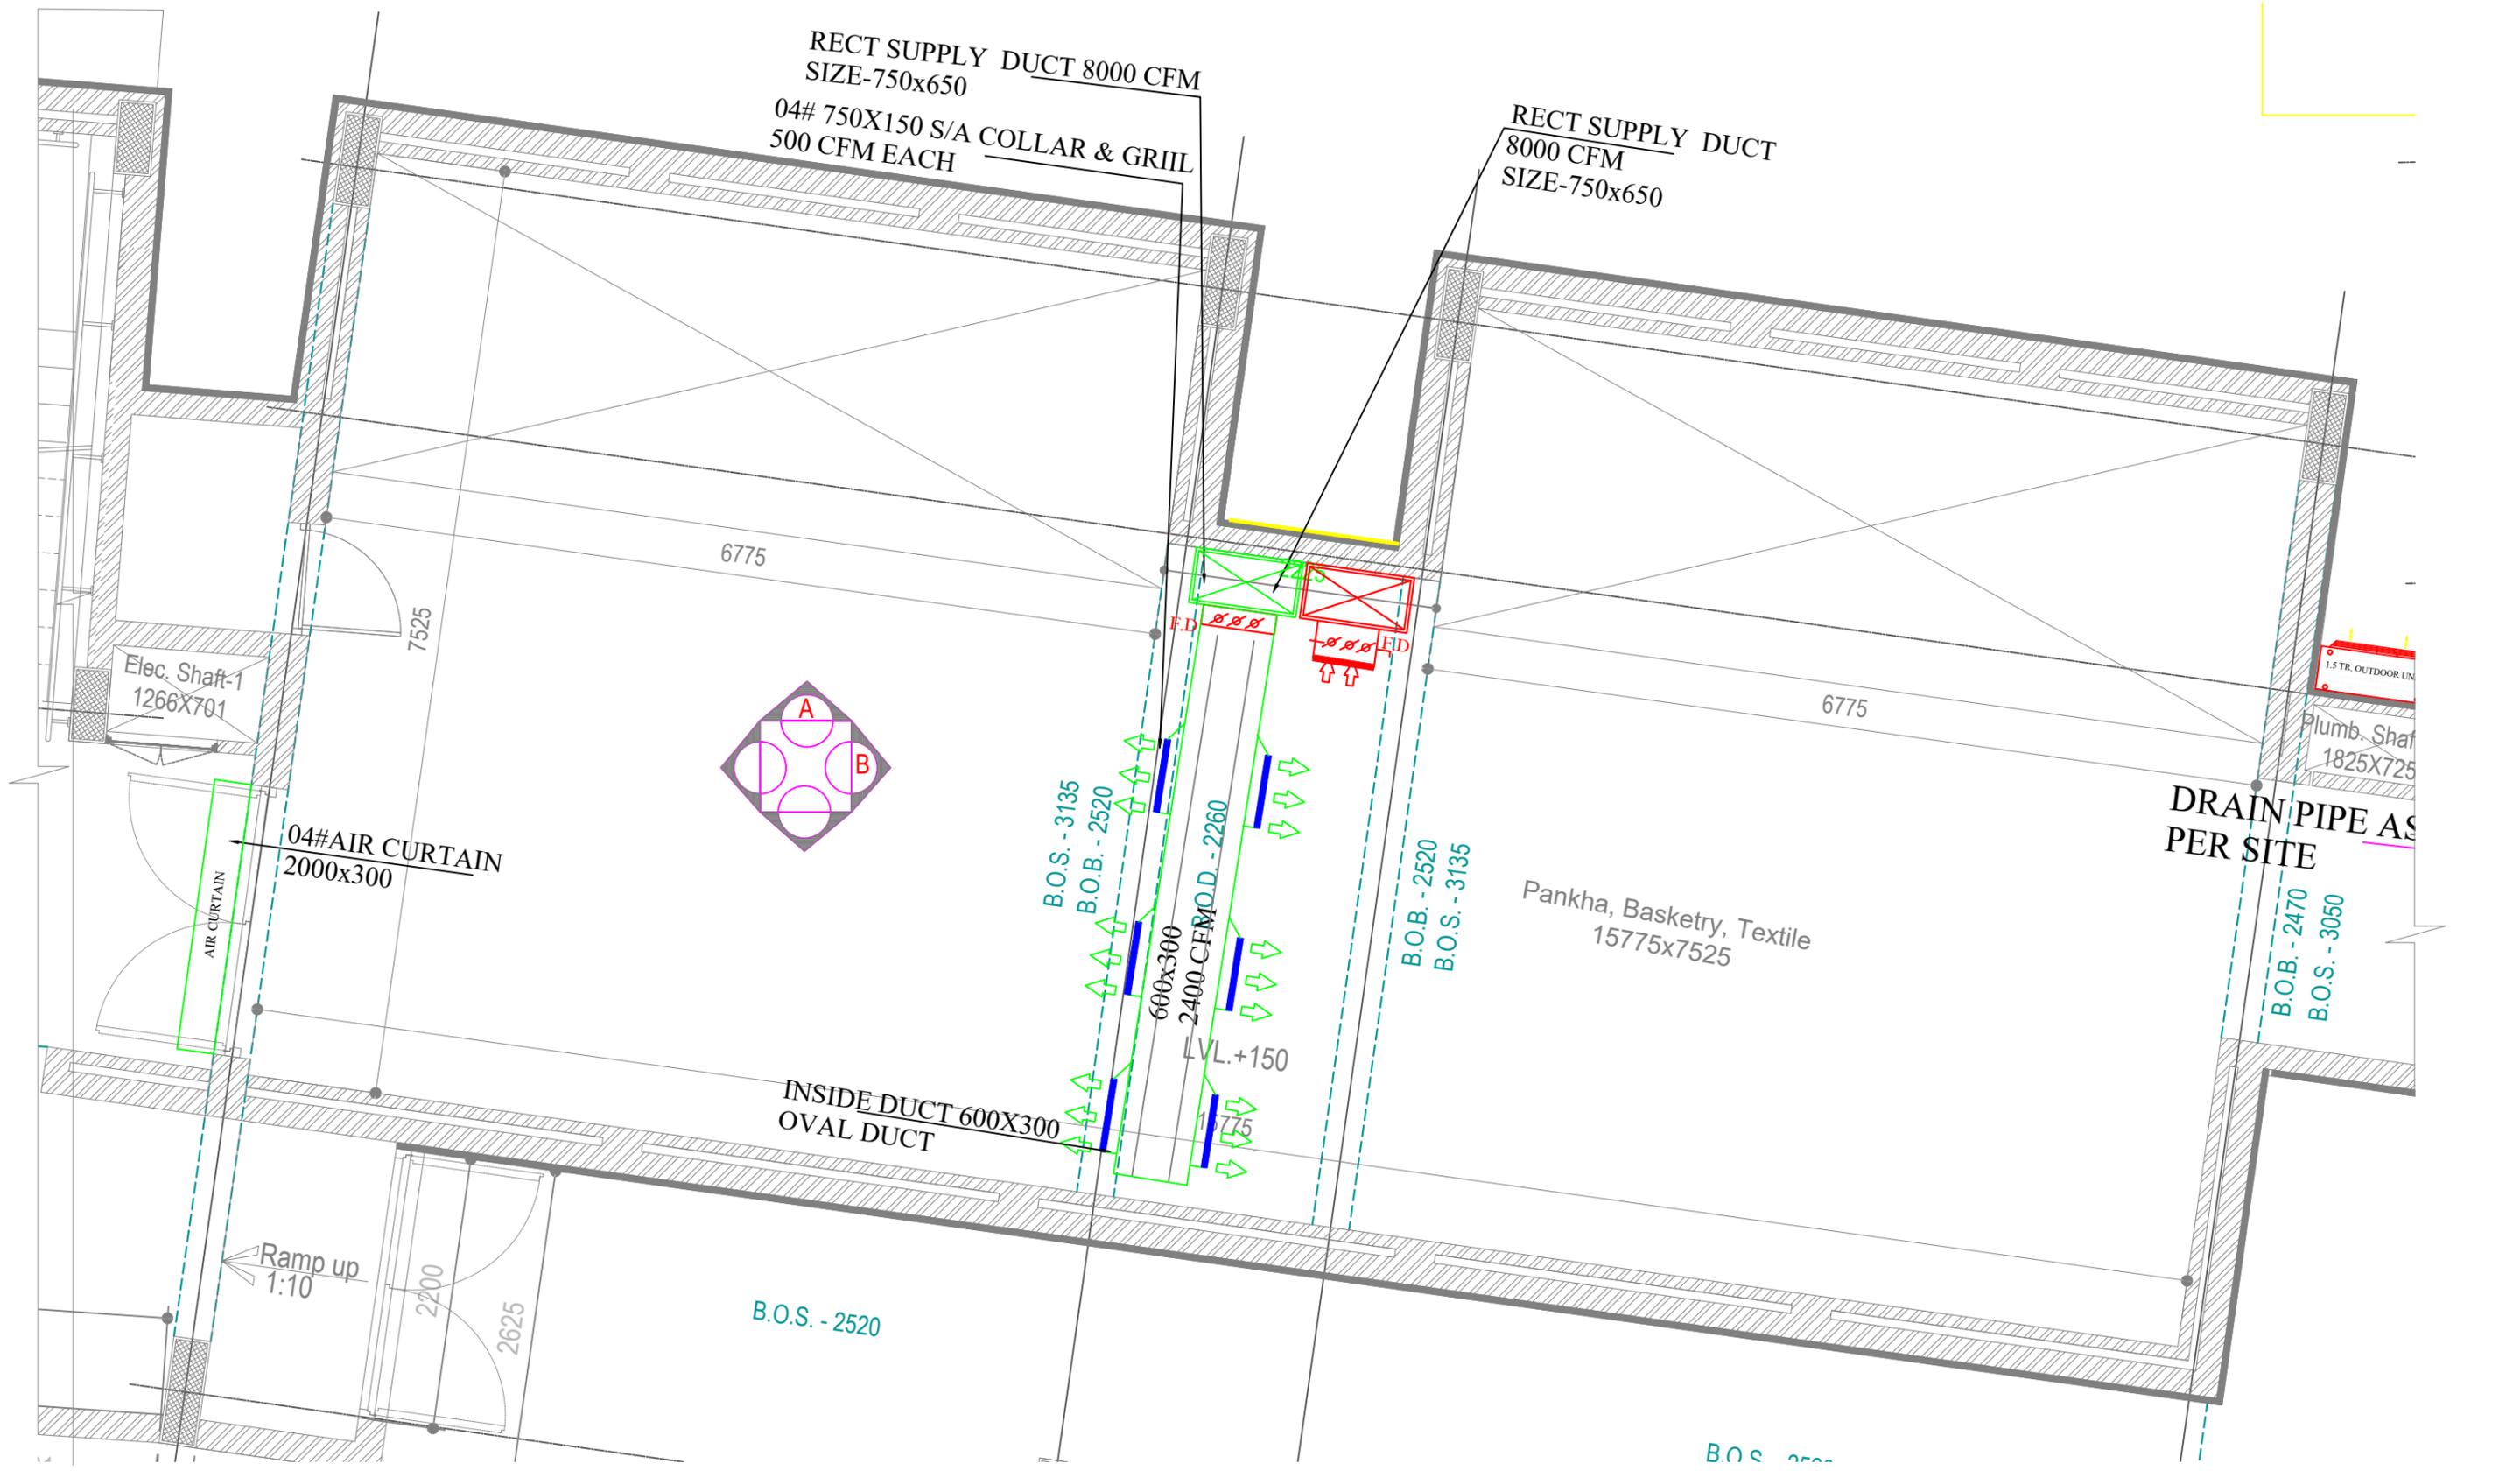


**01** Pankha ,Basketry Textile Gallery  
GROUND FLOOR  
Scale -1:50


**NOTE:**  
THIS DRAWING IS A COPYRIGHT. IT IS THE PROPERTY OF STUDIO VANRO AND IS NOT TO BE REPRODUCED, COPIED, HANDED OVER TO A THIRD PARTY OR USED FOR ANY PURPOSE OTHER THAN THAT FOR WHICH IT HAS BEEN LOANED.

**GENERAL NOTES:**  
ALL DIMENSIONS INDICATED ARE IN MILLIMETER UNLESS MENTIONED OTHERWISE  
ALL DIMENSIONS ARE TO BE CROSS CHECKED AT SITE AND ANY DISCREPANCY SHALL BE BROUGHT TO NOTICE BEFORE EXECUTION.  
ALL SERVICE DRAWINGS SHALL BE READ IN CONJUNCTION WITH THIS DRAWING AND OTHER DETAILS.  
ANY DISCREPANCIES IN DRAWING MUST BE REPORTED IMMEDIATELY TO PMCI/ARCHITECT FOR FINAL DECISION BEFORE EXECUTION.


S.NO	DATE	DRAWN	CHECKED	VERIFIED	REMARKS

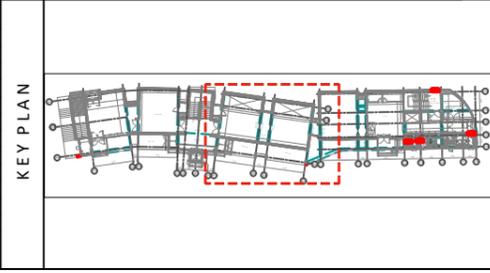


<b>CLIENT</b> J D Centre of Art		<b>PROJECT</b> J D Centre of Art, Bhubaneswar	
<b>ARCHITECT</b> VASTU SHILPA Consultants/ STUDIO VanRO		<b>DRAWING</b> GROUND FLOOR PLAN PANKHA, BASKETRY, TEXTILE GALLERY HVAC AS BUILT	
<b>STRUCTURAL CONSULTANT</b> Mahendra Raj Consultants Pvt. Ltd		<b>SCALE</b> COMPUTER FILE	
<b>MUSEUM DESIGN</b> Siddhartha Das Studio		<b>DRAWN BY</b> MAHESH PRAKASH	<b>CHECKED BY</b> VIKEK NAMDEV
<b>SANITARY, ELECTRICAL, HVAC, FIRE FIGHTING CONSULTANT</b>		<b>DATE</b> 22-04-2024	<b>DRAWING TITLE</b>

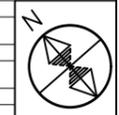




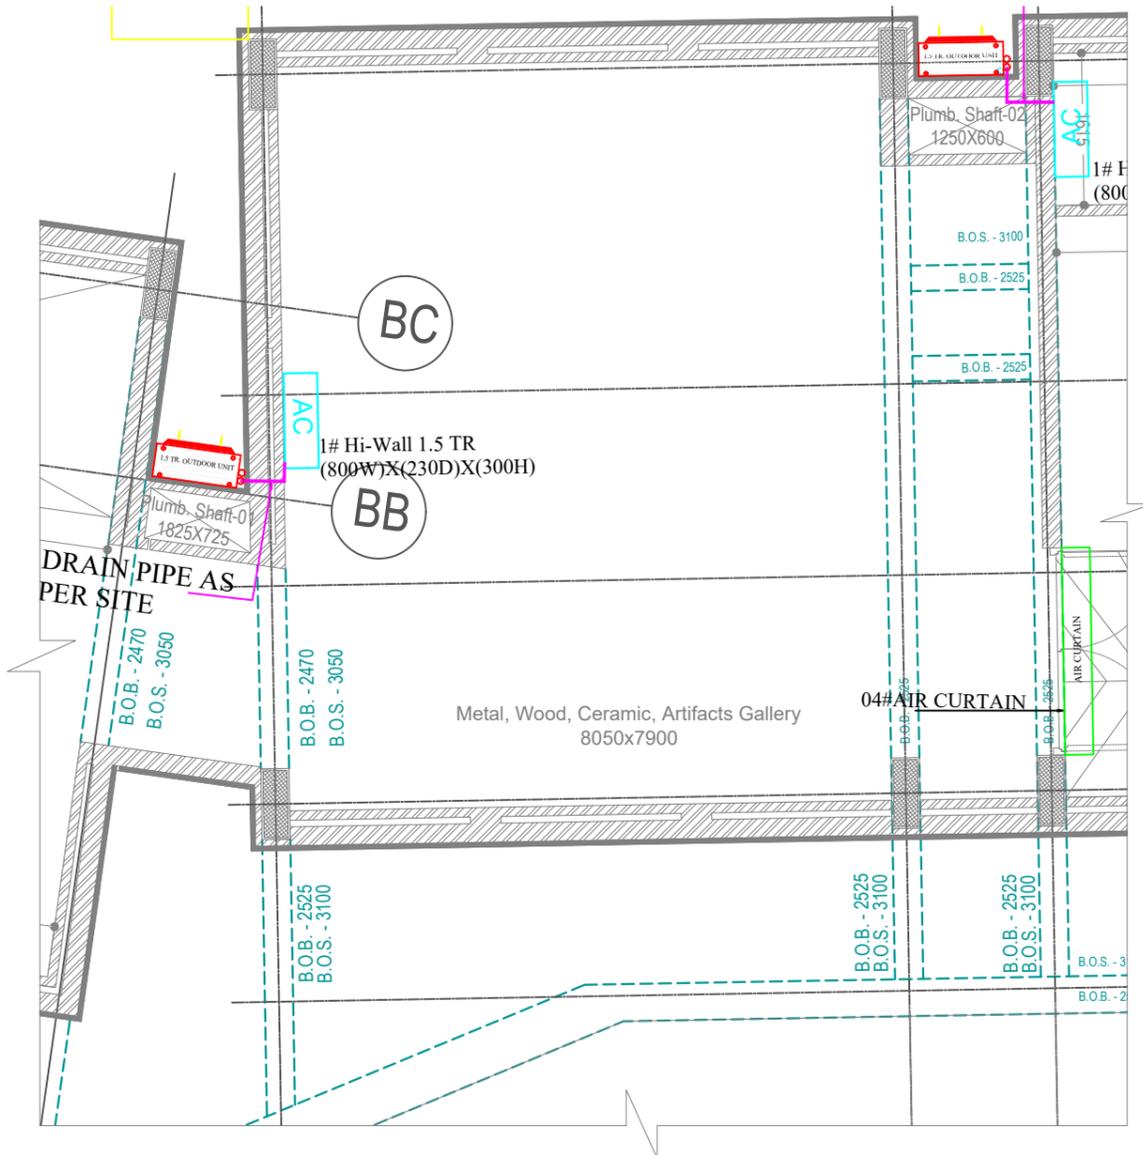


**01** Metal ,Wood, Ceramic ,Artifacts Gallery  
GROUND FLOOR  
Scale -1:75

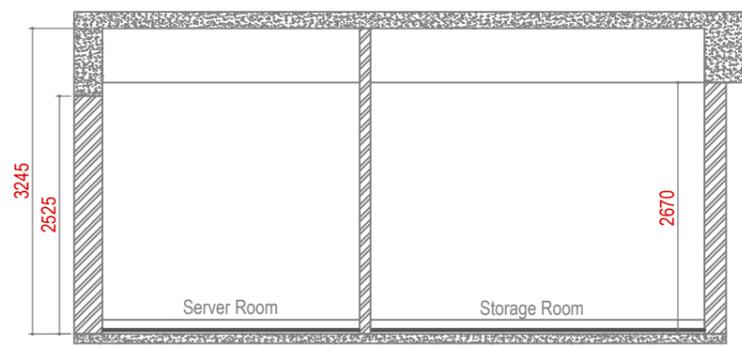


**02** Sectional Elevation -A  
Scale -1:75

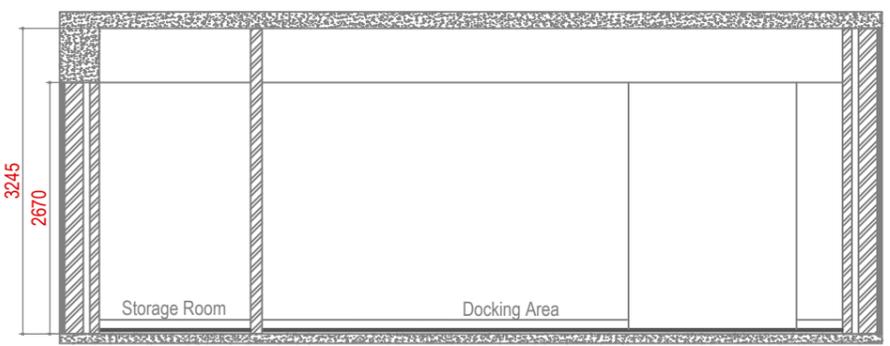

**03** Sectional Elevation -B  
Scale -1:75

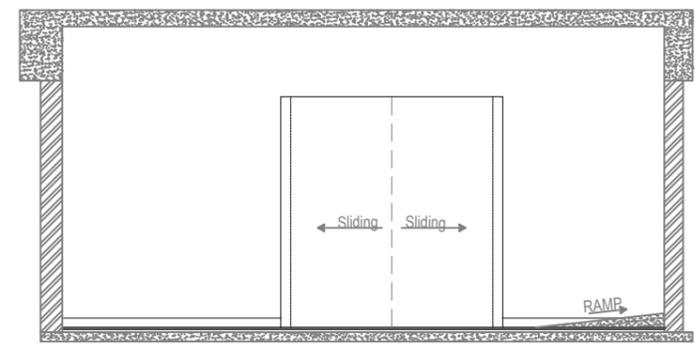

**04** Sectional Elevation -C  
Scale -1:75

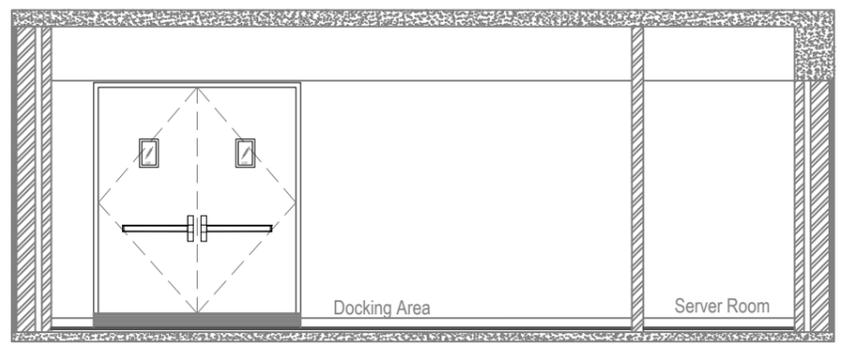


**05** Sectional Elevation -D  
Scale -1:75


**NOTE:**  
THIS DRAWING IS A COPYRIGHT. IT IS THE PROPERTY OF STUDIO VANRO AND IS NOT TO BE REPRODUCED, COPIED, HANDED OVER TO A THIRD PARTY OR USED FOR ANY PURPOSE OTHER THAN THAT FOR WHICH IT HAS BEEN LOANED.


**GENERAL NOTES:**  
ALL DIMENSIONS INDICATED ARE IN MILLIMETER UNLESS MENTIONED OTHERWISE  
ALL DIMENSIONS ARE TO BE CROSS CHECKED AT SITE AND ANY DISCREPANCY SHALL BE BROUGHT TO NOTICE BEFORE EXECUTION.  
ALL SERVICE DRAWINGS SHALL BE READ IN CONJUNCTION WITH THIS DRAWING AND OTHER DETAILS.  
ANY DISCREPANCIES IN DRAWING MUST BE REPORTED IMMEDIATELY TO PM/ARCHITECT FOR FINAL DECISION BEFORE EXECUTION.

S.NO	DATE	DRAWN	CHECKED	VERIFIED	REMARKS

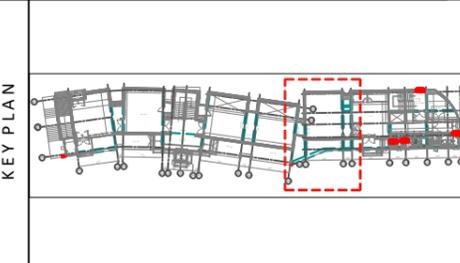


CLIENT J D Centre of Art		PROJECT J D Centre of Art, Bhubaneswar	
ARCHITECT VASTU SHILPA Consultants/ STUDIO VanRO		DRAWING GROUND FLOOR PLAN METAL WOOD HVAC AS BUILT	
STRUCTURAL CONSULTANT Mahendra Raj Consultants Pvt. Ltd		SCALE	COMPUTER FILE
MUSEUM DESIGN Siddhartha Das Studio		DRAWN BY MAHESH PRAKASH	CHECKED BY VIKEK NAMDEV
SANITARY, ELECTRICAL, HVAC, FIRE FIGHTING CONSULTANT		DATE 08-05-2025	DRAWING TITLE

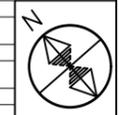


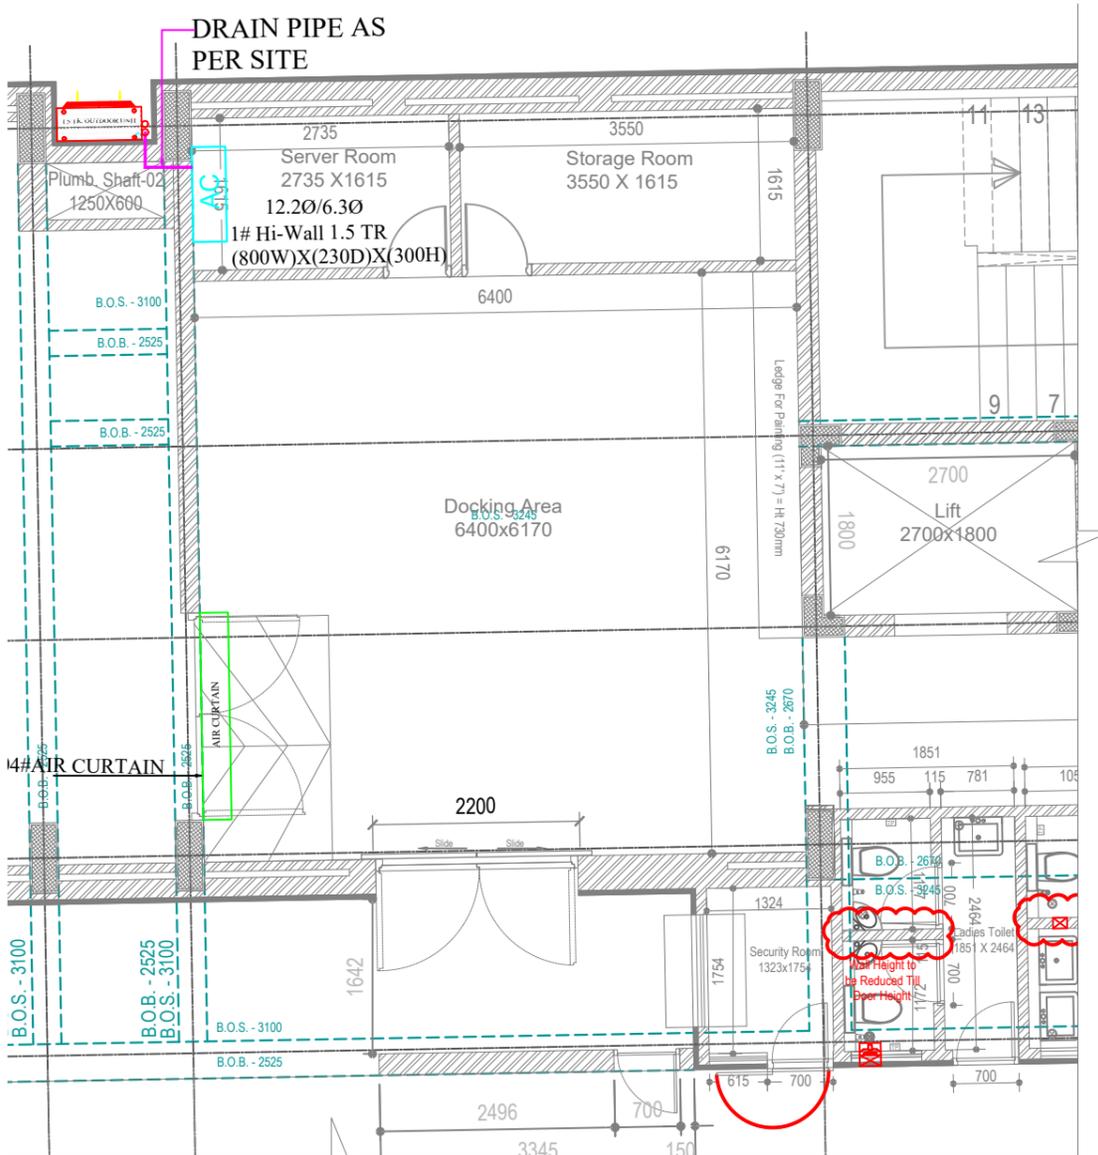


**01 Docking Area**  
GROUND FLOOR Scale -1:75

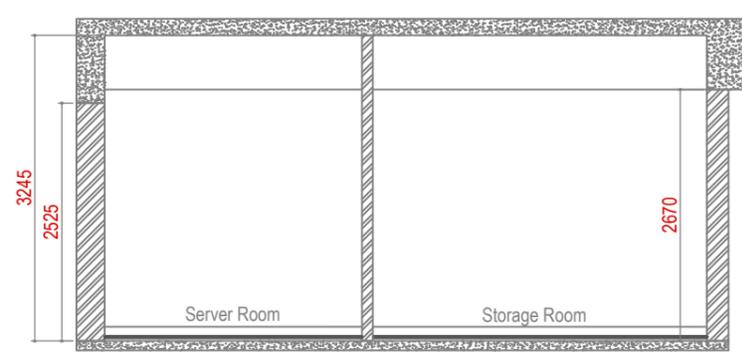


**02 Sectional Elevation -A**  
Scale -1:75

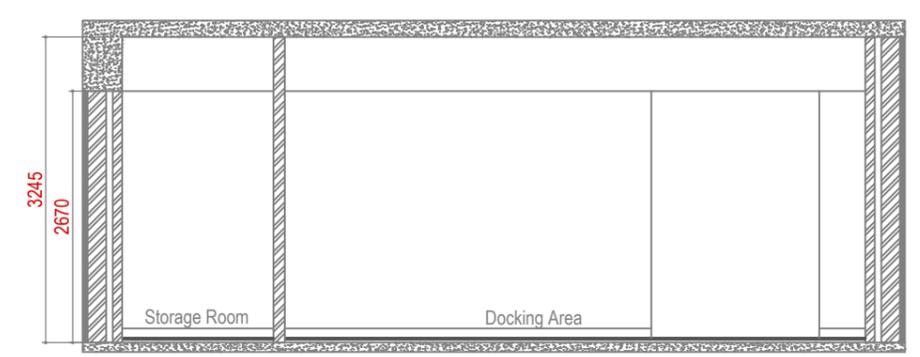


**03 Sectional Elevation -B**  
Scale -1:75

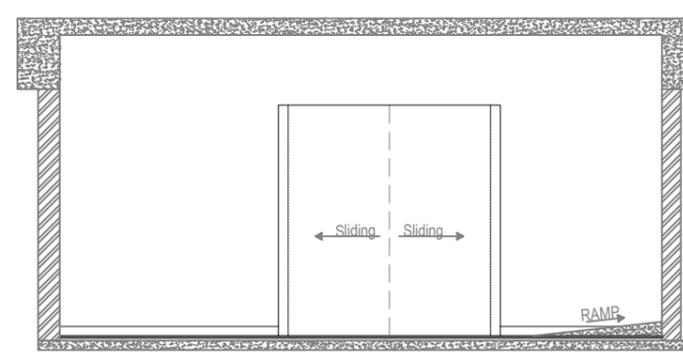

**04 Sectional Elevation -C**  
Scale -1:75

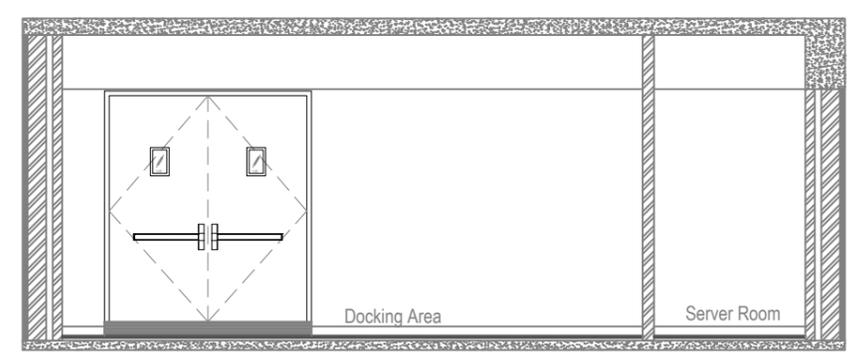

**05 Sectional Elevation -D**  
Scale -1:75

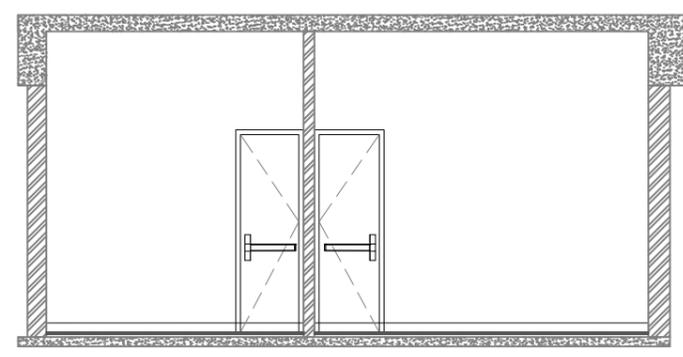


**06 Sectional Elevation -E**  
Scale -1:75


**NOTE:**  
THIS DRAWING IS A COPYRIGHT. IT IS THE PROPERTY OF STUDIO VANRO AND IS NOT TO BE REPRODUCED, COPIED, HANDED OVER TO A THIRD PARTY OR USED FOR ANY PURPOSE OTHER THAN THAT FOR WHICH IT HAS BEEN LOANED.

**GENERAL NOTES:**  
ALL DIMENSIONS INDICATED ARE IN MILLIMETER UNLESS MENTIONED OTHERWISE  
ALL DIMENSIONS ARE TO BE CROSS CHECKED AT SITE AND ANY DISCREPANCY SHALL BE BROUGHT TO NOTICE BEFORE EXECUTION.  
ALL SERVICE DRAWINGS SHALL BE READ IN CONJUNCTION WITH THIS DRAWING AND OTHER DETAILS.  
ANY DISCREPANCIES IN DRAWING MUST BE REPORTED IMMEDIATELY TO PMCI/ARCHITECT FOR FINAL DECISION BEFORE EXECUTION.

S.NO	DATE	DRAWN	CHECKED	VERIFIED	REMARKS

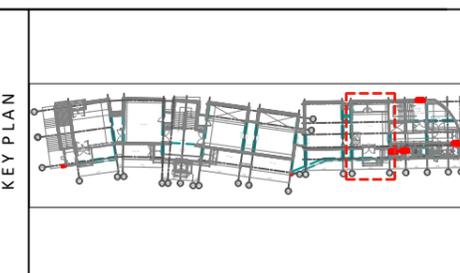


<b>CLIENT</b> J D Centre of Art		<b>PROJECT</b> J D Centre of Art, Bhubaneswar	
<b>ARCHITECT</b> VASTU SHILPA Consultants/ STUDIO VanRO		<b>DRAWING</b> GROUND FLOOR PLAN DOCKING AREA, SERVER ROOM, STORAGE ROOM HVAC AS BUILT	
<b>STRUCTURAL CONSULTANT</b> Mahendra Raj Consultants Pvt. Ltd		<b>SCALE</b>	<b>COMPUTER FILE</b>
<b>MUSEUM DESIGN</b> Siddhartha Das Studio		<b>DRAWN BY</b> MAHESH PRAKASH	<b>CHECKED BY</b> VIKEK NAMDEV
<b>SANITARY, ELECTRICAL, HVAC, FIRE FIGHTING CONSULTANT</b>		<b>DATE</b> 08-05-2024	<b>DRAWING TITLE</b>

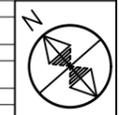





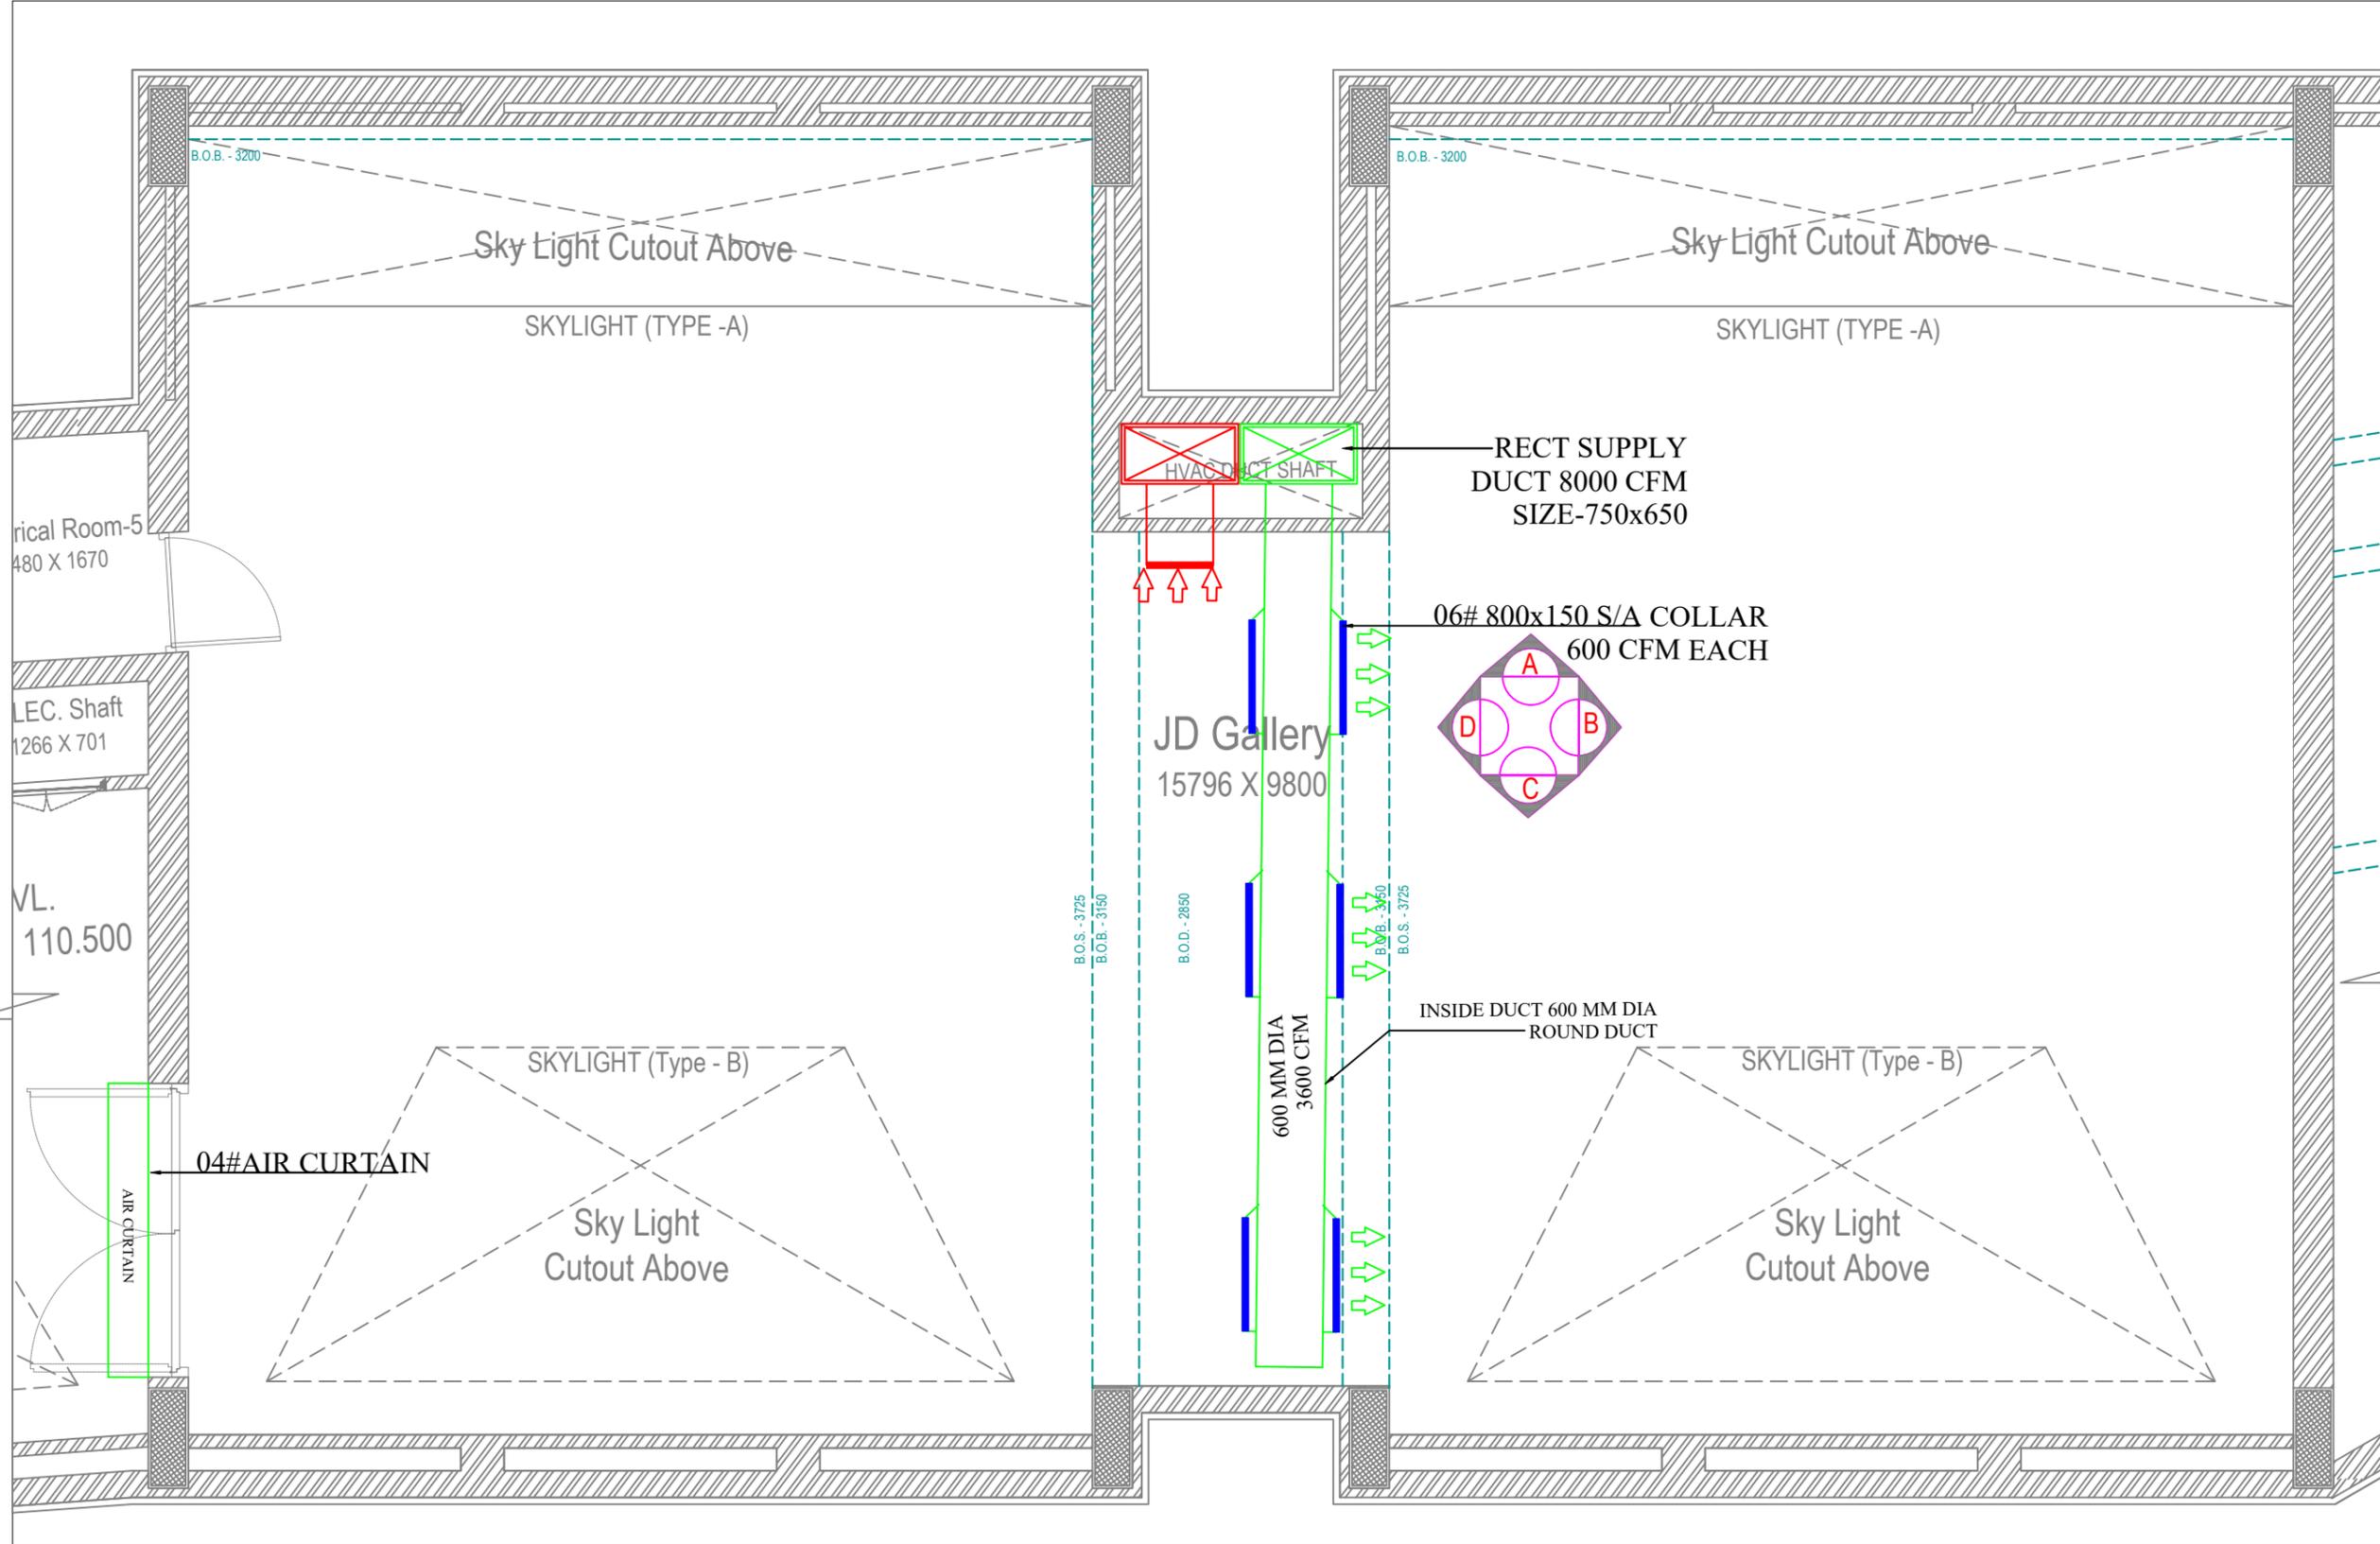


**01 JD GALLERY**  
**Second Floor**      Scale -1:50

**NOTE:**  
 THIS DRAWING IS A COPYRIGHT. IT IS THE PROPERTY OF STUDIO VANRO AND IS NOT TO BE REPRODUCED, COPIED, HANDED OVER TO A THIRD PARTY OR USED FOR ANY PURPOSE OTHER THAN THAT FOR WHICH IT HAS BEEN LOANED.

**GENERAL NOTES:**  
 ALL DIMENSIONS INDICATED ARE IN MILLIMETER UNLESS MENTIONED OTHERWISE  
 ALL DIMENSIONS ARE TO BE CROSS CHECKED AT SITE AND ANY DISCREPANCY SHALL BE BROUGHT TO NOTICE BEFORE EXECUTION.  
 ALL SERVICE DRAWINGS SHALL BE READ IN CONJUNCTION WITH THIS DRAWING AND OTHER DETAILS.  
 ANY DISCREPANCIES IN DRAWING MUST BE REPORTED IMMEDIATELY TO PM/ARCHITECT FOR FINAL DECISION BEFORE EXECUTION.


S.NO	DATE	DRAWN	CHECKED	VERIFIED	REMARKS

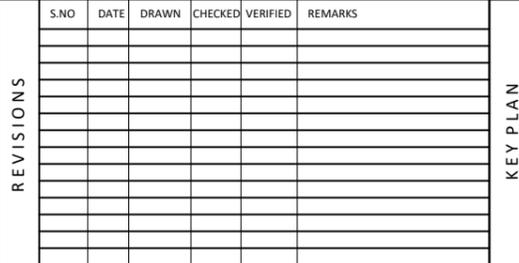


CLIENT	J D Centre of Art	PROJECT	J D Centre of Art, Bhubaneswar
ARCHITECT	VASTU SHILPA Consultants/ STUDIO VanRO	DRAWING	SECOND FLOOR PLAN JD GALLERY HVAC AS BUILT
STRUCTURAL CONSULTANT	Mahendra Raj Consultants Pvt. Ltd	SCALE	A3@1:50
MUSEUM DESIGN	Siddhartha Das Studio	DRAWN BY	MAHESH PRAKASH
SANITARY, ELECTRICAL, HVAC, FIRE FIGHTING CONSULTANT		CHECKED BY	VIKEK NAMDEV
		DATE	08-05-2025
		DRAWING TITLE	






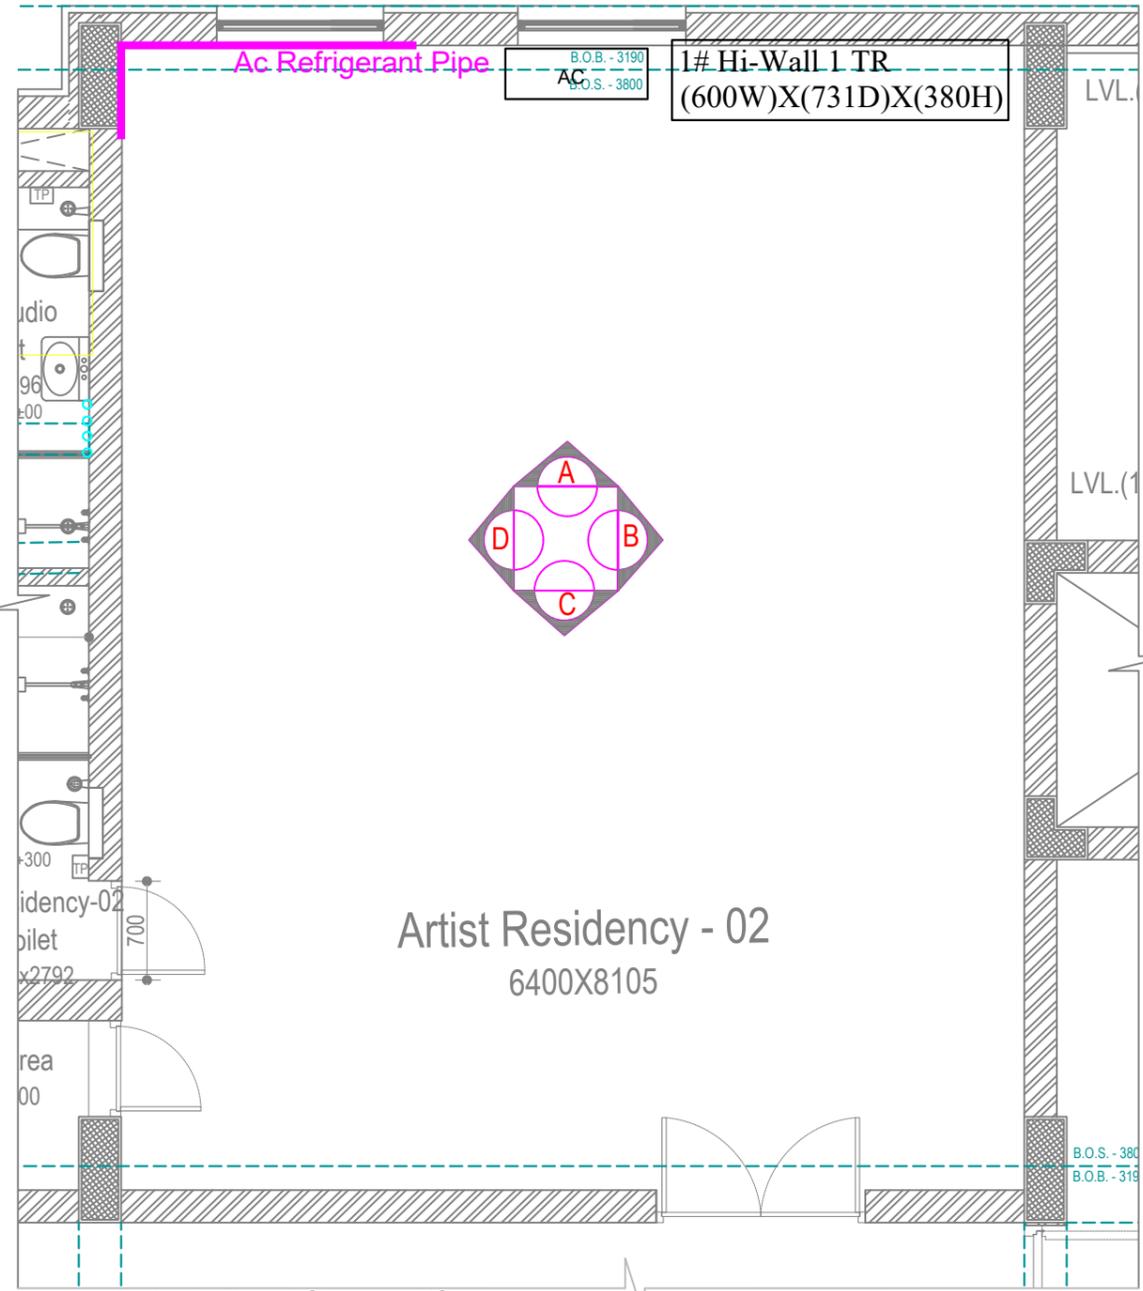


**01 Artist Residency Plan**  
Second Floor Scale -1:50

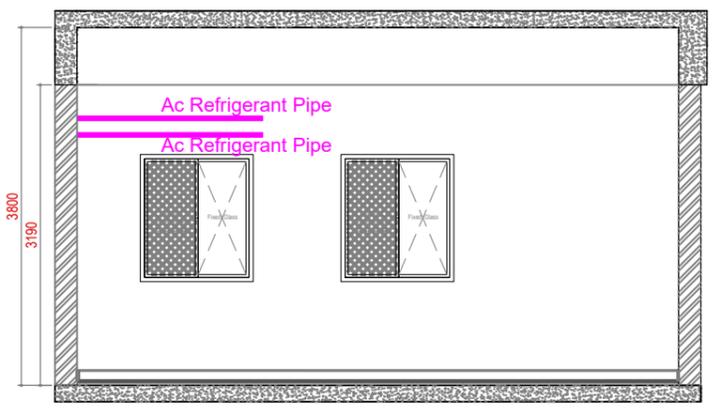


**02 Sectional Elevation-A**  
Scale -1:75

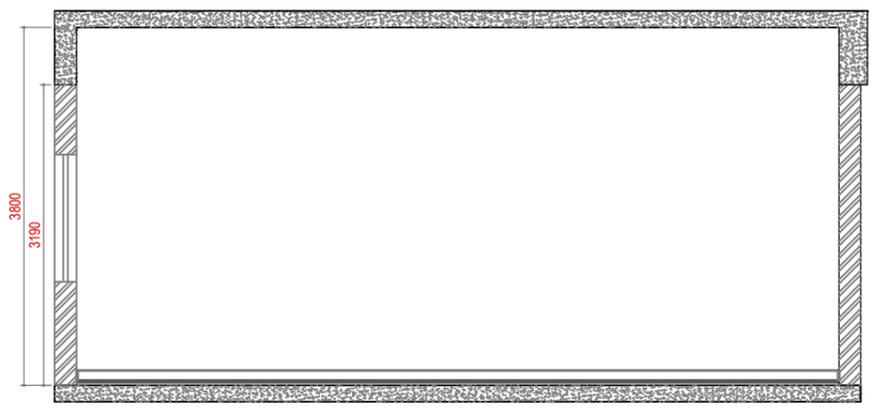

**03 Sectional Elevation-B**  
Scale -1:75

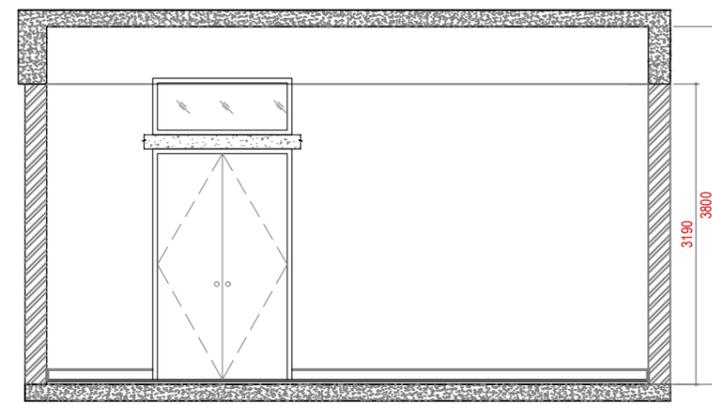

**04 Sectional Elevation-C**  
Scale -1:75

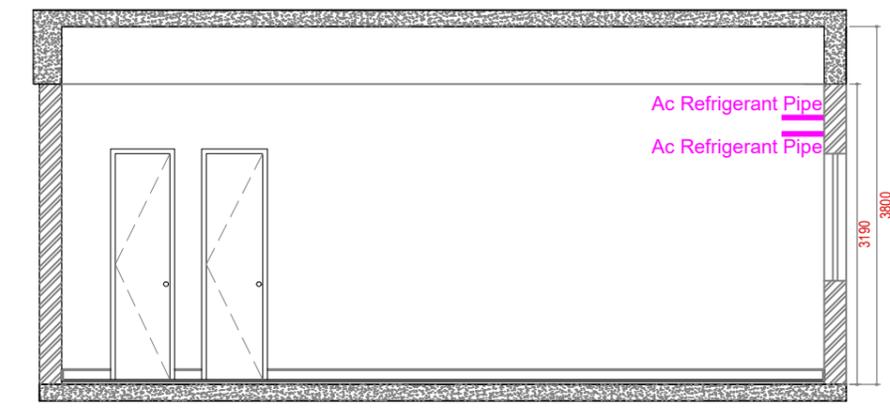


**05 Sectional Elevation-D**  
Scale -1:75


**NOTE:**  
THIS DRAWING IS A COPYRIGHT. IT IS THE PROPERTY OF STUDIO VANRO AND IS NOT TO BE REPRODUCED, COPIED, HANDED OVER TO A THIRD PARTY OR USED FOR ANY PURPOSE OTHER THAN THAT FOR WHICH IT HAS BEEN LOANED.

**GENERAL NOTES:**  
ALL DIMENSIONS INDICATED ARE IN MILLIMETER UNLESS MENTIONED OTHERWISE  
ALL DIMENSIONS ARE TO BE CROSS CHECKED AT SITE AND ANY DISCREPANCY SHALL BE BROUGHT TO NOTICE BEFORE EXECUTION.  
ALL SERVICE DRAWINGS SHALL BE READ IN CONJUNCTION WITH THIS DRAWING AND OTHER DETAILS.  
ANY DISCREPANCIES IN DRAWING MUST BE REPORTED IMMEDIATELY TO PMCI/ARCHITECT FOR FINAL DECISION BEFORE EXECUTION.


S.NO	DATE	DRAWN	CHECKED	VERIFIED	REMARKS

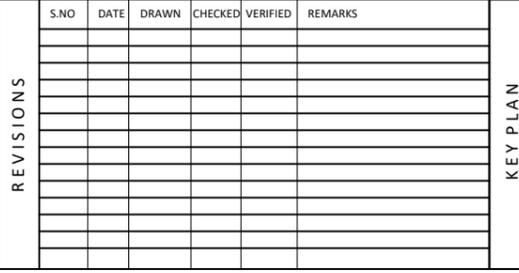


CLIENT	J D Centre of Art	PROJECT	J D Centre of Art, Bhubaneswar
ARCHITECT	VASTU SHILPA Consultants/ STUDIO VanRO	DRAWING	SECOND FLOOR PLAN ARTIST RESIDENCY-01 HVAC AS BUILT
STRUCTURAL CONSULTANT	Mahendra Raj Consultants Pvt. Ltd	SCALE	A3@1:75.1:50
MUSEUM DESIGN	Siddhartha Das Studio	DRAWN BY	MAHESH PRAKASH
SANITARY, ELECTRICAL, HVAC, FIRE FIGHTING CONSULTANT		CHECKED BY	VIKEK NAMDEV
		DATE	06-05-2024
		DRAWING TITLE	

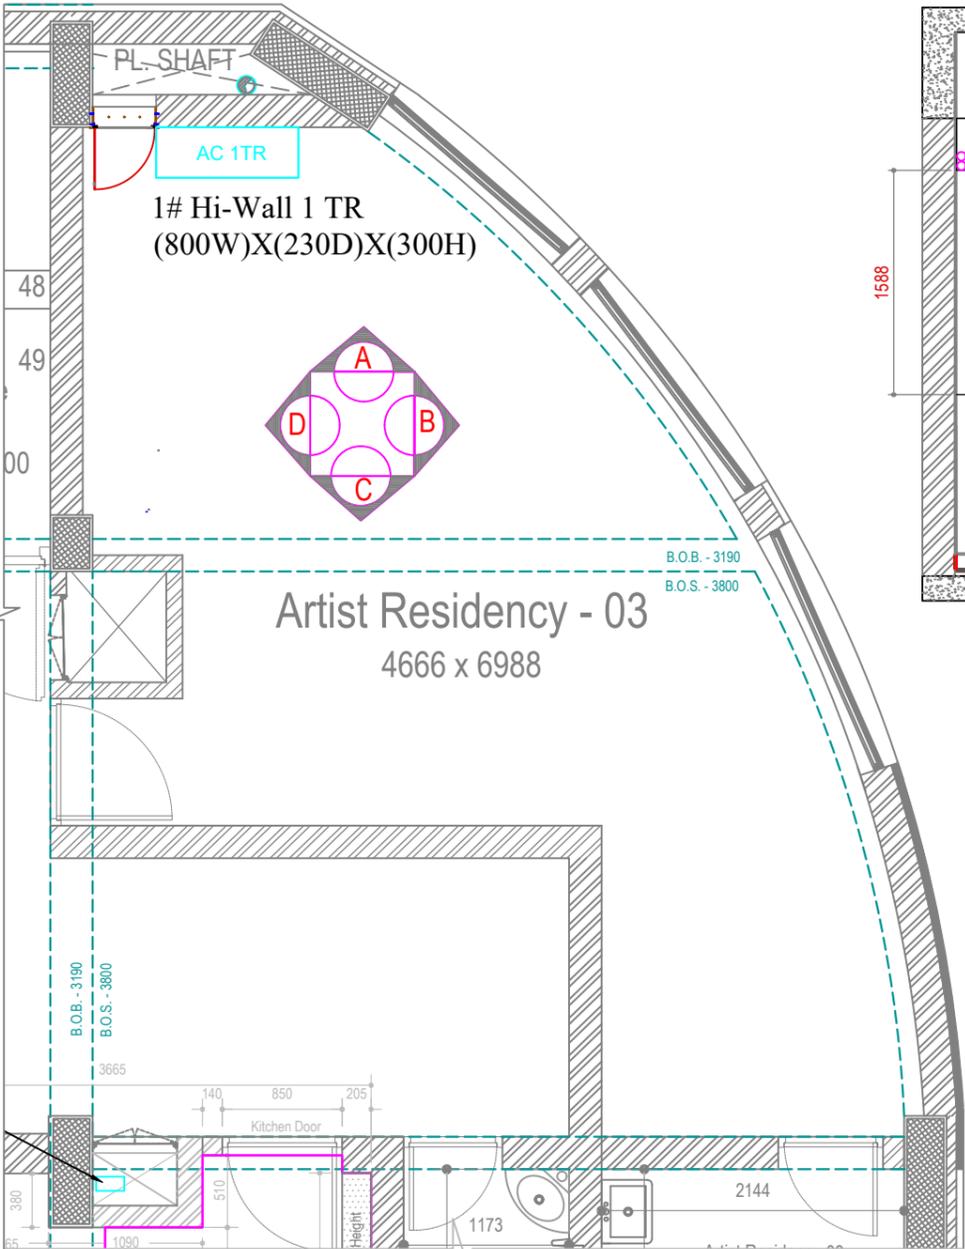


**01 Artist Residency-03**  
Second Floor  
Scale -1:50

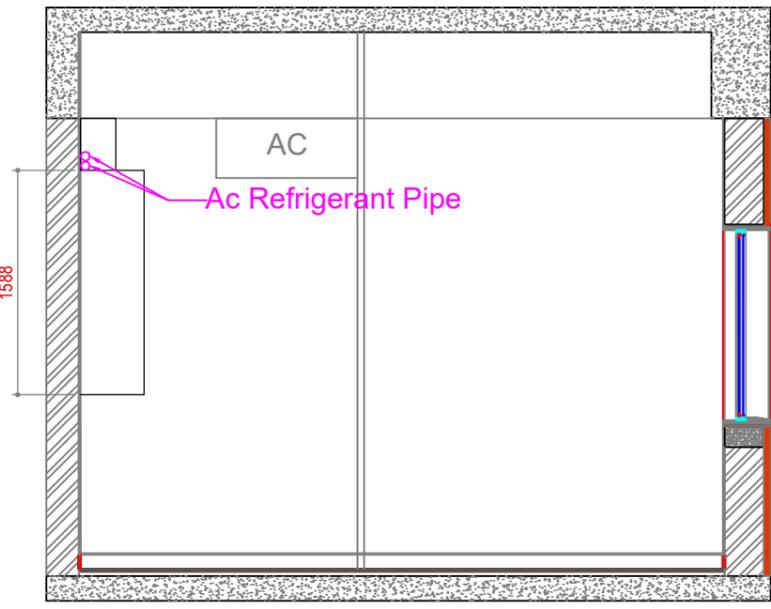


**02 Sectional Elevation-A**  
Scale -1:50

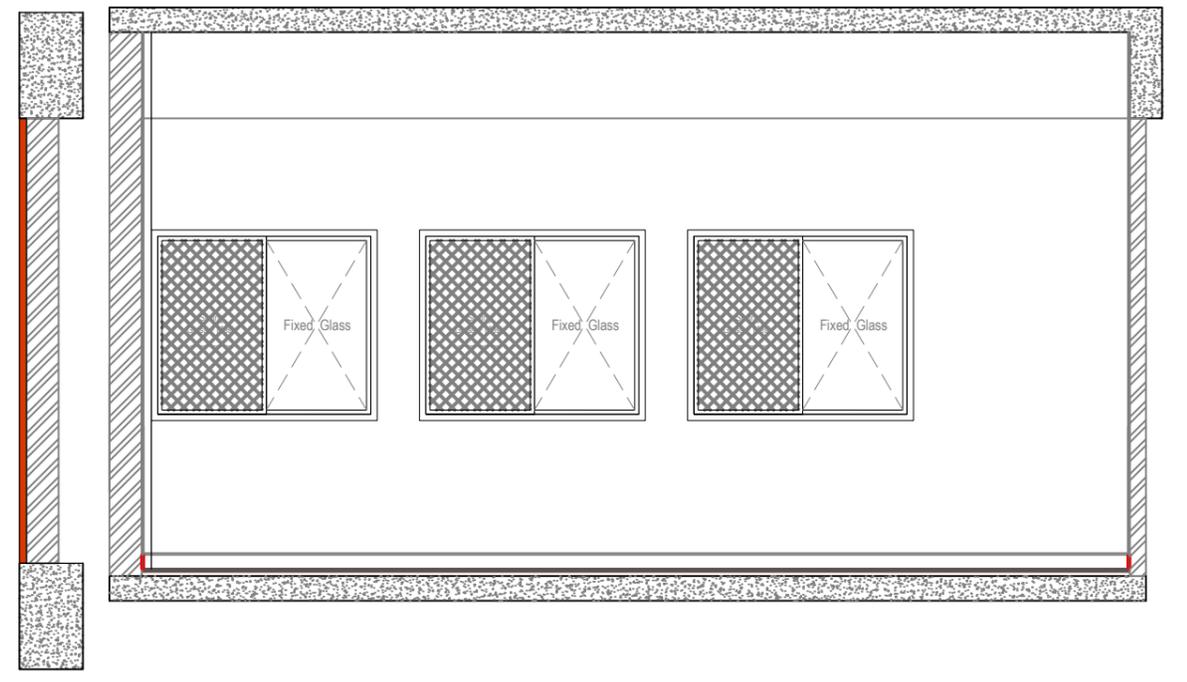

**03 Sectional Elevation-B**  
Scale -1:50

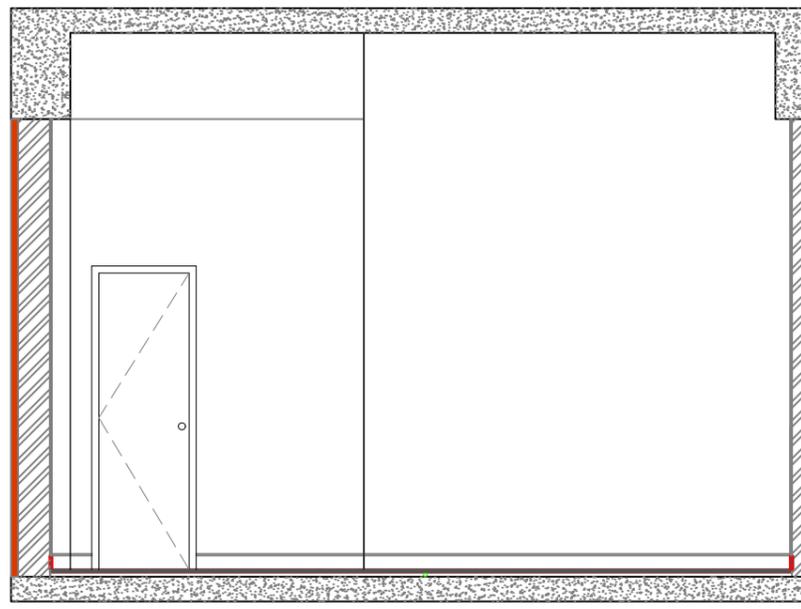

**04 Sectional Elevation-C**  
Scale -1:50


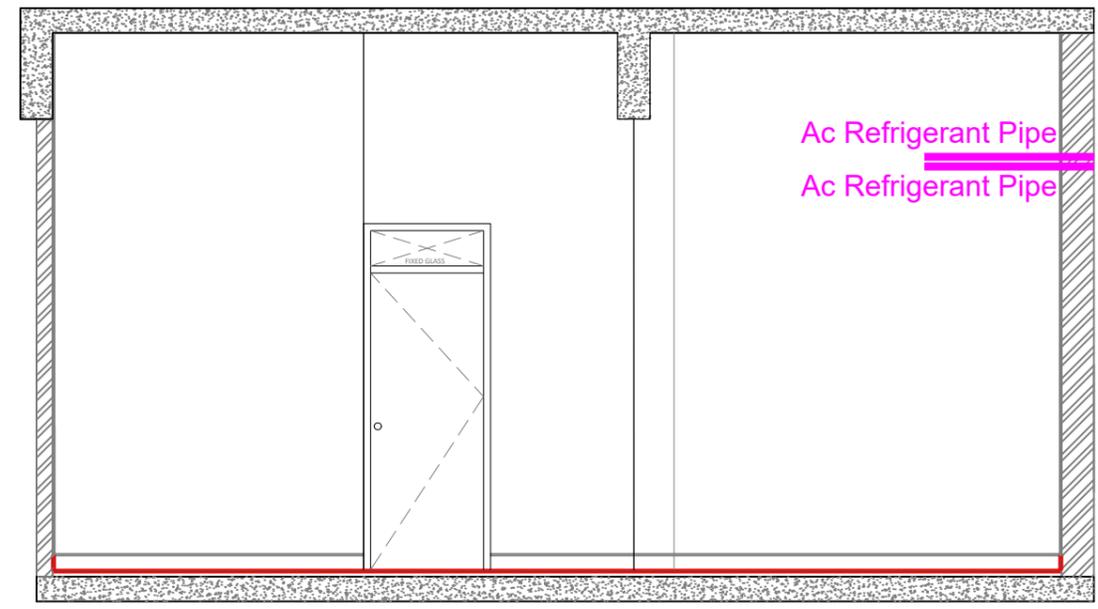


**05 Sectional Elevation-D**  
Scale -1:50

**NOTE:**  
THIS DRAWING IS A COPYRIGHT. IT IS THE PROPERTY OF STUDIO VANRO AND IS NOT TO BE REPRODUCED, COPIED, HANDED OVER TO A THIRD PARTY OR USED FOR ANY PURPOSE OTHER THAN THAT FOR WHICH IT HAS BEEN LOANED.

**GENERAL NOTES:**  
ALL DIMENSIONS INDICATED ARE IN MILLIMETER UNLESS MENTIONED OTHERWISE  
ALL DIMENSIONS ARE TO BE CROSS CHECKED AT SITE AND ANY DISCREPANCY SHALL BE BROUGHT TO NOTICE BEFORE EXECUTION.  
ALL SERVICE DRAWINGS SHALL BE READ IN CONJUNCTION WITH THIS DRAWING AND OTHER DETAILS.  
ANY DISCREPANCIES IN DRAWING MUST BE REPORTED IMMEDIATELY TO PMCI/ARCHITECT FOR FINAL DECISION BEFORE EXECUTION.

S.NO	DATE	DRAWN	CHECKED	VERIFIED	REMARKS

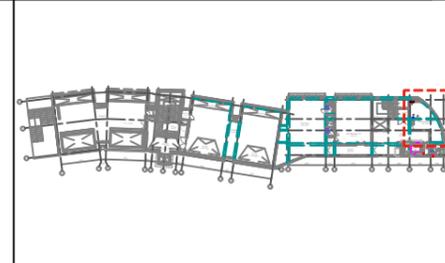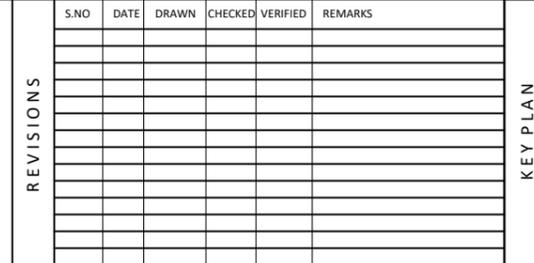

CLIENT	J D Centre of Art	PROJECT	J D Centre of Art, Bhubaneswar
ARCHITECT	VASTU SHILPA Consultants/ STUDIO VanRO	DRAWING	SECOND FLOOR PLAN ARTIST RESIDENCY-03 HVAC AS BUILT
STRUCTURAL CONSULTANT	Mahendra Raj Consultants Pvt. Ltd	SCALE	A3@1:50
MUSEUM DESIGN	Siddhartha Das Studio	DRAWN BY	MAHESH PRAKASH
SANITARY, ELECTRICAL, HVAC, FIRE FIGHTING CONSULTANT		CHECKED BY	VIKEK NAMDEV
		DATE	06-05-2024
		DRAWING TITLE	

