


Ground Floor Reception Block Part Plan

NOTE:
 THIS DRAWING IS A COPYRIGHT. IT IS THE PROPERTY OF STUDIO VANRO AND IS NOT TO BE REPRODUCED, COPIED, HANDED OVER TO A THIRD PARTY OR USED FOR ANY PURPOSE OTHER THAN THAT FOR WHICH IT HAS BEEN LOANED.


GENERAL NOTES:
 ALL DIMENSIONS INDICATED ARE IN MILLIMETER UNLESS MENTIONED OTHERWISE
 ALL DIMENSIONS ARE TO BE CROSS CHECKED AT SITE AND ANY DISCREPANCY SHALL BE BROUGHT TO NOTICE BEFORE EXECUTION.
 ALL SERVICE DRAWINGS SHALL BE READ IN CONJUNCTION WITH THIS DRAWING AND OTHER DETAILS.
 ANY DISCREPANCIES IN DRAWING MUST BE REPORTED IMMEDIATELY TO PM/ARCHITECT FOR FINAL DECISION BEFORE EXECUTION.

S.NO	DATE	DRAWN	CHECKED	VERIFIED	REMARKS

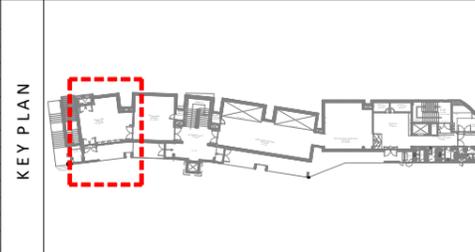

CLIENT J D Centre of Art		PROJECT J D Centre of Art, Bhubaneswar	
ARCHITECT VASTU SHILPA Consultants/ STUDIO VanRO		DRAWING GROUND FLOOR PLAN RECEPTION BLOCK PART PLAN	
STRUCTURAL CONSULTANT Mahendra Raj Consultants Pvt. Ltd		SCALE	COMPUTER FILE
MUSEUM DESIGN Siddhartha Das Studio		DRAWN BY MAHESH PRAKASH	CHECKED BY VIVEK NAMDEV
SANITARY, ELECTRICAL, HVAC, FIRE FIGHTING CONSULTANT		DATE 28-09-2024	DRAWING TITLE



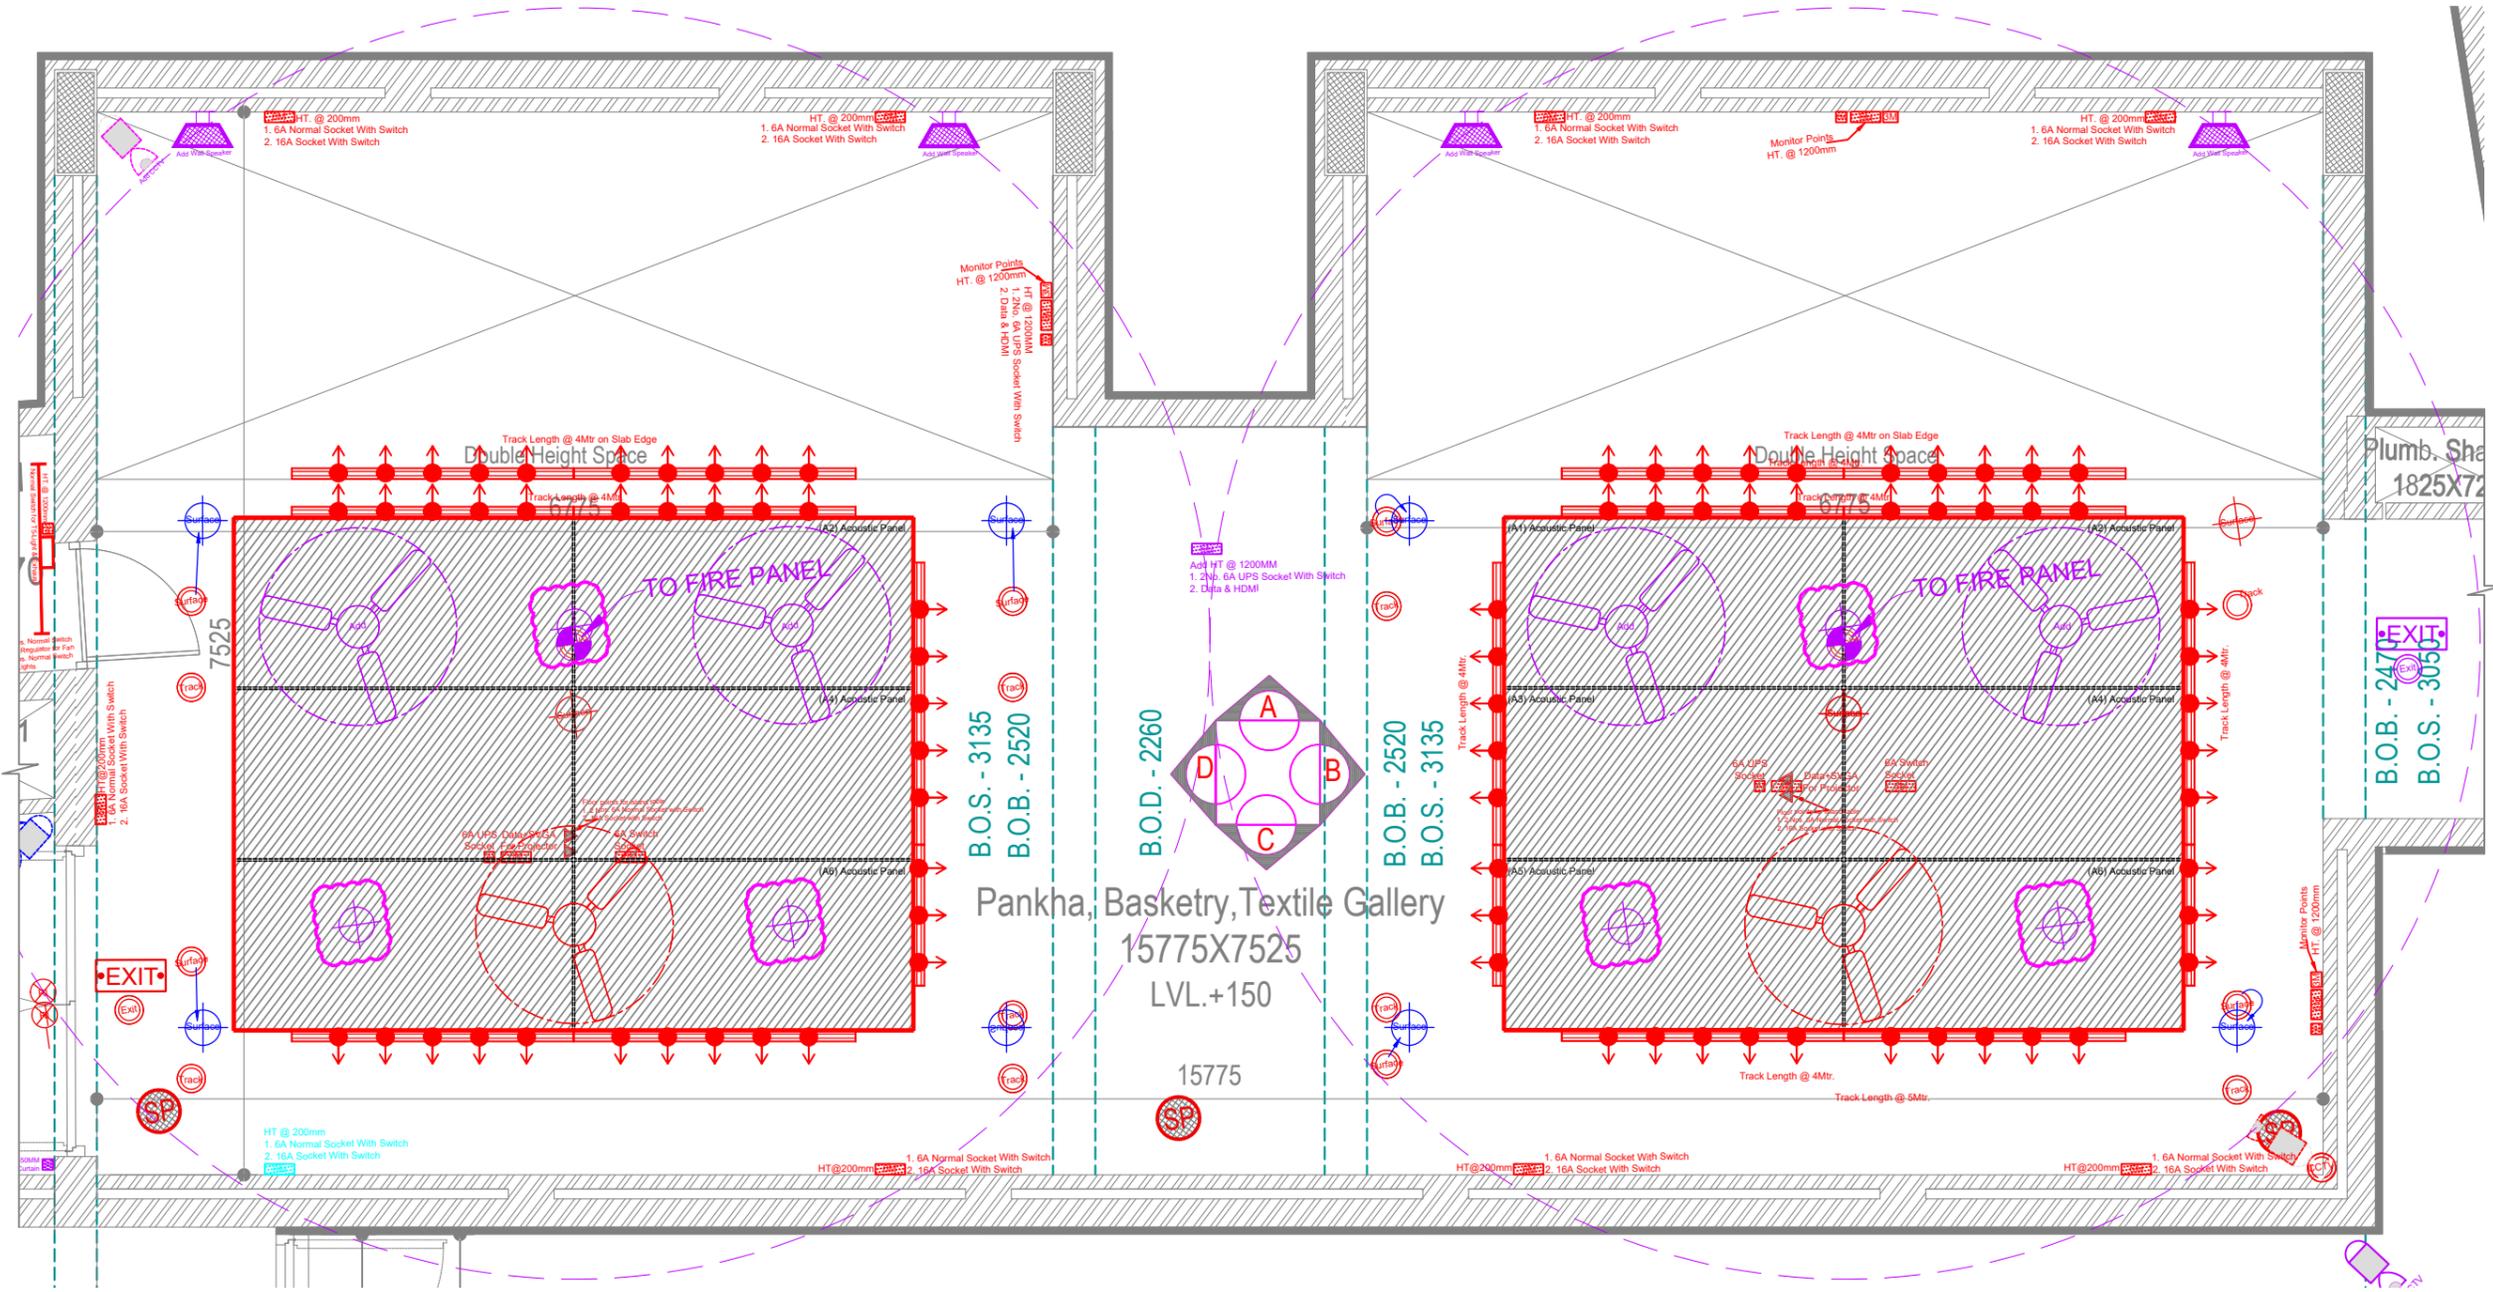


01 Pankha Basket Textile Gallery
Ground Floor Plan
Scale: 1:50

NOTE:
THIS DRAWING IS A COPYRIGHT. IT IS THE PROPERTY OF STUDIO VANRO AND IS NOT TO BE REPRODUCED, COPIED, HANDED OVER TO A THIRD PARTY OR USED FOR ANY PURPOSE OTHER THAN THAT FOR WHICH IT HAS BEEN LOANED.

GENERAL NOTES:
ALL DIMENSIONS INDICATED ARE IN MILLIMETER UNLESS MENTIONED OTHERWISE
ALL DIMENSIONS ARE TO BE CROSS CHECKED AT SITE AND ANY DISCREPANCY SHALL BE BROUGHT TO NOTICE BEFORE EXECUTION.
ALL SERVICE DRAWINGS SHALL BE READ IN CONJUNCTION WITH THIS DRAWING AND OTHER DETAILS.
ANY DISCREPANCIES IN DRAWING MUST BE REPORTED IMMEDIATELY TO PM/ARCHITECT FOR FINAL DECISION BEFORE EXECUTION.


S.NO	DATE	DRAWN	CHECKED	VERIFIED	REMARKS


S.NO	DATE	DRAWN	CHECKED	VERIFIED	REMARKS

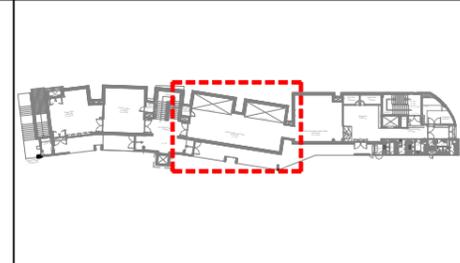


CLIENT	J D Centre of Art
ARCHITECT	VASTU SHILPA Consultants/ STUDIO VanRO
STRUCTURAL CONSULTANT	Mahendra Raj Consultants Pvt. Ltd
MUSEUM DESIGN	Siddhartha Das Studio
SANITARY, ELECTRICAL, HVAC, FIRE FIGHTING CONSULTANT	

PROJECT	J D Centre of Art, Bhubaneswar
DRAWING	GROUND FLOOR PLAN PANKHA BASKETRY TEXTILE PLAN
SCALE	A3@1:50
DRAWN BY	MAHESH PRAKASH
CHECKED BY	VIVEK NAMDEV
DATE	19-07-2025
COMPUTER FILE	
DRAWING TITLE	

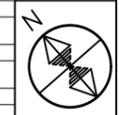


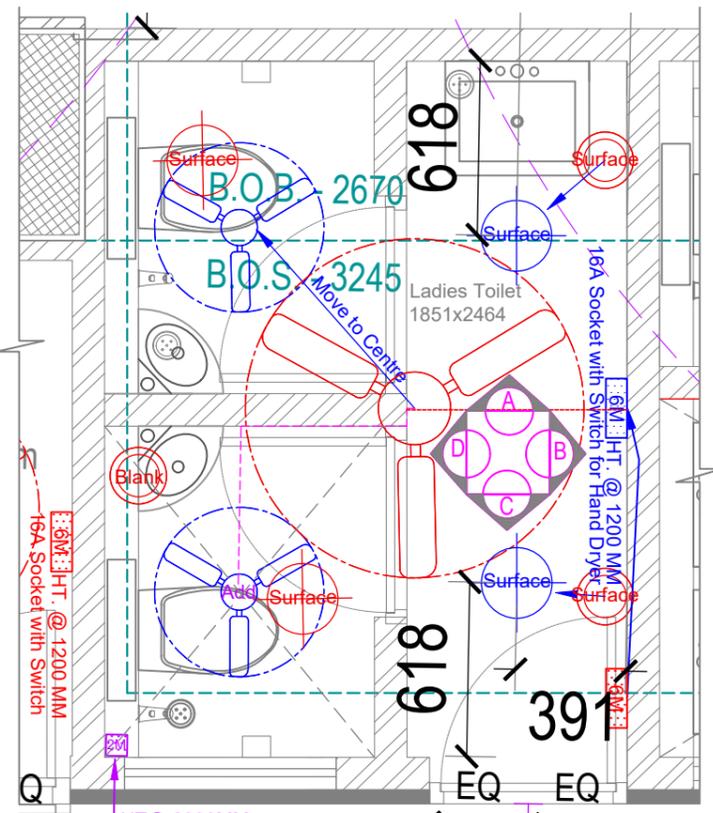


01 Out Side Ladies Toilet
Ground Floor Plan
Scale-1:25

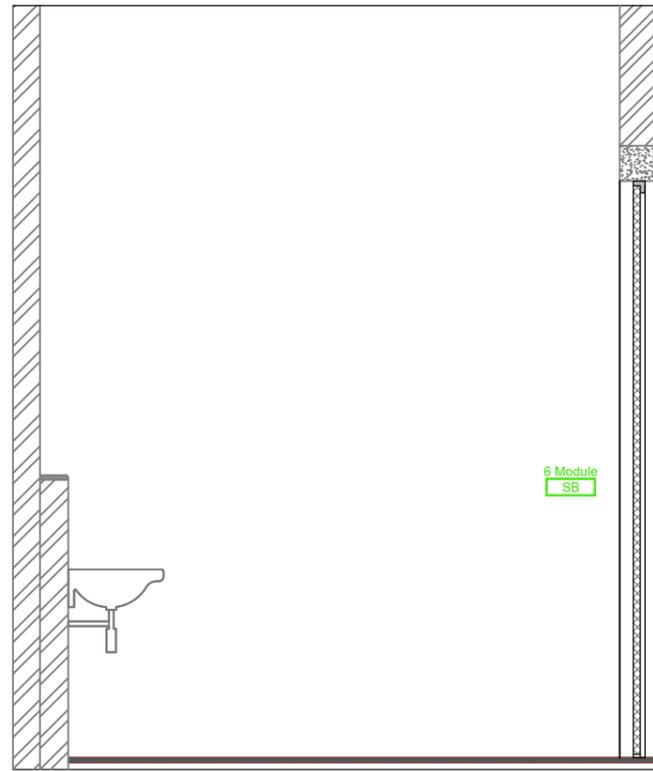


03 Sectional Elevation-B
Scale-1:30

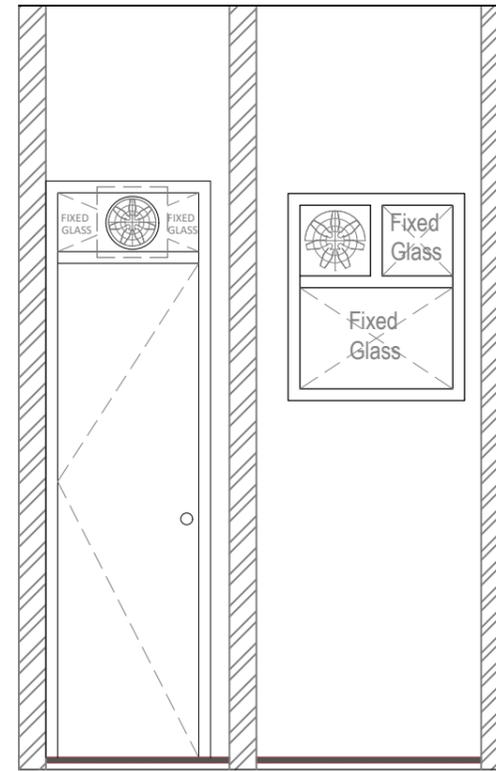

04 Sectional Elevation-C
Scale-1:30

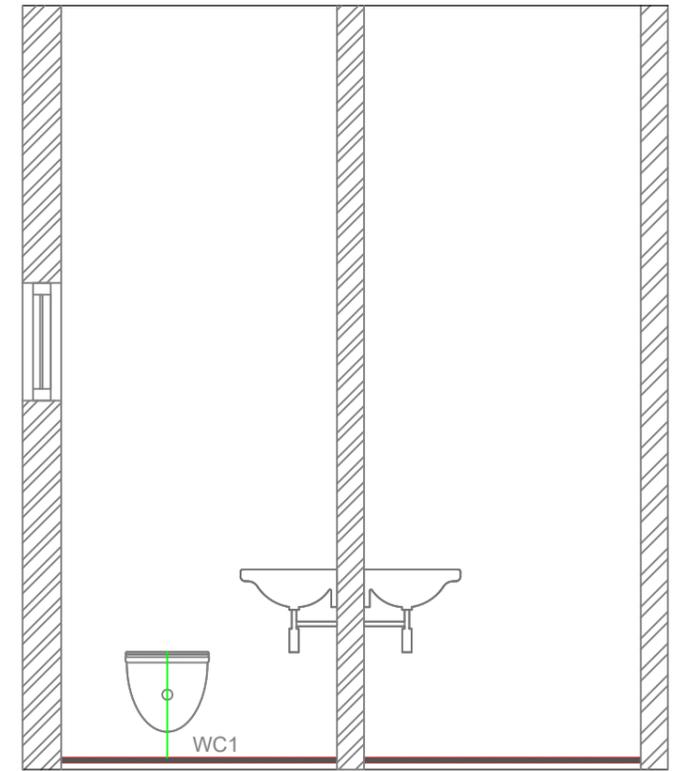

04 Sectional Elevation-D
Scale-1:30

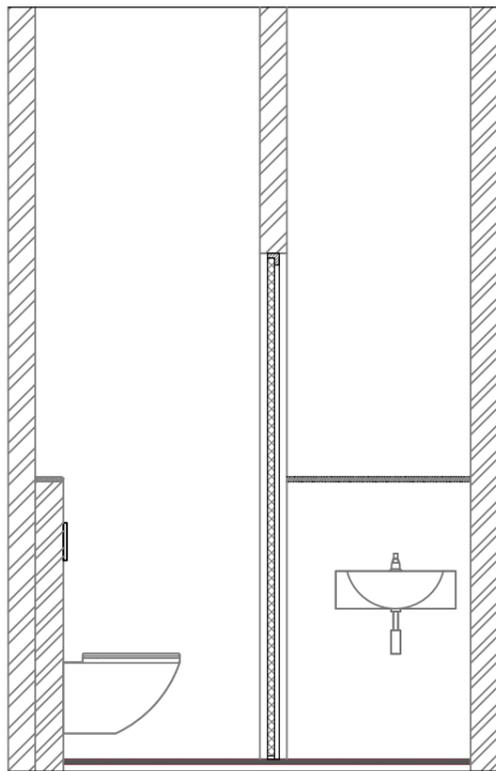


02 Sectional Elevation-A
Scale-1:30

NOTE:
THIS DRAWING IS A COPYRIGHT. IT IS THE PROPERTY OF STUDIO VANRO AND IS NOT TO BE REPRODUCED, COPIED, HANDED OVER TO A THIRD PARTY OR USED FOR ANY PURPOSE OTHER THAN THAT FOR WHICH IT HAS BEEN LOANED.


GENERAL NOTES:
ALL DIMENSIONS INDICATED ARE IN MILLIMETER UNLESS MENTIONED OTHERWISE
ALL DIMENSIONS ARE TO BE CROSS CHECKED AT SITE AND ANY DISCREPANCY SHALL BE BROUGHT TO NOTICE BEFORE EXECUTION.
ALL SERVICE DRAWINGS SHALL BE READ IN CONJUNCTION WITH THIS DRAWING AND OTHER DETAILS.
ANY DISCREPANCIES IN DRAWING MUST BE REPORTED IMMEDIATELY TO PMCI/ARCHITECT FOR FINAL DECISION BEFORE EXECUTION.

S.NO	DATE	DRAWN	CHECKED	VERIFIED	REMARKS

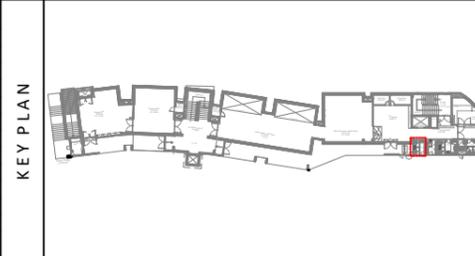


CLIENT		PROJECT	
J D Centre of Art		J D Centre of Art, Bhubaneshwar	
ARCHITECT		DRAWING	
VASTU SHILPA Consultants/ STUDIO VanRO		GROUND FLOOR PLAN OUT SIDE LADIES TOILET AS BUILT	
STRUCTURAL CONSULTANT		SCALE	COMPUTER FILE
Mahendra Raj Consultants Pvt. Ltd			
MUSEUM DESIGN		DRAWN BY	CHECKED BY
Siddhartha Das Studio		MAHESH PRAKASH	VIVEK NAMDEV
SANITARY, ELECTRICAL, HVAC, FIRE FIGHTING CONSULTANT		DATE	DRAWING TITLE
		17-04-2025	



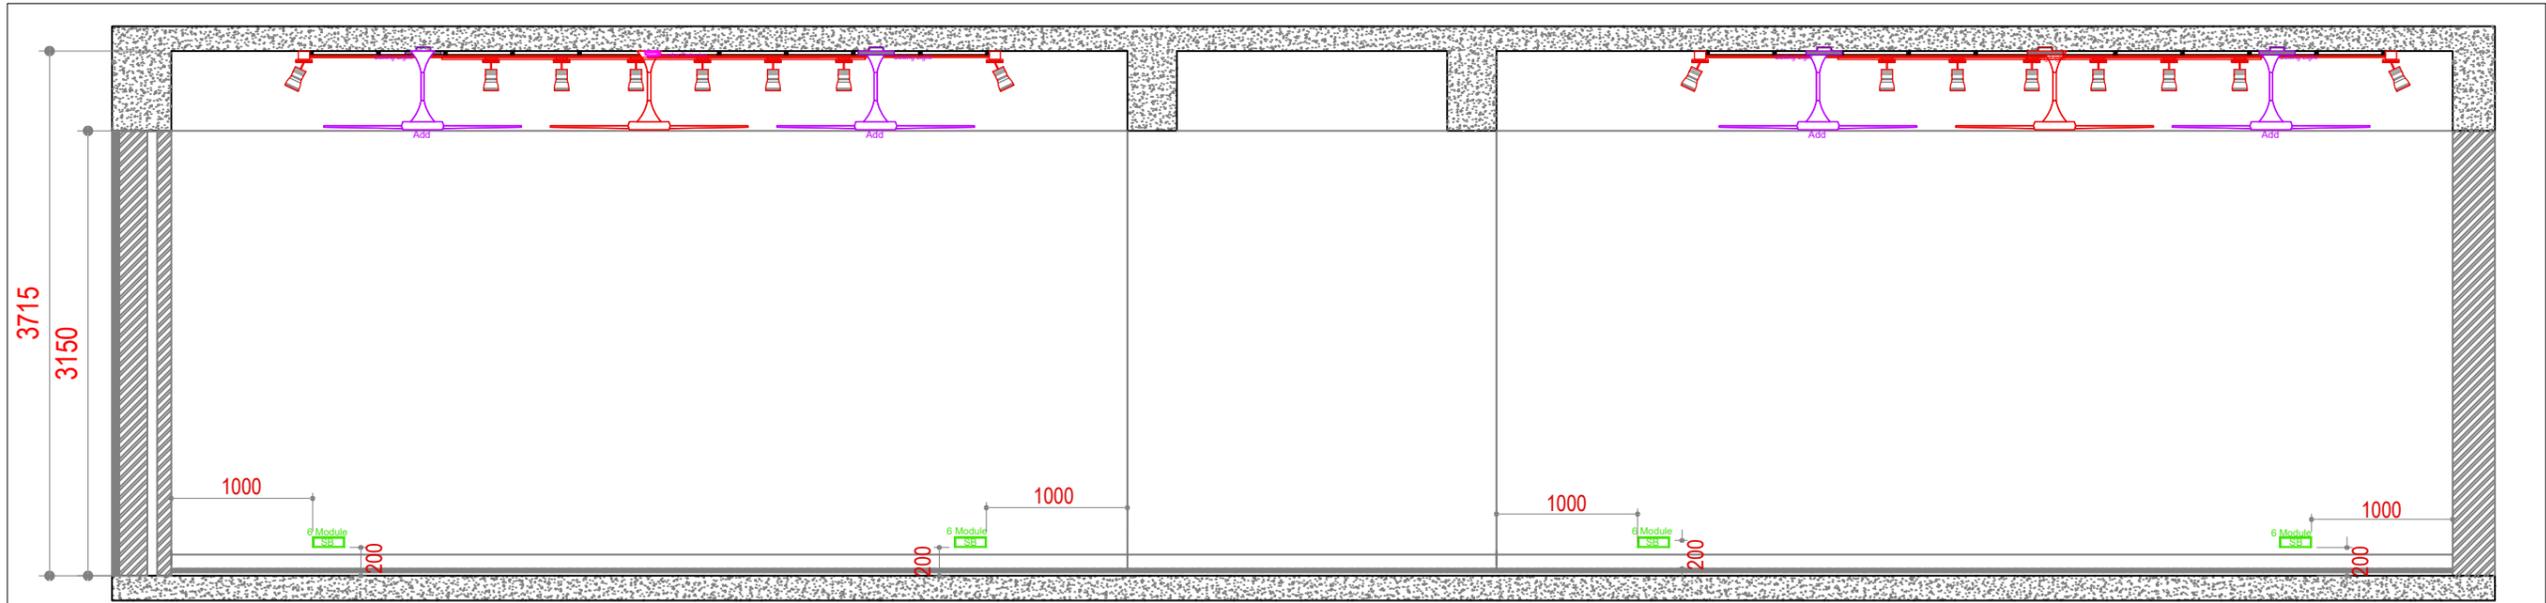

Sectional Elevation-A

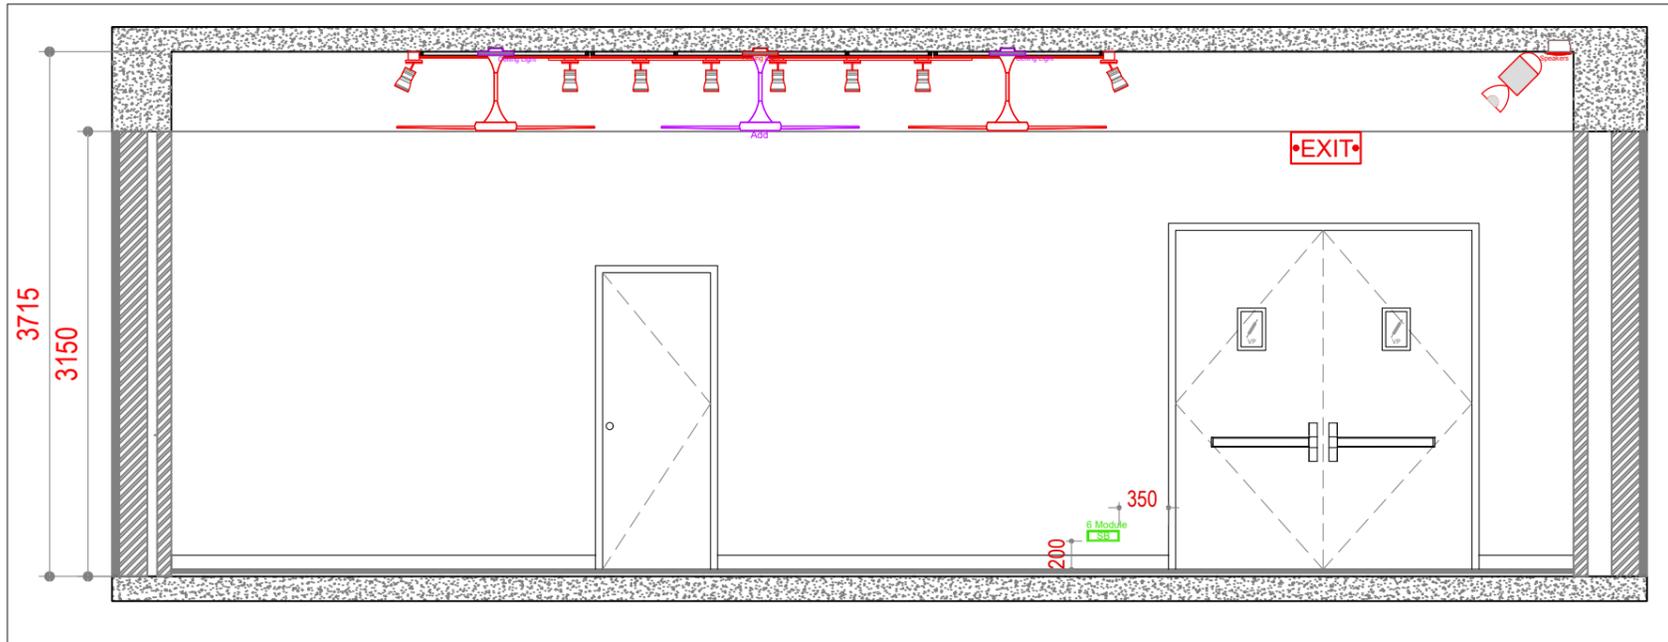


Sectional Elevation-B

NOTE:
 THIS DRAWING IS A COPYRIGHT. IT IS THE PROPERTY OF STUDIO VANRO AND IS NOT TO BE REPRODUCED, COPIED, HANDED OVER TO A THIRD PARTY OR USED FOR ANY PURPOSE OTHER THAN THAT FOR WHICH IT HAS BEEN LOANED.

GENERAL NOTES:
 ALL DIMENSIONS INDICATED ARE IN MILLIMETER UNLESS MENTIONED OTHERWISE
 ALL DIMENSIONS ARE TO BE CROSS CHECKED AT SITE AND ANY DISCREPANCY SHALL BE BROUGHT TO NOTICE BEFORE EXECUTION.
 ALL SERVICE DRAWINGS SHALL BE READ IN CONJUNCTION WITH THIS DRAWING AND OTHER DETAILS.
 ANY DISCREPANCIES IN DRAWING MUST BE REPORTED IMMEDIATELY TO PMCI/ARCHITECT FOR FINAL DECISION BEFORE EXECUTION.


S.NO	DATE	DRAWN	CHECKED	VERIFIED	REMARKS

S.NO	DATE	DRAWN	CHECKED	VERIFIED	REMARKS

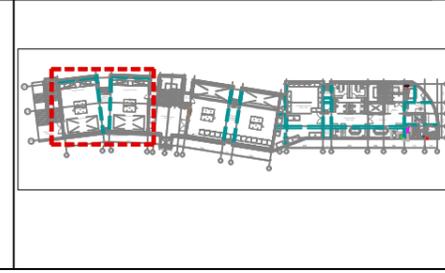

CLIENT	J D Centre of Art	PROJECT	J D Centre of Art, Bhubaneswar
ARCHITECT	VASTU SHILPA Consultants/ STUDIO VanRO	DRAWING	FIRST FLOOR PLAN CONTEMPORARY ART GALLERY-1 SECTIONAL ELEVATION
STRUCTURAL CONSULTANT	Mahendra Raj Consultants Pvt. Ltd	SCALE	A3@1:50
MUSEUM DESIGN	Siddhartha Das Studio	DRAWN BY	MAHESH PRAKASH
SANITARY, ELECTRICAL, HVAC, FIRE FIGHTING CONSULTANT		CHECKED BY	VIVEK NAMDEV
		DATE	24-07-2025
		DRAWING TITLE	

COMPUTER FILE	

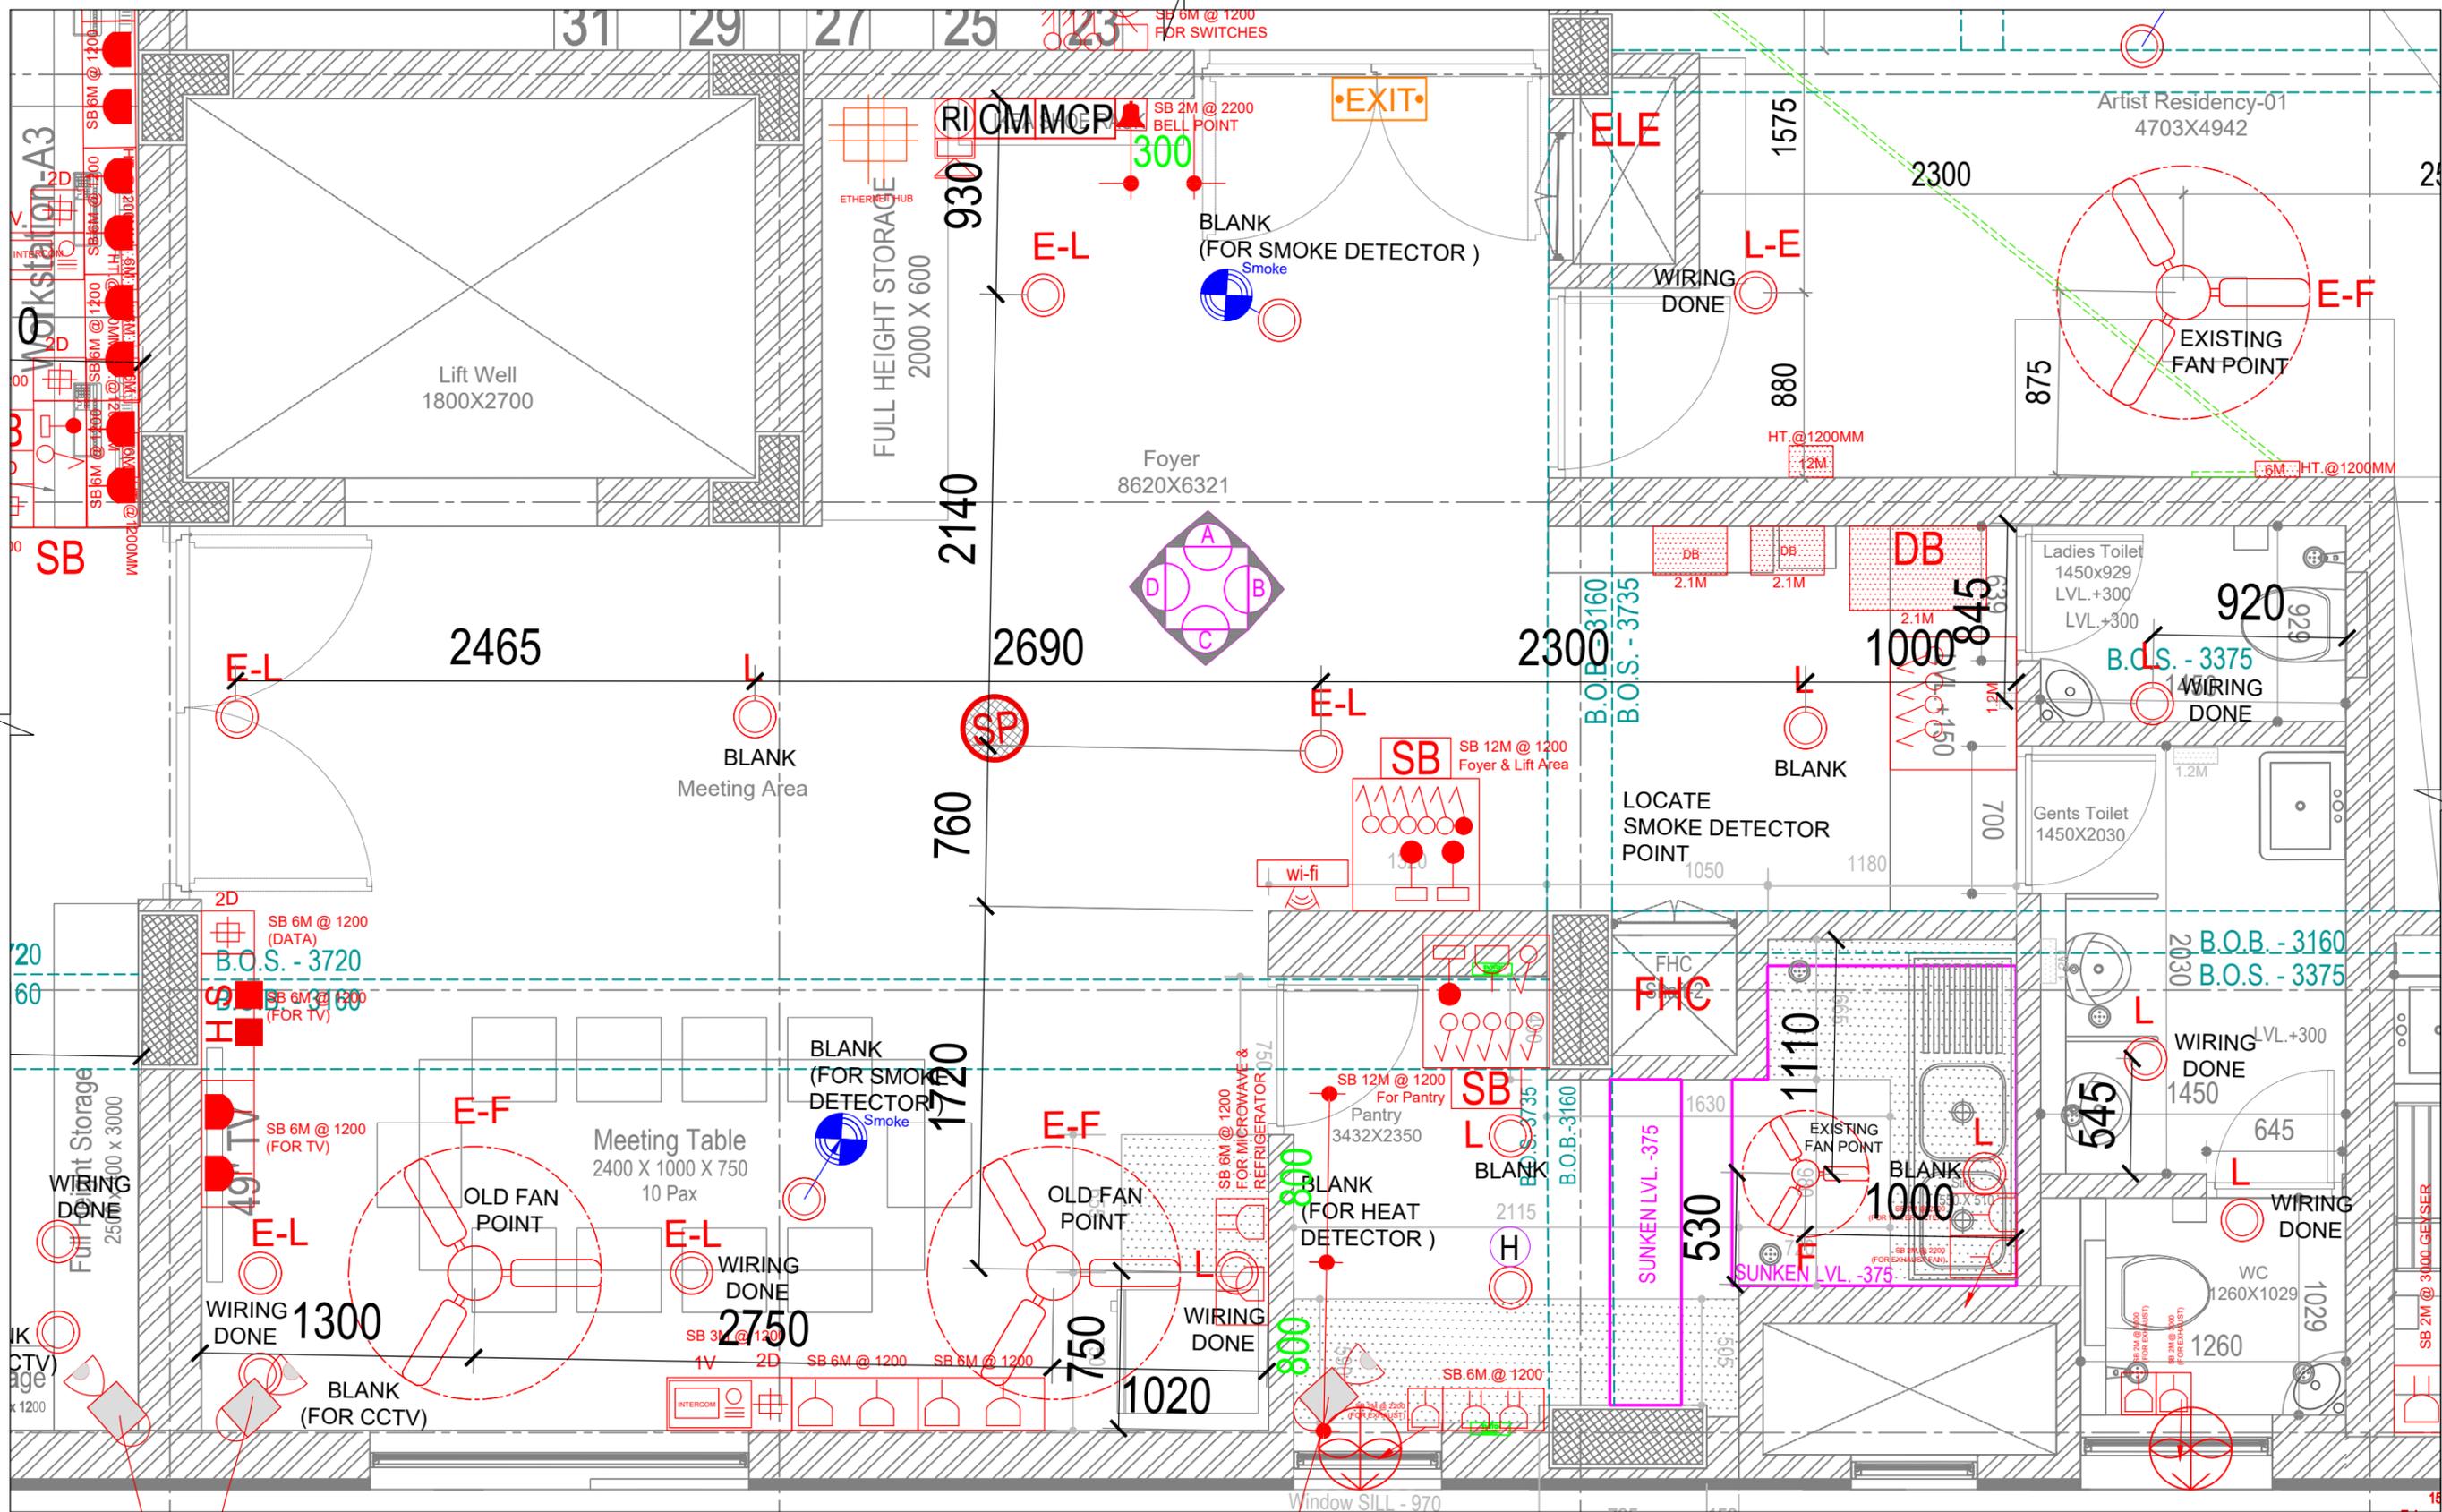


Foyer Area Block-2 Part Plan

NOTE:
 THIS DRAWING IS A COPYRIGHT. IT IS THE PROPERTY OF STUDIO VANRO AND IS NOT TO BE REPRODUCED, COPIED, HANDED OVER TO A THIRD PARTY OR USED FOR ANY PURPOSE OTHER THAN THAT FOR WHICH IT HAS BEEN LOANED.


GENERAL NOTES:
 ALL DIMENSIONS INDICATED ARE IN MILLIMETER UNLESS MENTIONED OTHERWISE
 ALL DIMENSIONS ARE TO BE CROSS CHECKED AT SITE AND ANY DISCREPANCY SHALL BE BROUGHT TO NOTICE BEFORE EXECUTION.
 ALL SERVICE DRAWINGS SHALL BE READ IN CONJUNCTION WITH THIS DRAWING AND OTHER DETAILS.
 ANY DISCREPANCIES IN DRAWING MUST BE REPORTED IMMEDIATELY TO PM/ARCHITECT FOR FINAL DECISION BEFORE EXECUTION.


S.NO	DATE	DRAWN	CHECKED	VERIFIED	REMARKS

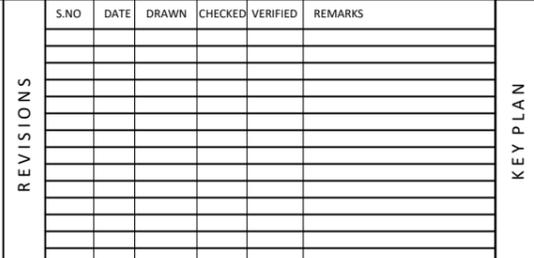


CLIENT	J D Centre of Art
ARCHITECT	VASTU SHILPA Consultants/ STUDIO VanRO
STRUCTURAL CONSULTANT	Mahendra Raj Consultants Pvt. Ltd
MUSEUM DESIGN	Siddhartha Das Studio
SANITARY, ELECTRICAL, HVAC, FIRE FIGHTING CONSULTANT	

PROJECT	J D Centre of Art, Bhubaneswar
DRAWING	FIRST FLOOR PLAN FOYER AREA BLOCK-2 PART PLAN
SCALE	COMPUTER FILE
DRAWN BY	MAHESH PRAKASH
CHECKED BY	VIVEK NAMDEV
DATE	13-11-2024
DRAWING TITLE	

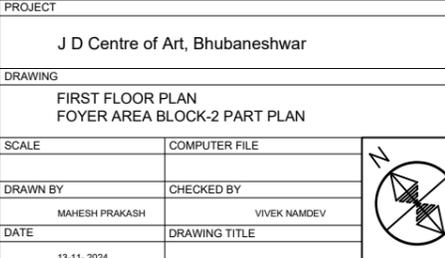


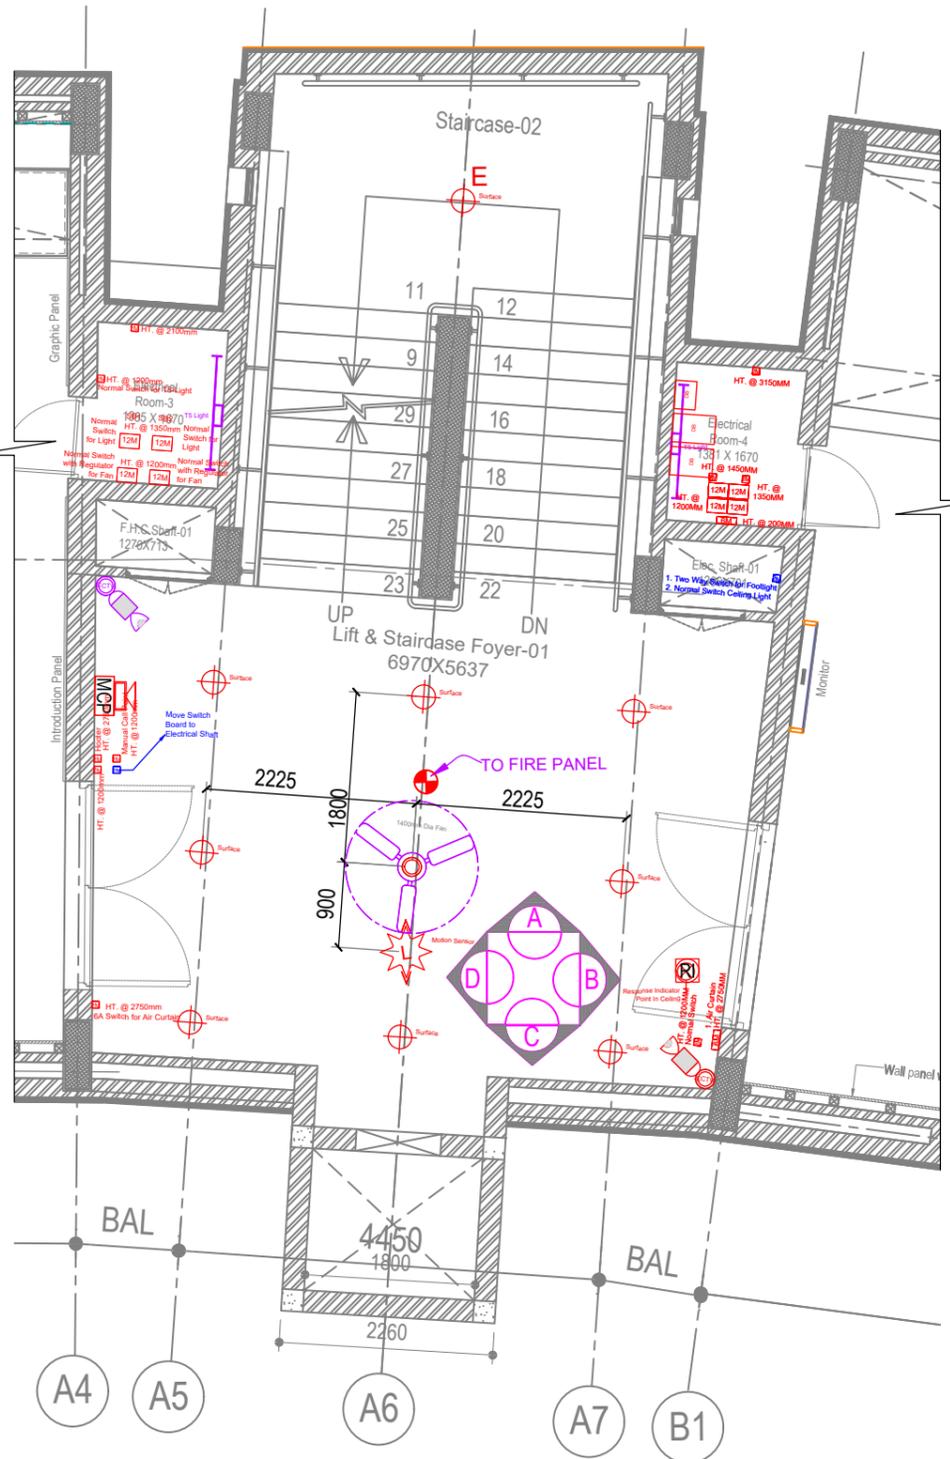


Foyer Block-1 Part Plan

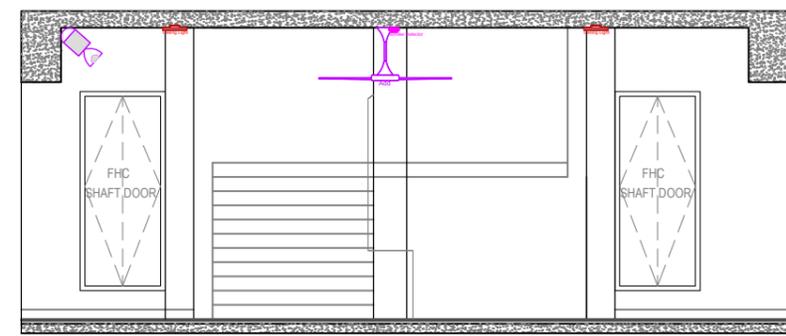


Sectional Elevation-A

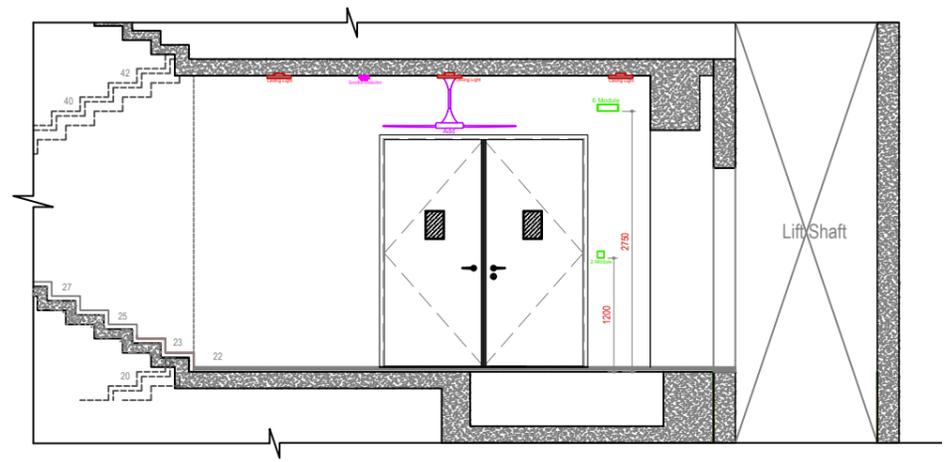

Sectional Elevation-B

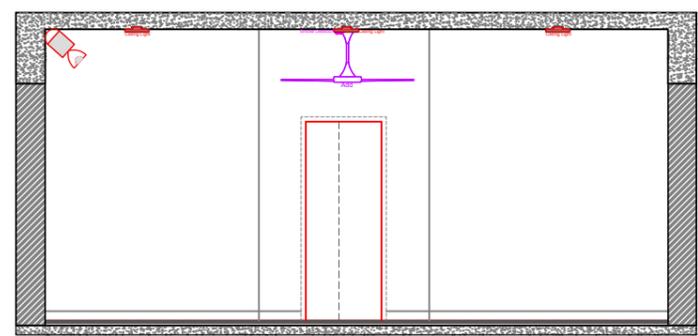

Sectional Elevation-C

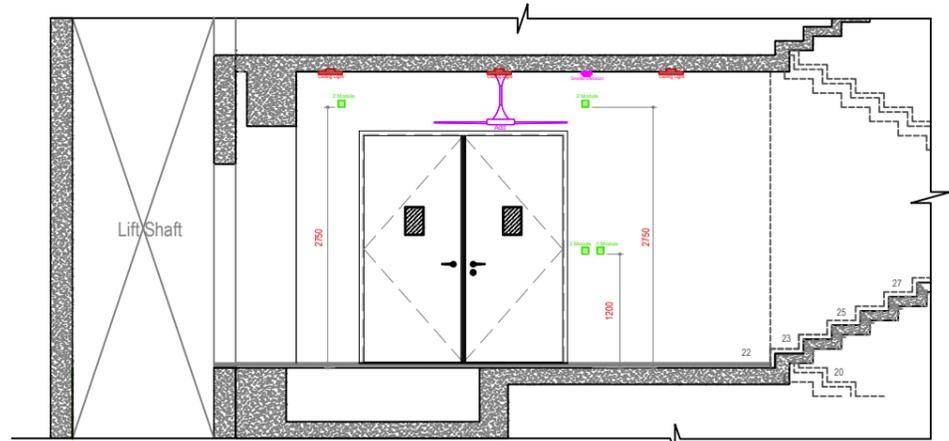


Sectional Elevation-D

NOTE:
THIS DRAWING IS A COPYRIGHT. IT IS THE PROPERTY OF STUDIO VANRO AND IS NOT TO BE REPRODUCED, COPIED, HANDED OVER TO A THIRD PARTY OR USED FOR ANY PURPOSE OTHER THAN THAT FOR WHICH IT HAS BEEN LOANED.

GENERAL NOTES:
ALL DIMENSIONS INDICATED ARE IN MILLIMETER UNLESS MENTIONED OTHERWISE
ALL DIMENSIONS ARE TO BE CROSS CHECKED AT SITE AND ANY DISCREPANCY SHALL BE BROUGHT TO NOTICE BEFORE EXECUTION.
ALL SERVICE DRAWINGS SHALL BE READ IN CONJUNCTION WITH THIS DRAWING AND OTHER DETAILS.
ANY DISCREPANCIES IN DRAWING MUST BE REPORTED IMMEDIATELY TO PMC/ARCHITECT FOR FINAL DECISION BEFORE EXECUTION.


S.NO	DATE	DRAWN	CHECKED	VERIFIED	REMARKS

S.NO	DATE	DRAWN	CHECKED	VERIFIED	REMARKS

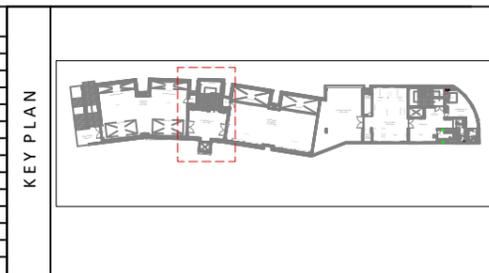


CLIENT	J D Centre of Art	PROJECT	J D Centre of Art, Bhubaneswar
ARCHITECT	VASTU SHILPA Consultants/ STUDIO VanRO	DRAWING	FIRST FLOOR PLAN FOYER BLOCK-1 PART PLAN & SECTIONAL ELEVATION
STRUCTURAL CONSULTANT	Mahendra Raj Consultants Pvt. Ltd	SCALE	COMPUTER FILE
MUSEUM DESIGN	Siddhartha Das Studio	DRAWN BY	CHECKED BY
SANITARY, ELECTRICAL, HVAC, FIRE FIGHTING CONSULTANT		DATE	13-11-2024


MAHESH PRAKASH	VIVEK NAMDEV
DRAWING TITLE	

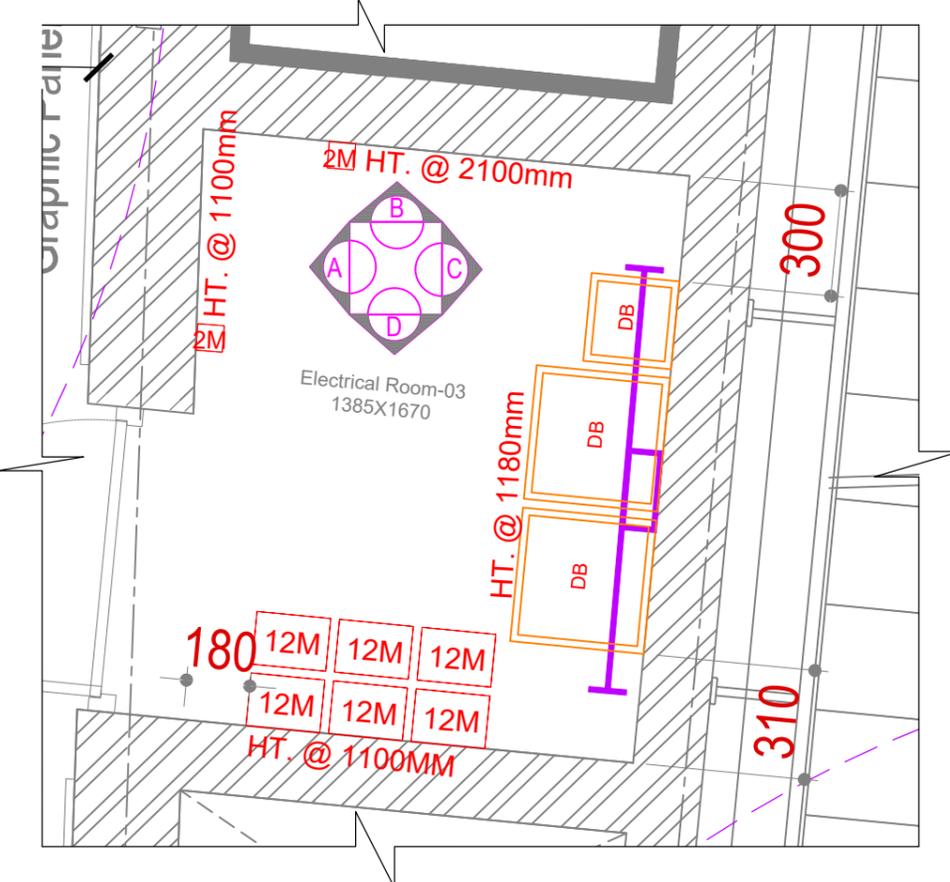


Electrical Room-03 Prt Plan
Scale-1:20

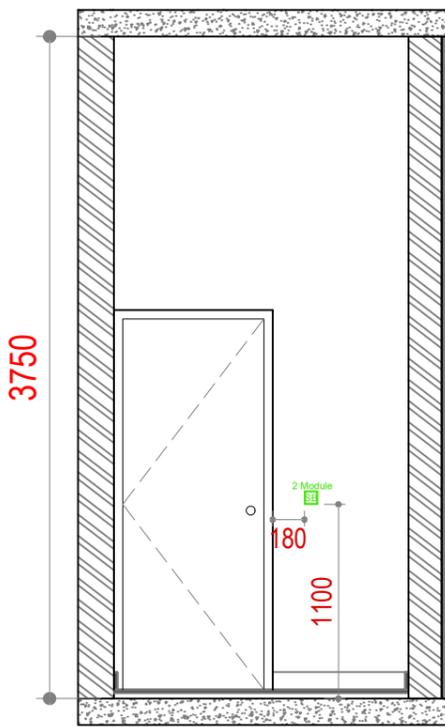


Sectional Elevation-A
Scale-1:40

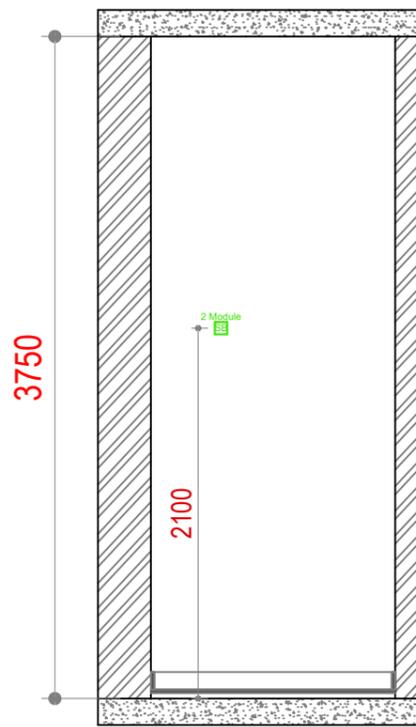


Sectional Elevation-B
Scale-1:40

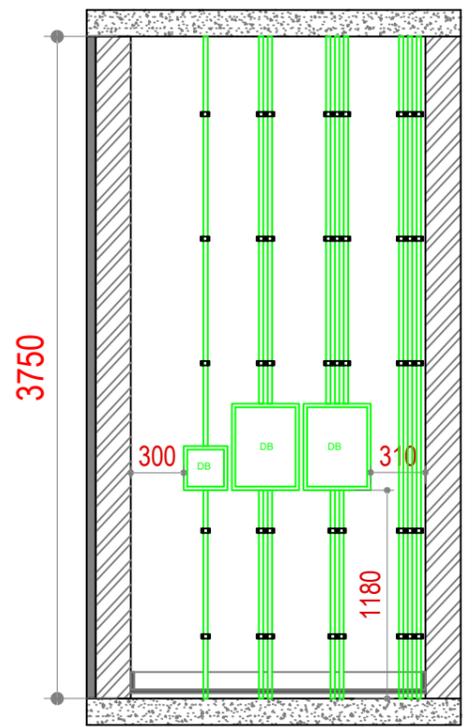

Sectional Elevation-C
Scale-1:40

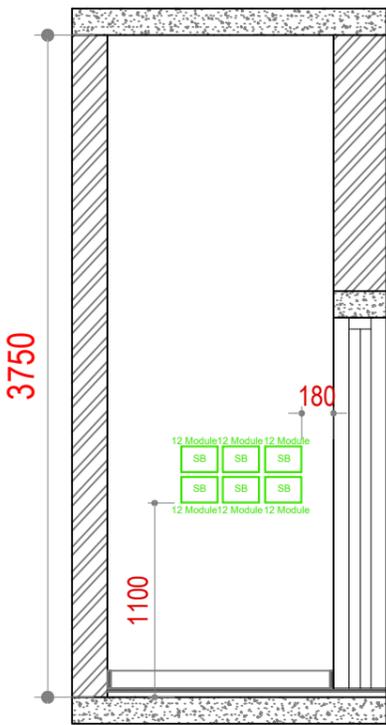

Sectional Elevation-D
Scale-1:40

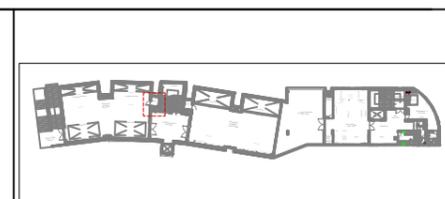



NOTE:
THIS DRAWING IS A COPYRIGHT. IT IS THE PROPERTY OF STUDIO VANRO AND IS NOT TO BE REPRODUCED, COPIED, HANDED OVER TO A THIRD PARTY OR USED FOR ANY PURPOSE OTHER THAN THAT FOR WHICH IT HAS BEEN LOANED.

GENERAL NOTES:
ALL DIMENSIONS INDICATED ARE IN MILLIMETER UNLESS MENTIONED OTHERWISE
ALL DIMENSIONS ARE TO BE CROSS CHECKED AT SITE AND ANY DISCREPANCY SHALL BE BROUGHT TO NOTICE BEFORE EXECUTION.
ALL SERVICE DRAWINGS SHALL BE READ IN CONJUNCTION WITH THIS DRAWING AND OTHER DETAILS.
ANY DISCREPANCIES IN DRAWING MUST BE REPORTED IMMEDIATELY TO PMCI/ARCHITECT FOR FINAL DECISION BEFORE EXECUTION.

S.NO	DATE	DRAWN	CHECKED	VERIFIED	REMARKS

CLIENT	PROJECT
J D Centre of Art	J D Centre of Art, Bhubaneswar
ARCHITECT	DRAWING
VASTU SHILPA Consultants/ STUDIO VanRO	FIRST FLOOR PLAN ELECTRICAL ROOM-3 PLAN & SECTIONAL ELEVATION
STRUCTURAL CONSULTANT	SCALE
Mahendra Raj Consultants Pvt. Ltd	COMPUTER FILE
MUSEUM DESIGN	DRAWN BY
Siddhartha Das Studio	MAHESH PRAKASH
SANITARY, ELECTRICAL, HVAC, FIRE FIGHTING CONSULTANT	CHECKED BY
	VIVEK NAMDEV
DATE	DRAWING TITLE
13-11-2024	

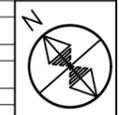

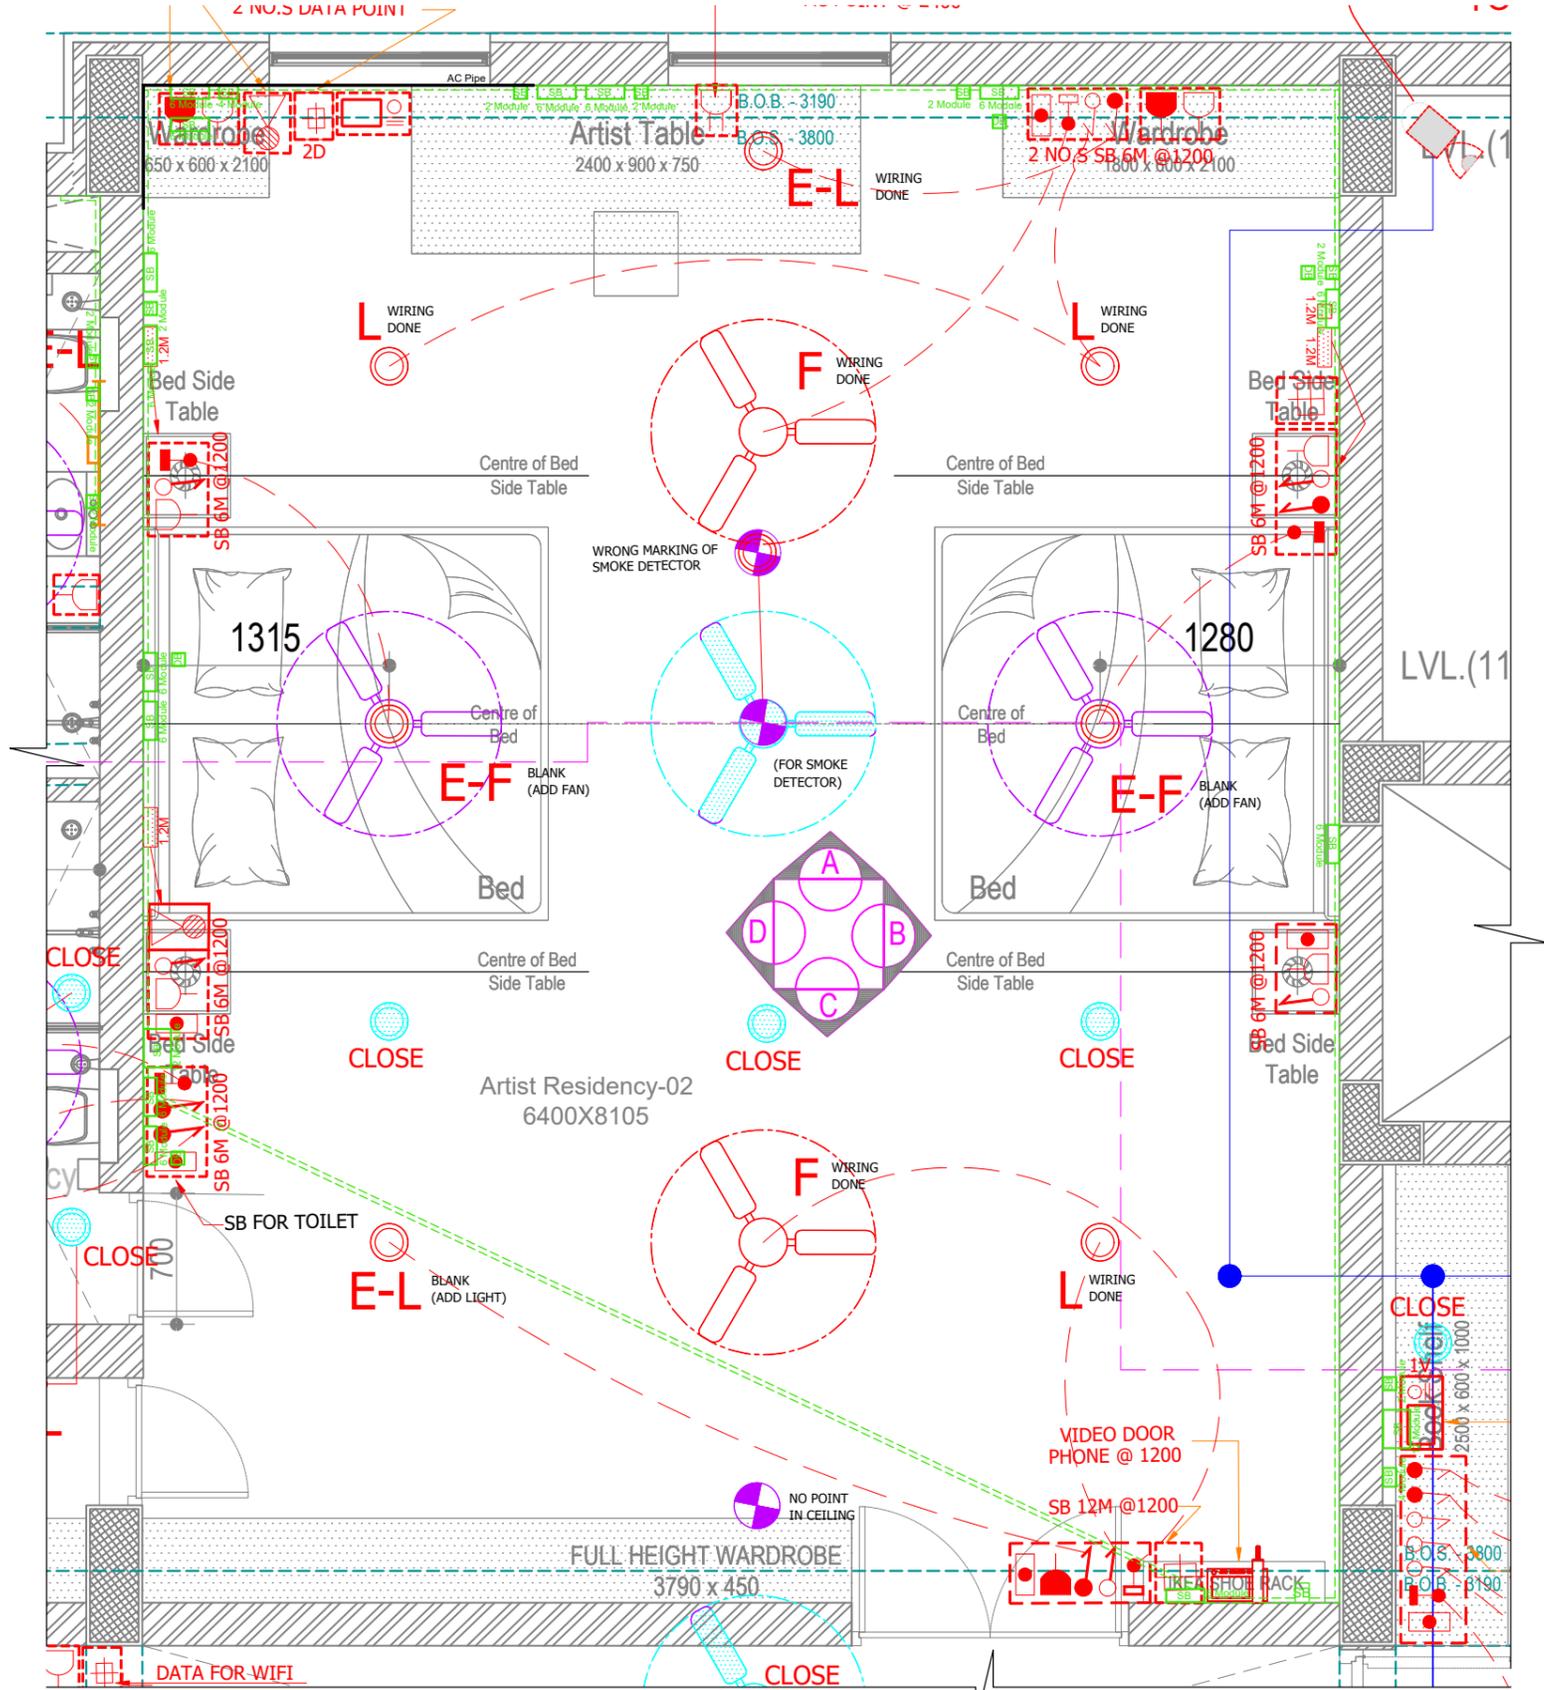


Artist Residency-02 Part Plan


NOTE:
 THIS DRAWING IS A COPYRIGHT. IT IS THE PROPERTY OF STUDIO VANRO AND IS NOT TO BE REPRODUCED, COPIED, HANDED OVER TO A THIRD PARTY OR USED FOR ANY PURPOSE OTHER THAN THAT FOR WHICH IT HAS BEEN LOANED.


GENERAL NOTES:
 ALL DIMENSIONS INDICATED ARE IN MILLIMETER UNLESS MENTIONED OTHERWISE
 ALL DIMENSIONS ARE TO BE CROSS CHECKED AT SITE AND ANY DISCREPANCY SHALL BE BROUGHT TO NOTICE BEFORE EXECUTION.
 ALL SERVICE DRAWINGS SHALL BE READ IN CONJUNCTION WITH THIS DRAWING AND OTHER DETAILS.
 ANY DISCREPANCIES IN DRAWING MUST BE REPORTED IMMEDIATELY TO PMCI/ARCHITECT FOR FINAL DECISION BEFORE EXECUTION.

S.NO	DATE	DRAWN	CHECKED	VERIFIED	REMARKS

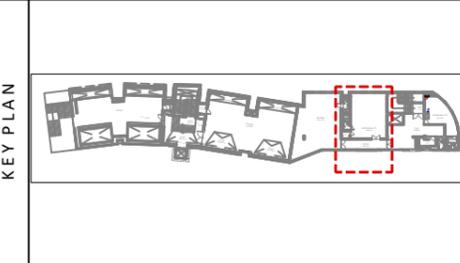

CLIENT		PROJECT	
J D Centre of Art		J D Centre of Art, Bhubaneswar	
ARCHITECT		DRAWING	
VASTU SHILPA Consultants/ STUDIO VanRO		SECOND FLOOR PLAN ARTIST RESIDENCY-02 PART PLAN	
STRUCTURAL CONSULTANT		SCALE	COMPUTER FILE
Mahendra Raj Consultants Pvt. Ltd			
MUSEUM DESIGN		DRAWN BY	CHECKED BY
Siddhartha Das Studio		MAHESH PRAKASH	VIVEK NAMDEV
SANITARY, ELECTRICAL, HVAC, FIRE FIGHTING CONSULTANT		DATE	DRAWING TITLE
		06-11-2024	

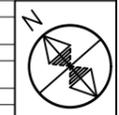

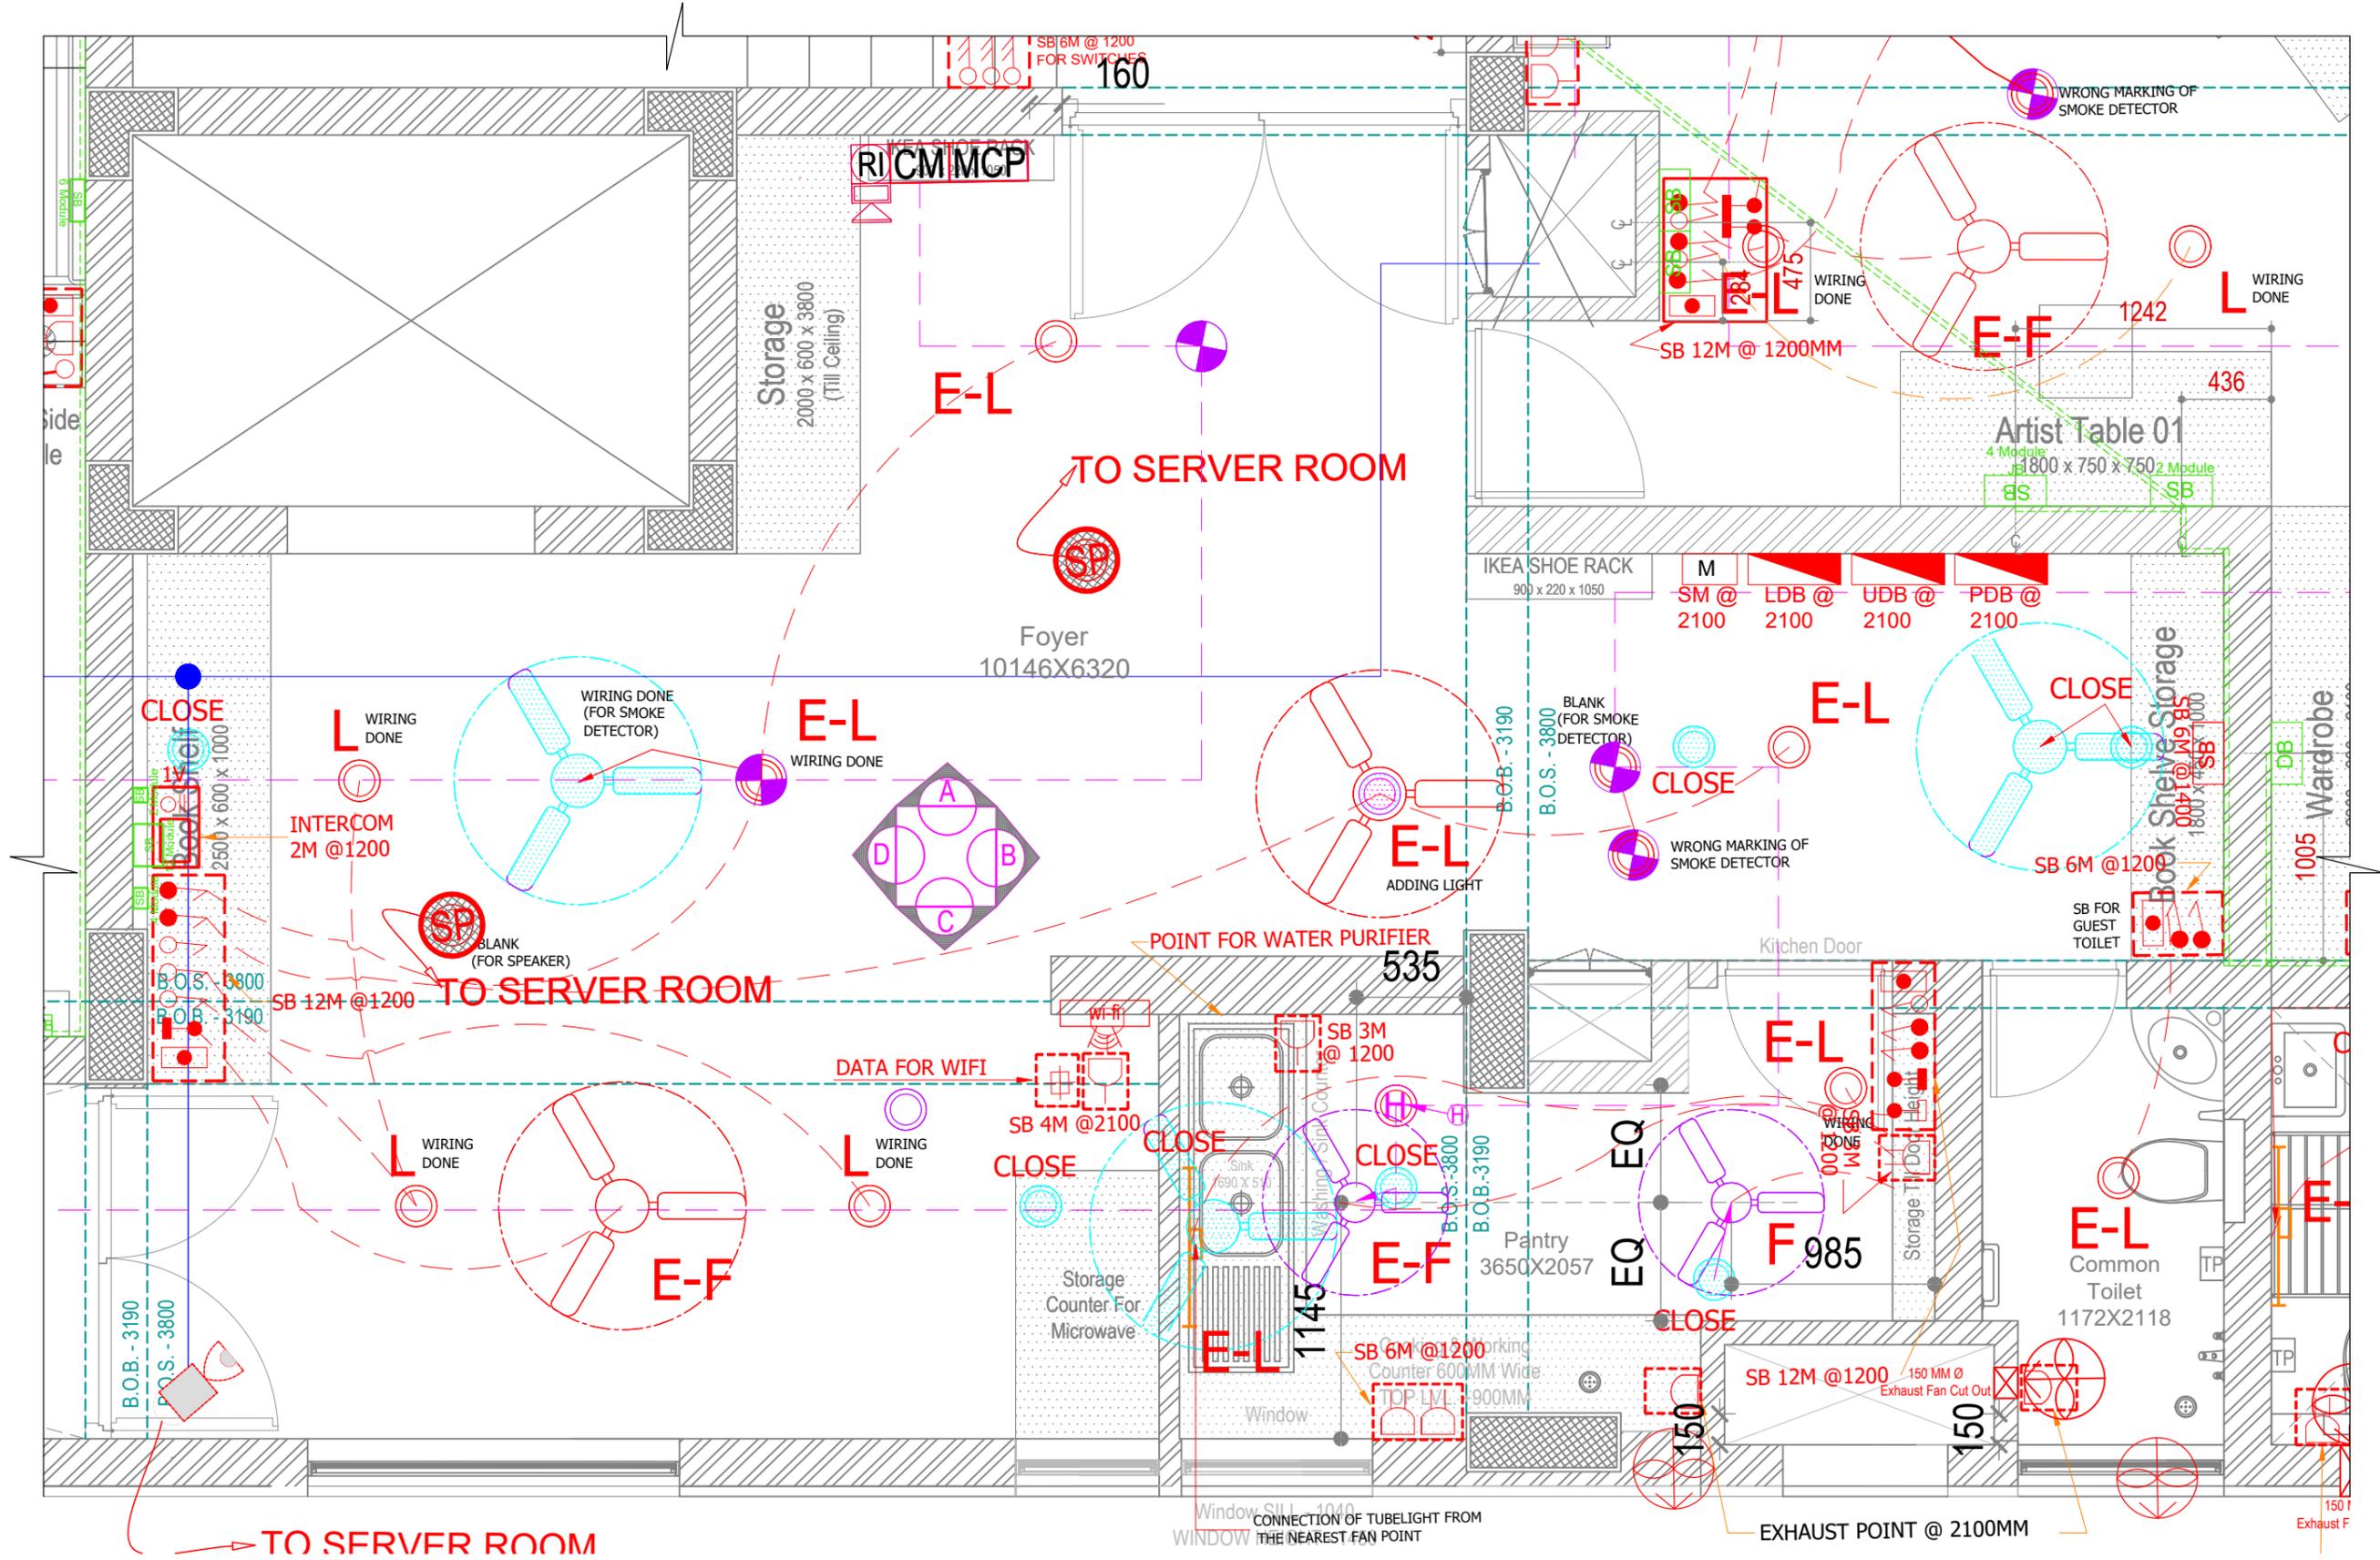


Foyer Block-2 Part Plan

NOTE:
 THIS DRAWING IS A COPYRIGHT. IT IS THE PROPERTY OF STUDIO VANRO AND IS NOT TO BE REPRODUCED, COPIED, HANDED OVER TO A THIRD PARTY OR USED FOR ANY PURPOSE OTHER THAN THAT FOR WHICH IT HAS BEEN LOANED.


GENERAL NOTES:
 ALL DIMENSIONS INDICATED ARE IN MILLIMETER UNLESS MENTIONED OTHERWISE
 ALL DIMENSIONS ARE TO BE CROSS CHECKED AT SITE AND ANY DISCREPANCY SHALL BE BROUGHT TO NOTICE BEFORE EXECUTION.
 ALL SERVICE DRAWINGS SHALL BE READ IN CONJUNCTION WITH THIS DRAWING AND OTHER DETAILS.
 ANY DISCREPANCIES IN DRAWING MUST BE REPORTED IMMEDIATELY TO PM/ARCHITECT FOR FINAL DECISION BEFORE EXECUTION.


S.NO	DATE	DRAWN	CHECKED	VERIFIED	REMARKS

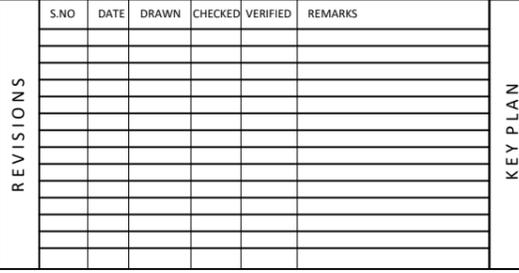

CLIENT	J D Centre of Art
ARCHITECT	VASTU SHILPA Consultants/ STUDIO VanRO
STRUCTURAL CONSULTANT	Mahendra Raj Consultants Pvt. Ltd
MUSEUM DESIGN	Siddhartha Das Studio
SANITARY, ELECTRICAL, HVAC, FIRE FIGHTING CONSULTANT	

PROJECT	J D Centre of Art, Bhubaneswar
DRAWING	SECOND FLOOR PLAN FOYER BLOCK-2 PART PLAN
SCALE	COMPUTER FILE
DRAWN BY	MAHESH PRAKASH
CHECKED BY	VIVEK NAMDEV
DATE	07-11-2024
DRAWING TITLE	

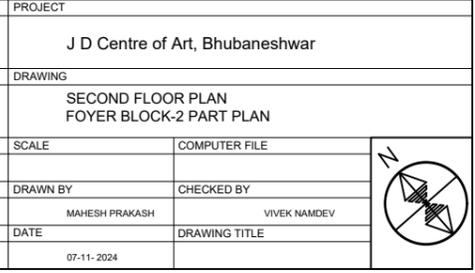

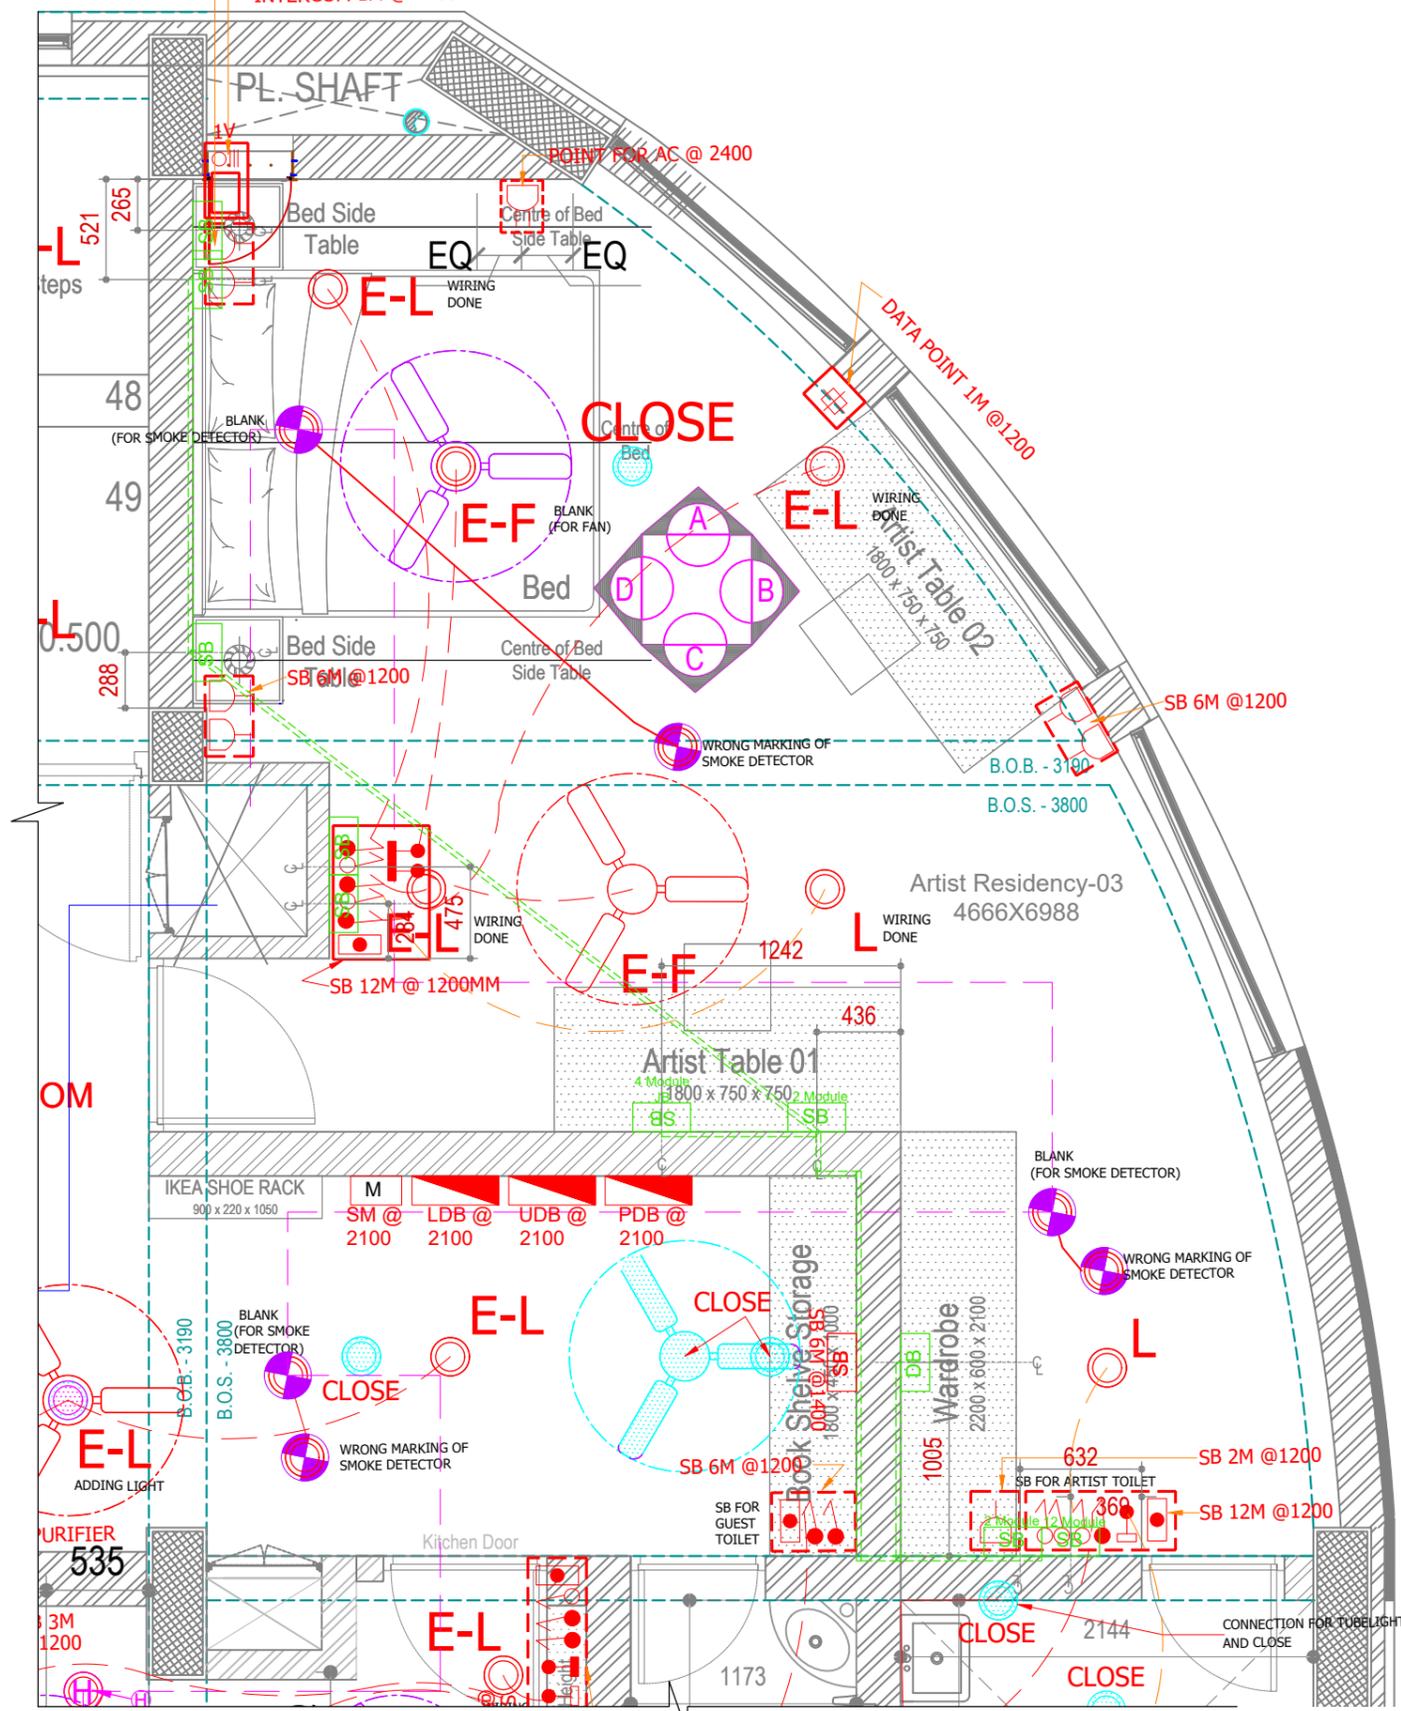

Artist Residency 03 Part Plan

NOTE:
 THIS DRAWING IS A COPYRIGHT. IT IS THE PROPERTY OF STUDIO VANRO AND IS NOT TO BE REPRODUCED, COPIED, HANDED OVER TO A THIRD PARTY OR USED FOR ANY PURPOSE OTHER THAN THAT FOR WHICH IT HAS BEEN LOANED.

GENERAL NOTES:
 ALL DIMENSIONS INDICATED ARE IN MILLIMETER UNLESS MENTIONED OTHERWISE
 ALL DIMENSIONS ARE TO BE CROSS CHECKED AT SITE AND ANY DISCREPANCY SHALL BE BROUGHT TO NOTICE BEFORE EXECUTION.
 ALL SERVICE DRAWINGS SHALL BE READ IN CONJUNCTION WITH THIS DRAWING AND OTHER DETAILS.
 ANY DISCREPANCIES IN DRAWING MUST BE REPORTED IMMEDIATELY TO PMCI/ARCHITECT FOR FINAL DECISION BEFORE EXECUTION.

S.NO	DATE	DRAWN	CHECKED	VERIFIED	REMARKS



CLIENT	J D Centre of Art
ARCHITECT	VASTU SHILPA Consultants/ STUDIO VanRO
STRUCTURAL CONSULTANT	Mahendra Raj Consultants Pvt. Ltd
MUSEUM DESIGN	Siddhartha Das Studio
SANITARY, ELECTRICAL, HVAC, FIRE FIGHTING CONSULTANT	

PROJECT	J D Centre of Art, Bhubaneswar
DRAWING	SECOND FLOOR PLAN ARTIST RESIDENCY 03- PLAN
SCALE	COMPUTER FILE
DRAWN BY	CHECKED BY
DATE	DRAWING TITLE

MAHESH PRAKASH	VIVEK NAMDEV
06-11-2024	

